




GEOSTRAP™

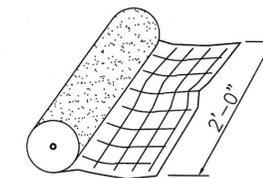


SOIL RETENTION FABRIC
CARTHAGE MILLS 15% WOVEN
FILTER CLOTH OR EQUAL

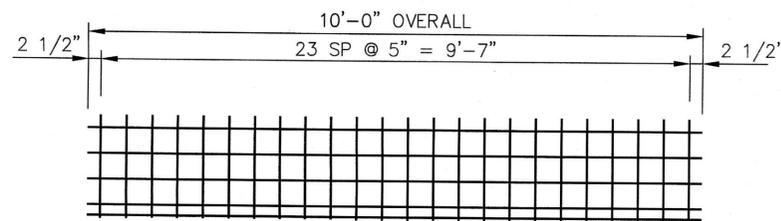

ELEVATION - TYPE "L"
5" x 5" - W5 x W5 WIRE MESH

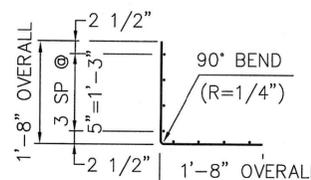

SECTION

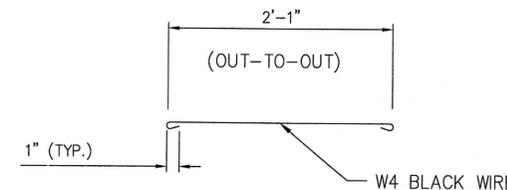

W4 WIRE STRUT

Kimley-Horn and Associates, Inc.

NO EXCEPTIONS TAKEN
 CORRECTIONS NOTED
 REJECTED
 VERIFY & MAKE CORRECTIONS
 RESUBMIT

Our limited review is only for compliance with the design concept and information given in the Contract Documents. Contractor is solely responsible for dimension, quantities, performance, safety, coordination with other work, and all other requirements of the Contract Documents. Review does not authorize changes to contract unless stated specifically in separate letter or change order.

Reviewed By: *[Signature]* Date: 11/14/13


NOTES FOR WIRE FACINGS

- 1) WIRE FACINGS SHALL BE SHOP FABRICATED OF COLD DRAWN STEEL WIRE CONFORMING TO THE MINIMUM REQUIREMENTS OF ASTM A-82 (AASHTO M 32) AND WELDED INTO THE FINISHED CONFIGURATION IN ACCORDANCE WITH ASTM A-185 (AASHTO M55).
- 2) DIMENSIONAL TOLERANCE = ±1/4".
- 3) DESIGN LENGTH = 9'-10"


DATE: 12-16-13
 Approved in general. Details not checked. This approval shall not relieve the Contractor of any responsibility for conformity with the contract Plans and Specifications.
 Georgia DOT
 Office of Bridge Design
 By: *[Signature]*

This drawing contains information proprietary to The Reinforced Earth Company, and is being furnished for the use of THE GEORGIA DEPT. OF TRANSPORTATION only in connection with this project, and the information contained is not to be transmitted to any other organization unless specifically authorized in writing by The Reinforced Earth Company. The Reinforced Earth Company is exclusive licensee in the United States under patents issued to Henri Vidal, and the furnishing of this drawing does not constitute an expressed or implied license under the Vidal patents.

FINAL FOR REVIEW
OCTOBER 14, 2013

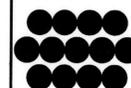

REINFORCED EARTH®
SUSTAINABLE TECHNOLOGY
25 Technology Parkway South, Suite 100, Norcross, GA 30092, (770) 242-9415

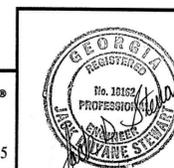

WALL SHEET
OF

GEORGIA DEPARTMENT OF TRANSPORTATION HIGHWAY DIVISION - BRIDGE DESIGN	
I-75 @ SR3/US 41/76 INTERCHANGE RECONSTRUCTION WHITFIELD COUNTY	
REINFORCED EARTH RETAINING WALL	
GEOTREL COMPONENTS	
DESIGNED <i>SCM</i>	TRACED
DRAWN <i>SCM</i>	CHECKED <i>CCJ</i>
REVIEWED	APPROVED <i>DS</i>