


AS-BUILT PLANS 12/12/12

DATE	SHEET NO.	REVISION
01-26-11	1	ADDED REVISION DATE TO COVER
01-26-11	4	ADDED REVISIONS TO REVISION SUMMARY SHEET
01-26-11	426	REVISED BOTTOM OF WALL ELEVATIONS
03-29-11	1	ADDED REVISION DATE TO COVER.
03-29-11	4	ADDED REVISIONS TO REVISION SUMMARY SHEET.
03-29-11	44	REVISED ORIENTATION OF EXISTING 15" PIPE ORIGINATING AT STA. 660+00. ADDED STRUCTURE B-7.1 AS EXISTING JUNCTION BOX. ADDED PIPE CONNECTION FROM EXISTING STRUCTURE B-7.1 TO REVISED STRUCTURE B-7. STRUCTURE B-7 WAS REVISED TO OUTFALL UNDER PROPOSED RETAINING WALL. DELETED STRUCTURE B-3 AND CORRESPONDING PIPE EXTENSION. REVISED RIP RAP AT STRUCTURE B-0. ADDED NOTE FOR EXISTING SLOPE DRAIN TO BE REMOVED PAST STRUCTURE B-7.1.
03-29-11	45	REVISED ORIENTATION OF EXISTING 15" PIPE ORIGINATING AT STA. 660+00. ADDED STRUCTURE B-7.1 AS EXISTING JUNCTION BOX. ADDED PIPE CONNECTION FROM EXISTING STRUCTURE B-7.1 TO REVISED STRUCTURE B-7. STRUCTURE B-7 WAS REVISED TO OUTFALL UNDER PROPOSED RETAINING WALL. DELETED STRUCTURE B-3 AND CORRESPONDING PIPE EXTENSION. REVISED RIP RAP AT STRUCTURE B-0. ADDED NOTE FOR EXISTING SLOPE DRAIN TO BE REMOVED PAST STRUCTURE B-7.1.
		REVISED LOCATION OF STRUCTURE B-6 AND PIPE CONNECTION FROM STRUCTURE B-7. ADDED RIP RAP AT STRUCTURE B-6.
03-29-11	61	ADDED DRIVEWAY APRON STA. 102+13 RT.
03-29-11	69	ADDED DRIVEWAY STA. 217+75 RT.
03-29-11	100	ADDED DRIVEWAY STA. 217+75 RT.
03-29-11	186	ADDED STRUCTURE B-7.1 AS EXISTING JUNCTION BOX. ADDED PIPE CONNECTION FROM EXISTING STRUCTURE B-7.1 TO REVISED STRUCTURE B-7. STRUCTURE B-7 WAS REVISED TO OUTFALL UNDER PROPOSED RETAINING WALL. REVISED LOCATION OF STRUCTURE B-6 AND PIPE CONNECTION FROM STRUCTURE B-7. ADDED RIP RAP AT STRUCTURE B-6.
03-29-11	190	REVISED ORIENTATION OF EXISTING 15" PIPE ORIGINATING AT STA. 660+00. ADDED STRUCTURE B-7.1 AS EXISTING JUNCTION BOX. DELETED STRUCTURE B-3 AND CORRESPONDING PIPE EXTENSION. ADDED NOTE FOR EXISTING SLOPE DRAIN TO BE REMOVED PAST STRUCTURE B-7.1.
03-29-11	350	REVISED LOCATION OF UTILITY POLE 6.01 TO STA. 216+00
03-29-11	351	REVISED LOCATION OF UTILITY POLE 5.02 TO STA. 218+37
03-29-11	392	ADDED CROSS WALK FOR DRIVEWAY AT STA. 217+75.
03-29-11	416	REVISED WALL LIMITS AND CONSTRUCTION JOINT LOCATION.
03-29-11	417	REVISED WALL LIMITS AND CONSTRUCTION JOINT LOCATION.
04-22-11	1	ADDED REVISION DATE TO COVER.
04-22-11	4	ADDED REVISIONS TO REVISION SUMMARY SHEET.
04-22-11	549	ADDED REVISION DATE TO COVER.
04-22-11	554	REVISED TABLE FOR DISCHARGES INTO, OR WITHIN ONE LINEAR MILE UPSTREAM OF AND WITHIN THE SAME WATERSHED AS, ANY PORTION OF A BIOTA IMPAIRED STREAM SEGMENT. CHECKLIST ITEM "f" FROM PART III C 2 OF GAR 100002 WAS CHANGED TO ITEM "E".
05-31-11	1	ADDED REVISION DATE TO COVER.
05-31-11	4	ADDED REVISIONS TO REVISION SUMMARY SHEET.
05-31-11	57-58	REVISED 30" CROSS-DRAIN ORIENTATION; REVISED DITCH ELEVATIONS (LT) TO MEET NEW 30" CROSS-DRAIN INVERTS; REVISED DITCH ALIGNMENT (RT) TO INCORPORATE SLOPE BENCH FROM STA. 409+00 TO 413+00
05-31-11	187	REVISED DRAINAGE PROFILE FOR STRUCTURE C2 & C3.
05-31-11	263-268	REVISED CROSS-SECTIONS TO REFLECT NEW DITCH ELEVATIONS (LT) TO MEET NEW 30" CROSS-DRAIN INVERTS; REVISED DITCH ALIGNMENT (RT) TO INCORPORATE SLOPE BENCH FROM STA. 409+00 TO 413+00
09-28-11	1	ADDED REVISION DATE TO COVER
09-28-11	4	ADDED REVISIONS TO REVISION SUMMARY SHEET
09-28-11	438	REVISED END BENT DETAILS
09-28-11	442	REVISED END BENT REBAR

DATE	SHEET NO.	REVISION
09-26-12	1	ADDED REVISION DATE TO COVER
09-26-12	4	ADDED REVISIONS TO REVISION SUMMARY SHEET
09-26-12	45	ADDED DETAIL 1A TO STRUCTURE S-6
09-26-12	46	ADDED STRUCTURE S-7 AT STA. 715+10 LT
09-26-12	57-58	ADDED DETAIL 1A TO STRUCTURE S-11 AND S-12
09-26-12	549	ADDED REVISION DATE TO COVER
09-26-12	618, 634	ADDED BITUMINOUS TREATED ROVING TO DITCH FROM STA. 501+00 TO STA. 503+30 LT; REPLACED FABRIC CHECK DAM WITH ROCK FILTER DAM AT STA. 502+25 LT
12-07-12	1	ADDED REVISION DATE TO COVER
12-07-12	2	ADDED DETAILED ESTIMATE TO INDEX
12-07-12	4	ADDED REVISIONS TO REVISION SUMMARY SHEET
12-07-12	23A, 23B	ADDED DETAILED ESTIMATE
12-07-12	44, 45	ADDED TYPE 3 RIP RAP IN DITCH FROM STA. 709+25 TO 710+25 LT AND OUTFALL OF STRUCTURE B-0
12-07-12	549	ADDED REVISION DATE TO COVER
12-07-12	573, 575, 579	ADDED INLET SEDIMENT TRAP AT STA. 649+00, 656+00, 660+00, 680+00, 684+00, 607+00 LT.
	606	
12-07-12	578	ADDED TYPE C SILT FENCE FROM STA. 502+50 TO 503+50 RT
12-07-12	582	CHANGED RETROFITTING FROM TYPE P TO TYPE B
12-07-12	588	ADDED TYPE C SILT FENCE ALONG CONCRETE FLUME FROM STA. 406+00 TO 410+25 LT
12-07-12	591	MOVED ROCK FILTER DAM FROM STA. 696+00 TO 695+25 RT
12-07-12	596, 597	ADDED TYPE A SILT FENCE AT STA. 122+25 LT AND STA. 601+00 LT & RT
12-07-12	599, 600	ADDED TYPE C SILT FENCE FROM STA. 216+50 TO 218+25 RT, 219+00 TO 219+90 RT & LT, AND 220+10 TO 221+00 LT
12-07-12	604, 610	ADDED TEMPORARY PIPE SLOPE DRAIN AT STA. 599+75 LT AND 632+25 LT
12-07-12	615, 616	CHANGED RETROFITTING FROM TYPE P TO TYPE B; ADDED TYPE 3 RIP RAP IN DITCH FROM STA. 709+25 TO 710+25 LT AND AREA SURROUNDING DRAINAGE OUTFALL
12-07-12	627, 628	ADDED TYPE C SILT FENCE FROM STA. 404+25 LT TO 409+00 RT; MOVED INLET OF TEMPORARY 30" CROSS DRAIN TO STA. 409+00 LT; ADDED SILT CONTROL GATE AT STA. 409+00 LT; MOVED FABRIC CHECK DAM FROM STA. 409+00 TO 409+25 LT; ADDED BAFFLE BOX INLET SEDIMENT TRAP AT STA. 410+25 RT
12-07-12	637	REMOVED INLET SEDIMENT TRAP AT STA. 601+90
12-07-12	640	CHANGED RETROFITTING FROM TYPE P TO TYPE B; REMOVED TYPE C SILT FENCE ORIGINALLY PLACED DURING INITIAL PHASE

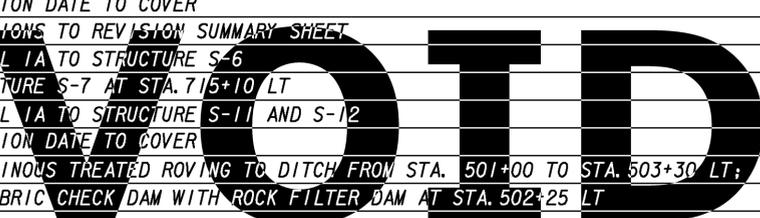

REVISION DATES	
01-26-11	12-07-12
03-29-11	
04-22-11	
05-31-11	
09-28-11	
09-26-12	

STATE OF GEORGIA
DEPARTMENT OF TRANSPORTATION
OFFICE: INNOVATIVE PROGRAM DELIVERY
REVISION SUMMARY