



AS-BUILT PLANS 12/12/12

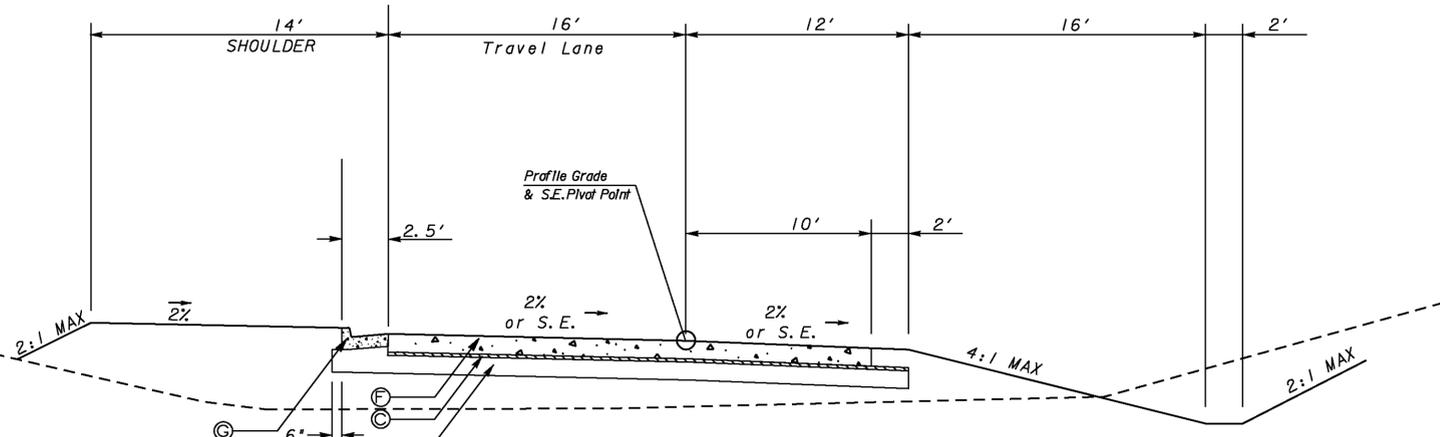


TYPICAL SECTION #20
RAMP "B"
SEE PLANS FOR LOCATIONS

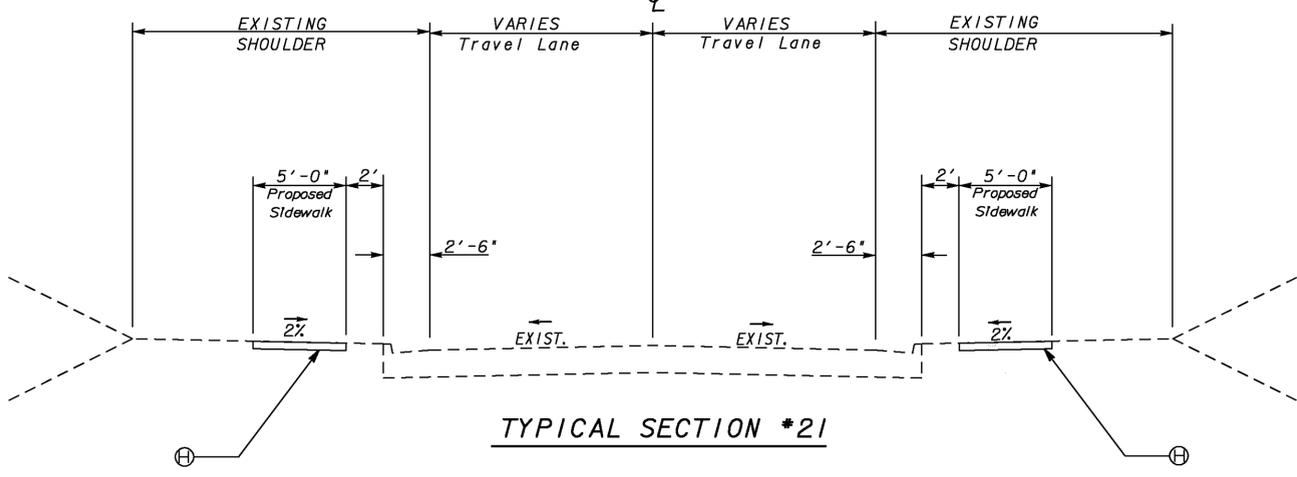

TYPICAL SECTION #21


RIDGEWALK PARKWAY
STA. 96+89.12 TO STA. 99+05.00

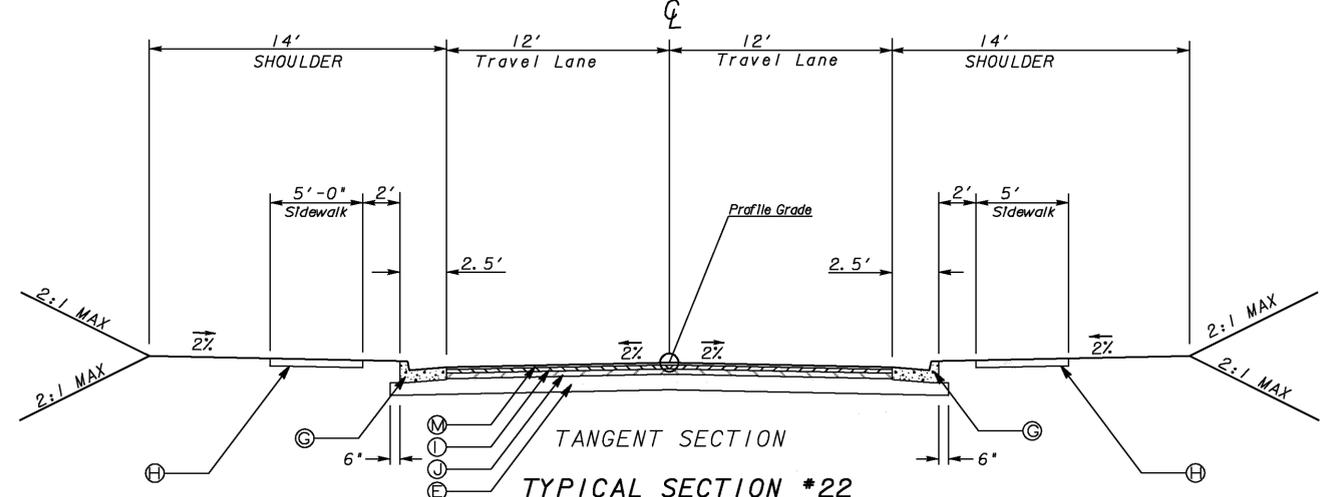

TANGENT SECTION
TYPICAL SECTION #22

RIDGEWALK PARKWAY
STA. 99+05.00 TO STA. 101+19.00

- REQUIRED PAVEMENT**
- (A) ASPHALTIC CONC. 12.5 mm OGFC, GROUP 2, INCL POLYMER-MODIFIED, 90*/SY
 - (B) ASPHALTIC CONCRETE 12.5 mm SMA, 165*/SY
 - (C) ASPHALTIC CONCRETE 19 mm SUPERPAVE, 330*/SY
 - (D) ASPHALTIC CONCRETE 25 mm SUPERPAVE, 880*/SY
 - (E) GRADED AGGREGATE BASE, 12'
 - (F) PLAIN PORTLAND CEMENT CONCRETE, 9"
 - (G) 8"x30" CONC. CURB & GUTTER, GA. STD. 9032 B. TYPE 2
 - (H) 4"x5' CONC. SIDEWALK, DETAIL A-3
 - (I) ASPHALTIC CONCRETE 19mm SUPERPAVE, 220 lb/yd
 - (J) ASPHALTIC CONCRETE 25mm SUPERPAVE, 440 lb/yd
 - (K) GRADED AGGREGATE BASE, 10"
 - (L) CONC MEDIAN PAVING, TYPE 7 CURB FACE, 6 IN
 - (M) ASPHALTIC CONCRETE 12.5 mm SUPERPAVE, 165*/SY
 - (N) ASPHALTIC CONCRETE 25mm SUPERPAVE, 330 lb/yd
 - (O) ASPHALTIC CONCRETE MILLING OR LEVELING AS REQD
 - (P) GRADED AGGREGATE BASE, 8"
 - (Q) CONTINUOUS INDENTATION RUMBLE STRIPS - GROUND-IN-PLACE INTERSTATE

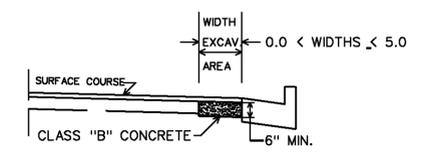


NO SCALE
CLASS "B" CONCRETE BASE OR PAVEMENT WIDENING
Item Code 500-9999 - Cu. Yds.

In excavated areas between the existing paving and new curb and gutter that are 5'-0" or less in width, Class "B" concrete shall be placed in lieu of the base and paving specified by the typical section.

In excavated areas greater than 5'-0" in width, the Contractor shall place base and paving as specified on the typical section.

See plans for details of curb and gutter construction.

CLASS "B" CONCRETE BASE OR WIDENING DETAIL

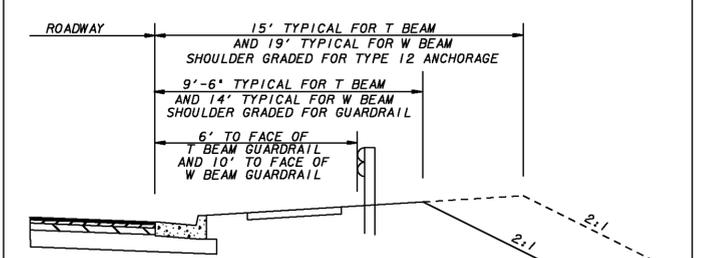

SHOULDER DETAIL FOR GUARDRAIL

SEE GA STD 4280.
SEE PLANS FOR LOCATIONS

REVISION DATES

STATE OF GEORGIA
DEPARTMENT OF TRANSPORTATION
OFFICE: INNOVATIVE PROGRAM DELIVERY
TYPICAL SECTIONS

THE LPA GROUP
TRANSPORTATION CONSULTANTS
3595 ENGINEERING DRIVE
NORCROSS, GEORGIA 30092
(770) 263-9118