


AS-BUILT PLANS 12/12/12

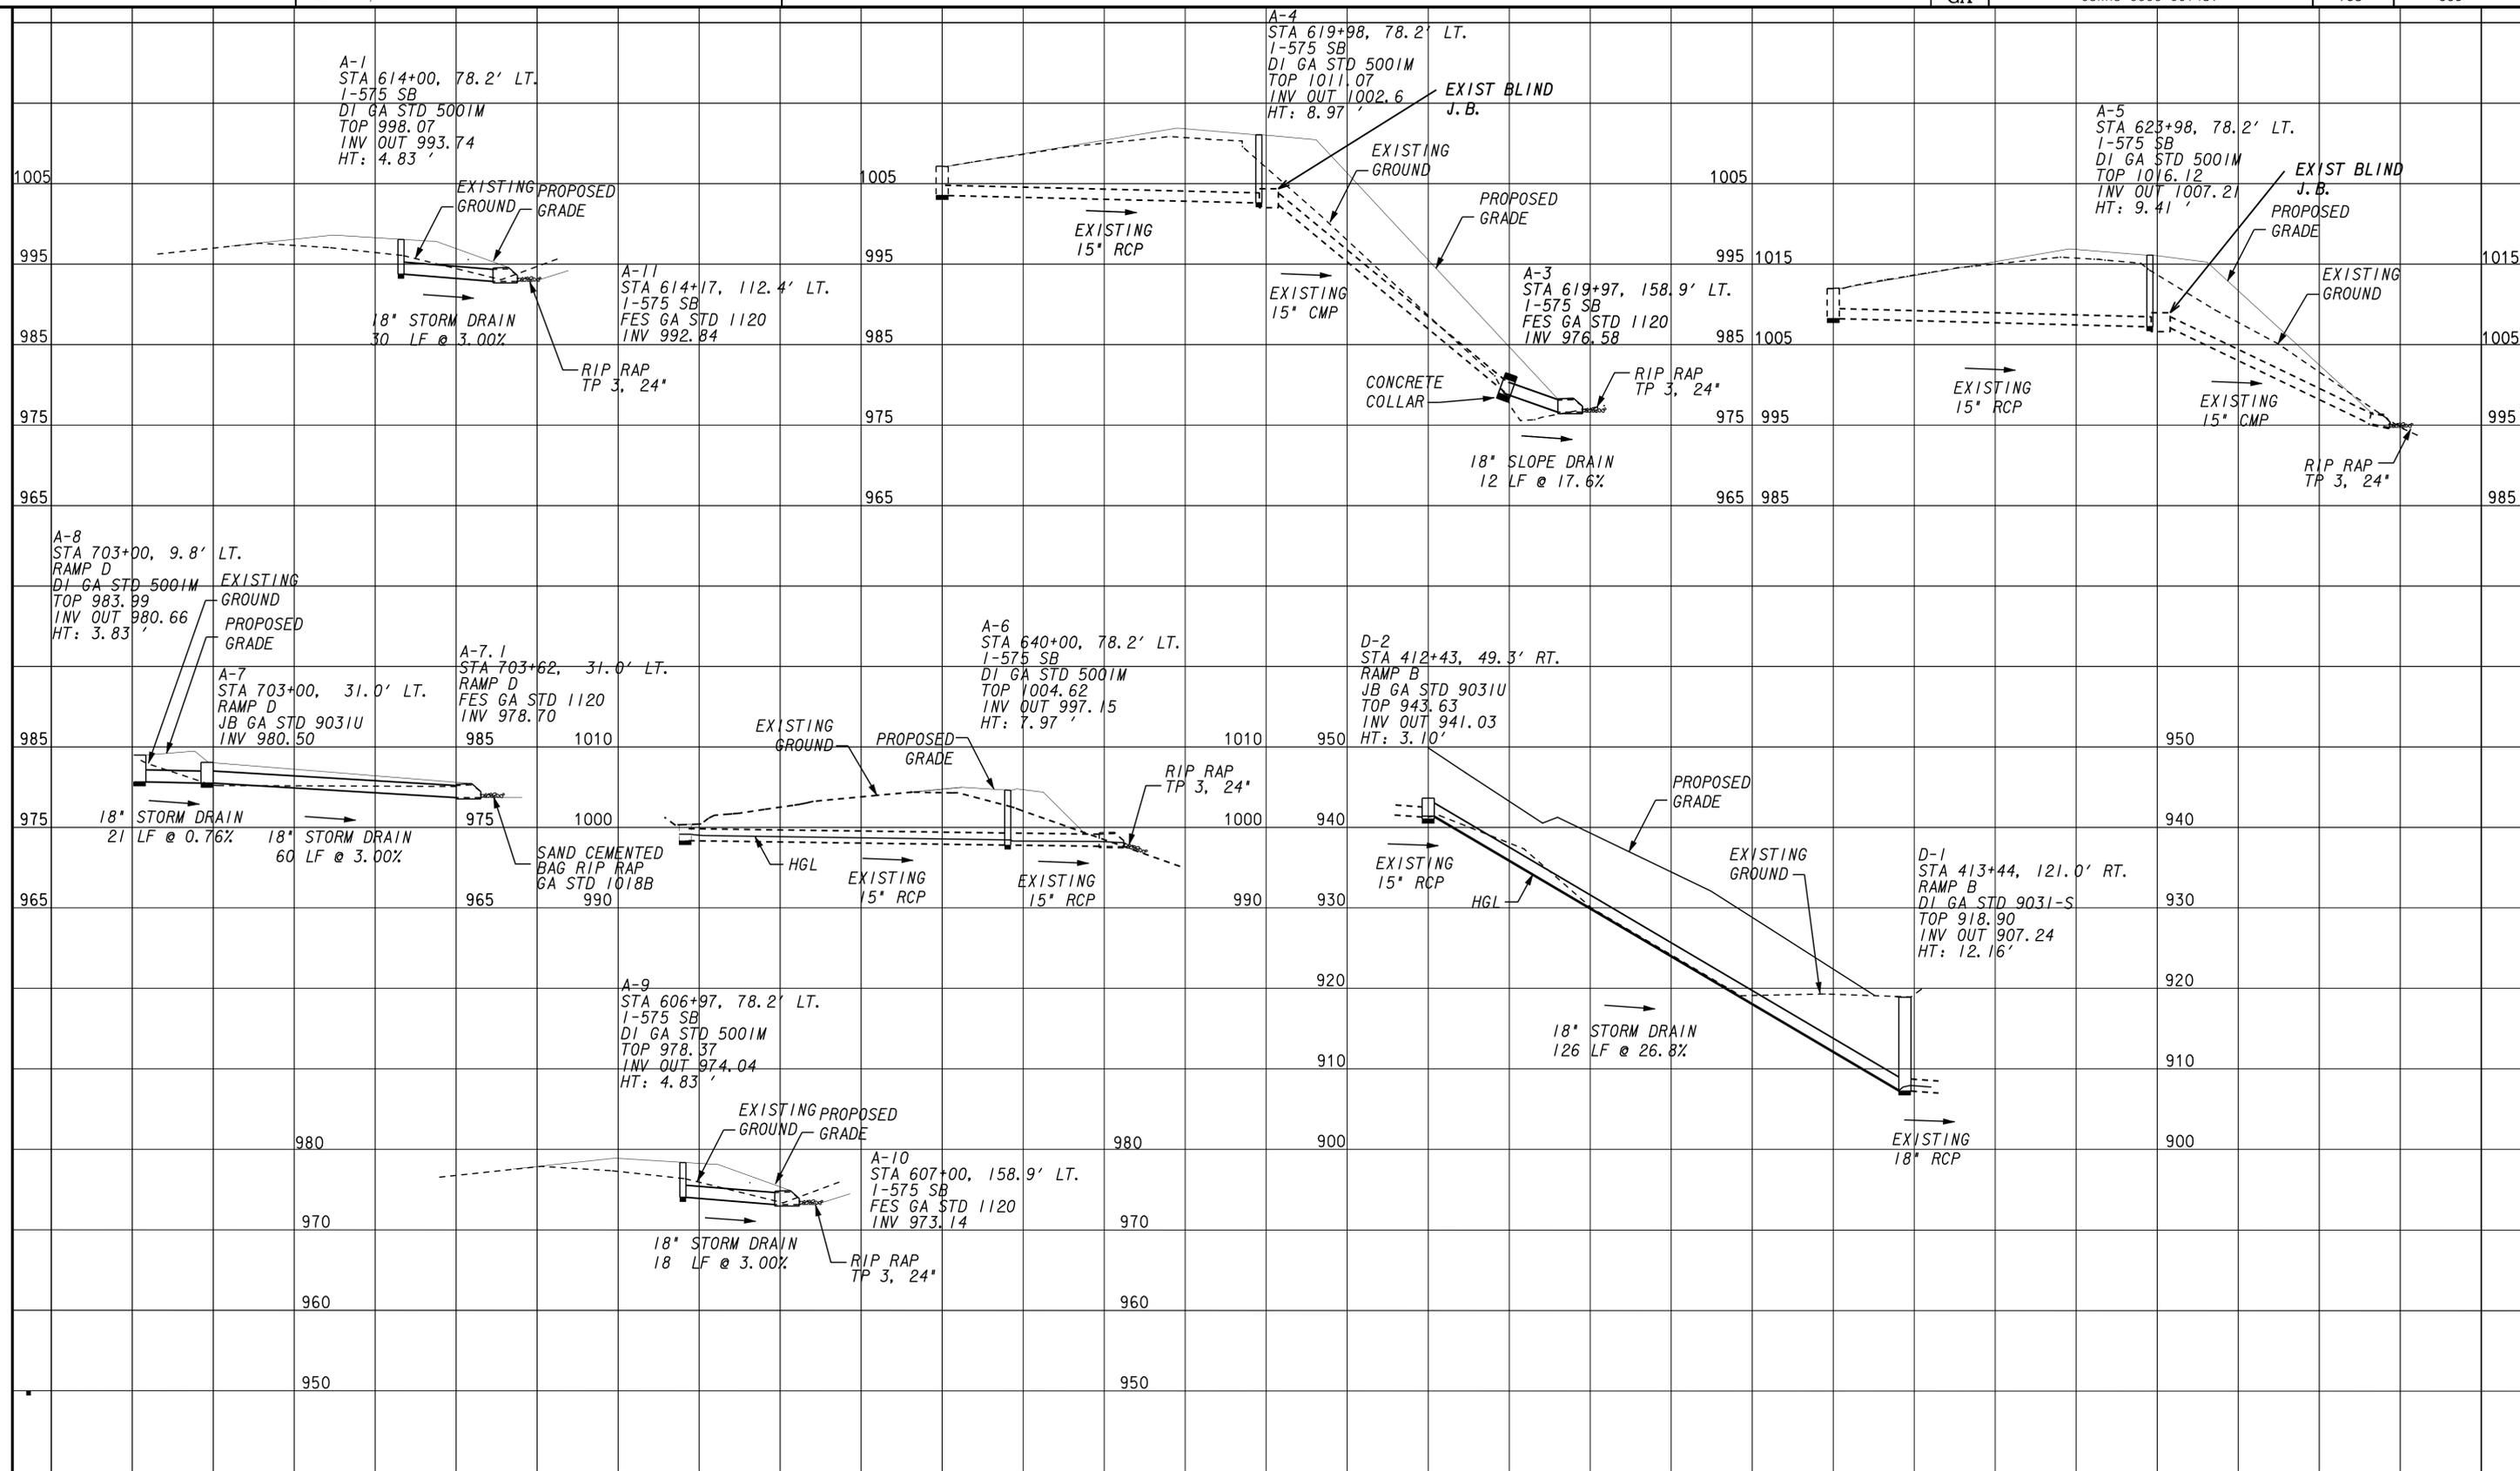

HORZ. 1" = 20'  
VERT. 1" = 10'

REVISION DATES	
07-31-13	

STATE OF GEORGIA  
DEPARTMENT OF TRANSPORTATION  
OFFICE: INNOVATIVE PROGRAM DELIVERY

DRAINAGE PROFILES  
RIDGEWALK PARKWAY  
RELOC. ROPE MILL ROAD