

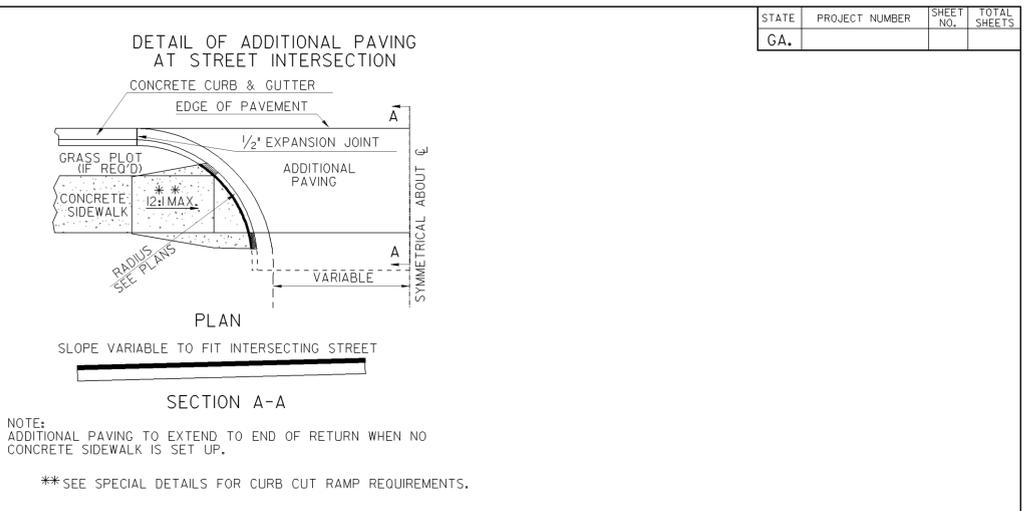
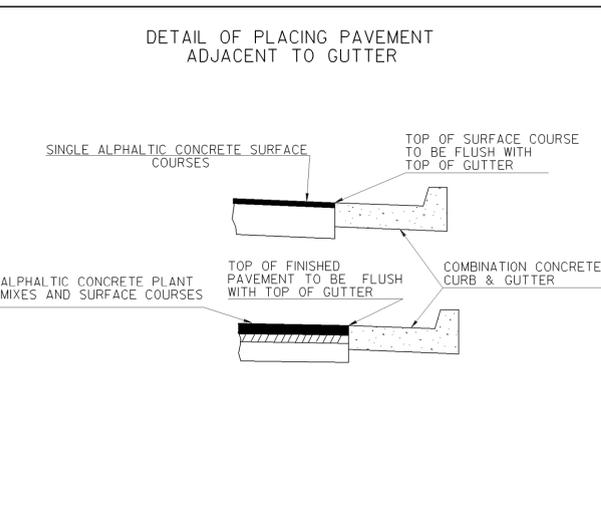
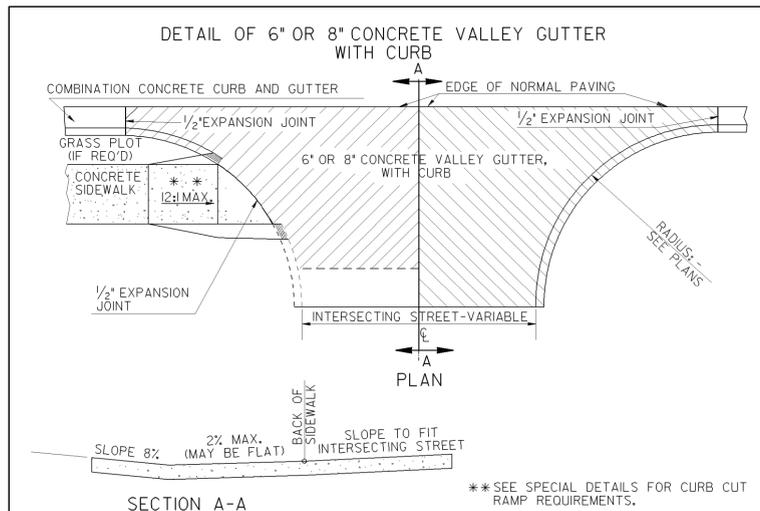
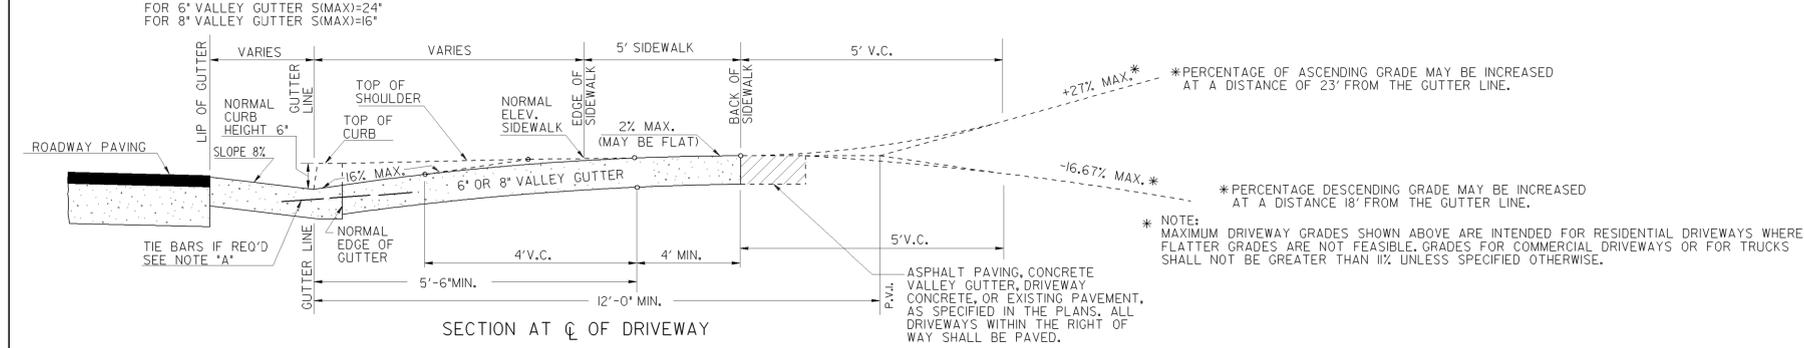
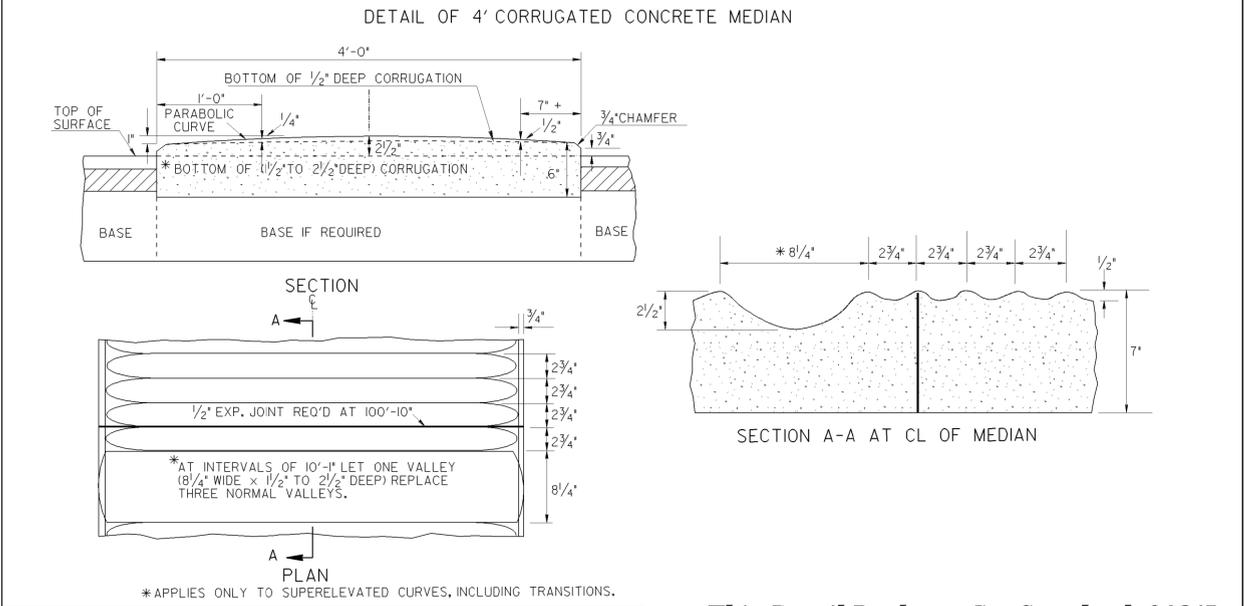


7/22/2011 2:16:33 PM \\GDOT-DSN\GDPLOT\DC\F\GO\_K1P8000.dcf gowens V:\GARY\rev\sd A-1, A-2\A-2.prnt GO-R06

AS-BUILT PLANS 12/12/12

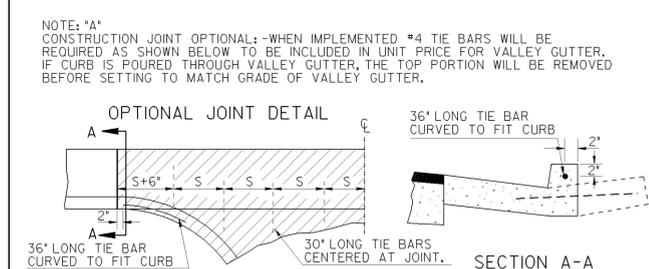

STATE	PROJECT NUMBER	SHEET NO.	TOTAL SHEETS
GA.			

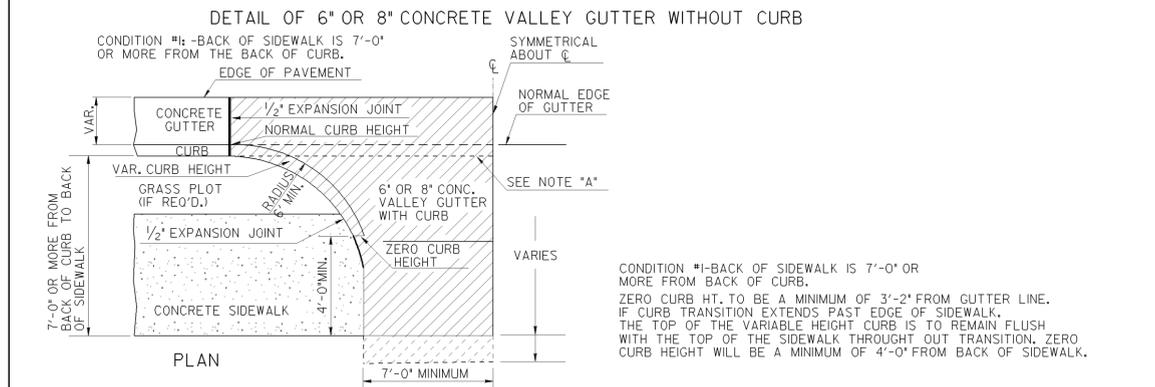

**This Detail Replaces Ga Standard 9031J**

Guidelines For Usage On Metric Projects

When these details are incorporated into plans and or projects that are being prepared or constructed in metric units, exact or precise conversion to metric units is not required. The dimensions shown that are in feet and inches may be converted to corresponding metric units using the following "Rounded-Off" conversion factors: 1" = 25mm, 4" = 100mm, and 12" or 1' = 300mm. All measurement notes that refer to linear feet and square yards shall be interpreted to mean linear meters and square meters.

ADDED PAVEMENT NOTE, REV. 7-2-11	DATE	REVISION	BY
DRIVEWAY SECTION	2-21-03		
REVISED	4-11-02		
REVISED	4-3-02		

DEPARTMENT OF TRANSPORTATION  
STATE OF GEORGIA

CONSTRUCTION DETAIL

CONCRETE VALLEY GUTTER AT STREET INTERSECTION  
6" OR 8" CONCRETE VALLEY GUTTER AT DRIVE  
PLACING PAVEMENT ADJACENT TO GUTTER  
ADDITIONAL PAVING AT STREET INTERSECTION  
4" CORRUGATED CONCRETE MEDIAN

NO SCALE

MARCH 12, 2002

NUMBER  
A2

7/22/2011 2:16:33 PM \\GDOT-DSN\GDPLOT\DC\F\GO\_K1P8000.dcf gowens V:\GARY\rev\sd A-1, A-2\A-2.prnt