




STATE	PROJECT NUMBER	SHEET NO.	TOTAL SHEETS
GA.			

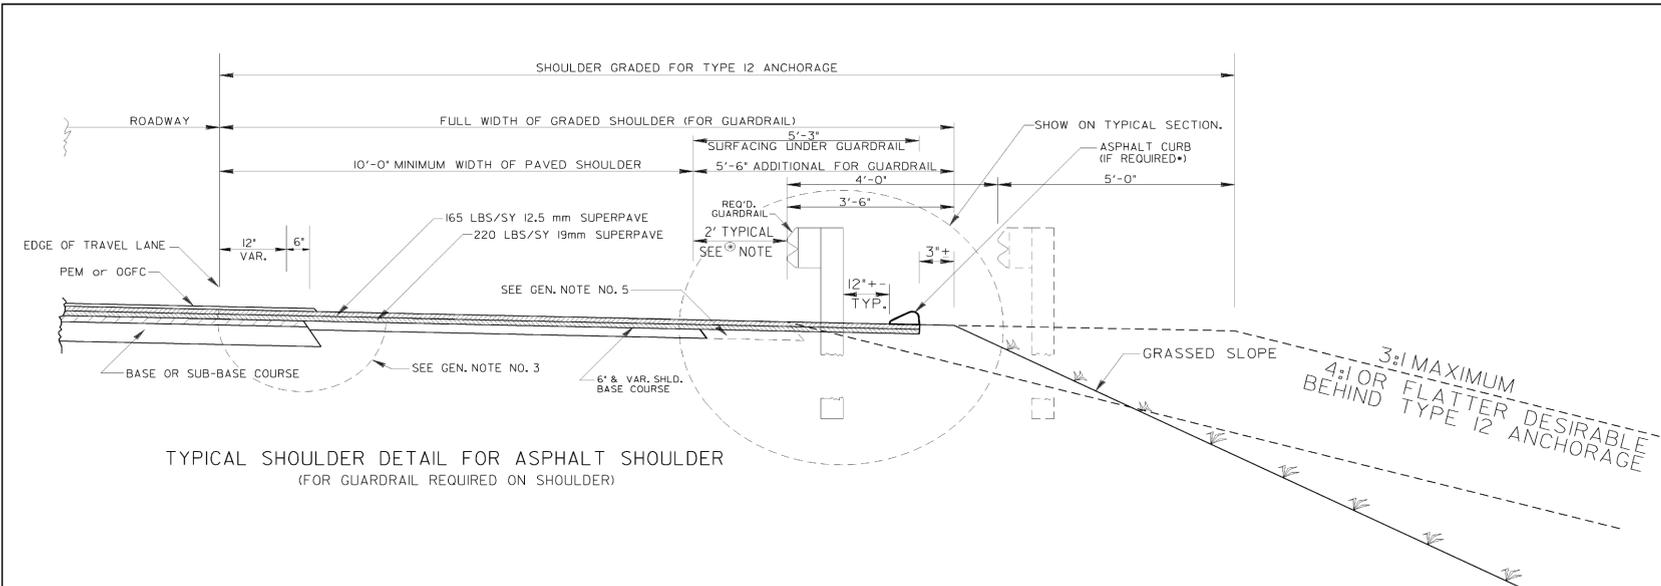

TYPICAL SHOULDER DETAIL FOR ASPHALT SHOULDER  
(FOR GUARDRAIL REQUIRED ON SHOULDER)

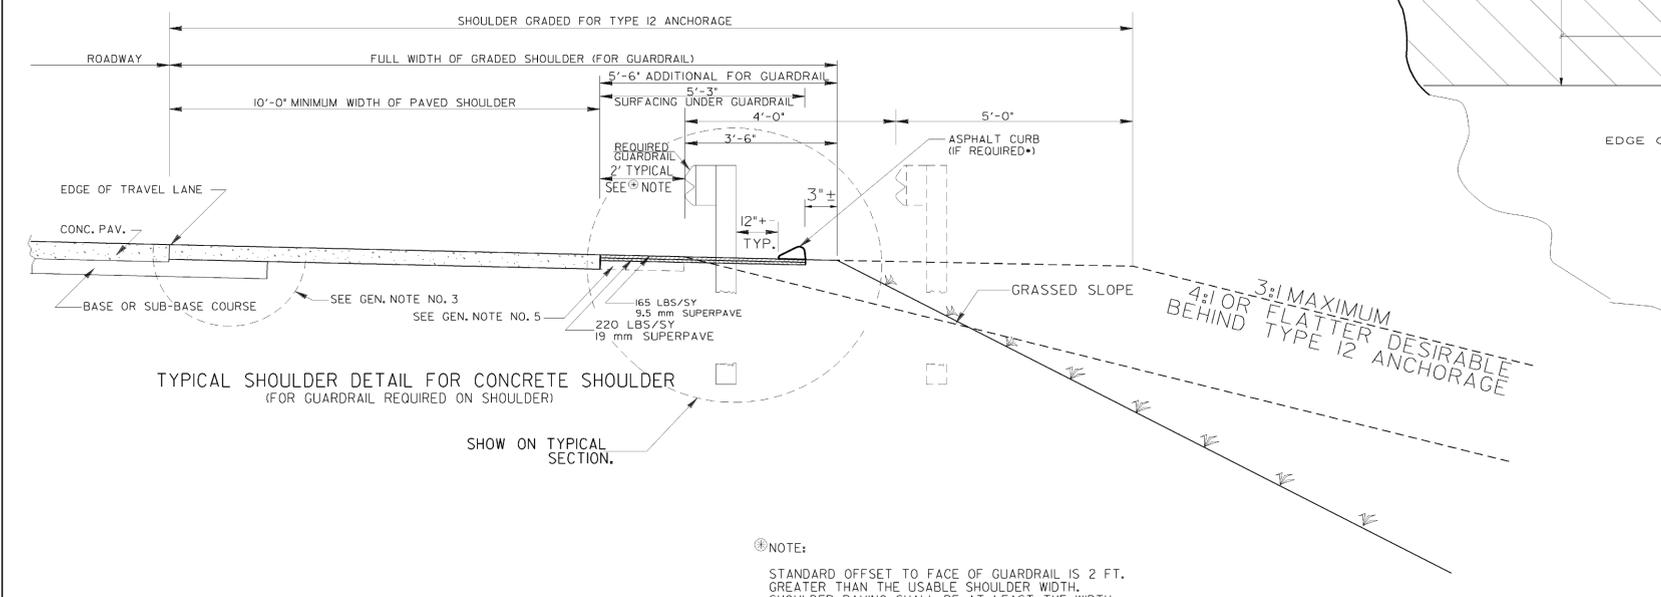

TYPICAL SHOULDER DETAIL FOR CONCRETE SHOULDER  
(FOR GUARDRAIL REQUIRED ON SHOULDER)

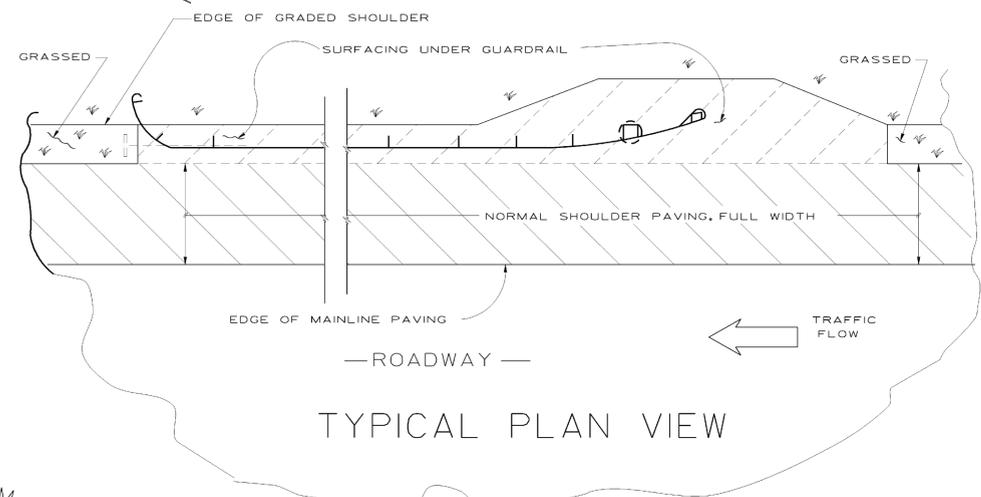

TYPICAL PLAN VIEW

NOTE: DETAIL ABOVE IS TYPICAL. SEE GUARDRAIL STANDARDS FOR SHOULDER WIDENING AT ANCHORAGES, WHERE REQUIRED.

NOTE: NORMAL USE OF THESE DETAILS IS WHERE FULL WIDTH SHOULDER PAVING IS SPECIFIED AND GUARDRAIL IS REQUIRED.

NOTE:  
STANDARD OFFSET TO FACE OF GUARDRAIL IS 2 FT. GREATER THAN THE USABLE SHOULDER WIDTH. SHOULDER PAVING SHALL BE AT LEAST THE WIDTH OF THE USABLE SHOULDER FOR USE OF THESE DETAILS. (SHOULDER PAVING WIDTH MAY BE ADDITIONALLY INCREASED AT GUARDRAIL RUNS TO REDUCE AREA REQUIRING WEED CONTROL). GRADED SHOULDERS SHALL HAVE ADDITIONAL WIDTH FOR GUARDRAIL LOCATION PER STANDARD DETAILS.

\* ASPHALTIC CONCRETE CURB PER SECTION 436 SHALL BE REQUIRED WHERE SPECIFIED. TYPICAL USE IS FOR EROSION PREVENTION OF HIGH FILL SLOPES. THE SHAPE OF ASPHALTIC CURB BEHIND GUARDRAIL MAY VARY AS APPROVED BY THE ENGINEER.

- GENERAL NOTES:
- SPECIFICATIONS: GEORGIA STANDARD, CURRENT EDITION, & SUPPLEMENTS THERETO.
  - THE TREATMENT SHOWN FOR THE OUTER PORTION OF THE SHOULDER APPLIES ONLY WHERE GUARDRAIL IS TO BE LOCATED ALONG PAVED SHOULDER.
  - PAYMENT DESIGN AND NORMAL SHOULDER PAVING ARE ILLUSTRATED AS TYPICAL. OTHER MATERIALS SUCH AS SELECT BORROW, DRAINAGE COURSE, 12.5 MM SUPERPAVE, ETC. SHALL BE AS SPECIFIED ON THE PROJECT, WHERE REQUIRED.
  - AFTER GUARDRAIL POSTS HAVE BEEN INSTALLED, THE SURFACE AREA AROUND THE POSTS SHALL BE SEALED WITH THE APPROPRIATE ASPHALT OR OTHER APPROVED MATERIAL AT NO ADDITIONAL PAYMENT, IF THE ENGINEER DETERMINES IT IS NECESSARY.
  - THE PAVED SHOULDER WIDTH MAY BE EXTENDED TO THE FACE OF THE GUARDRAIL, WHERE SPECIFIED.
  - NORMAL USE OF ASPHALTIC CURB SHALL BE WHERE 2:1 FILL SLOPES WARRANT GUARDRAIL, EXCEPT ON THE HIGH SIDE OF SUPERELEVATION. SEE SEPARATE DETAILS.

REVISION	DATE	REVISION	DATE
9-30-02	4-23-02		
NO SCALE	RE-DRAWN	OCT. 1999	Sheet 2 of 2
DES. & REV. MGR.	(SUBMITTED)	STATE ROAD & AIRPORT DESIGN ENGR.	
REDR. ADS.	(APPROVED)	CHIEF ENGINEER	S-4

AS-BUILT PLANS 12/12/12



REVISION DATES	

STATE OF GEORGIA  
DEPARTMENT OF TRANSPORTATION  
OFFICE: INNOVATIVE PROGRAM DELIVERY  
**CONSTRUCTION DETAILS**

DRAWING No.  
**40-014**