



AS-BUILT PLANS 12/12/12

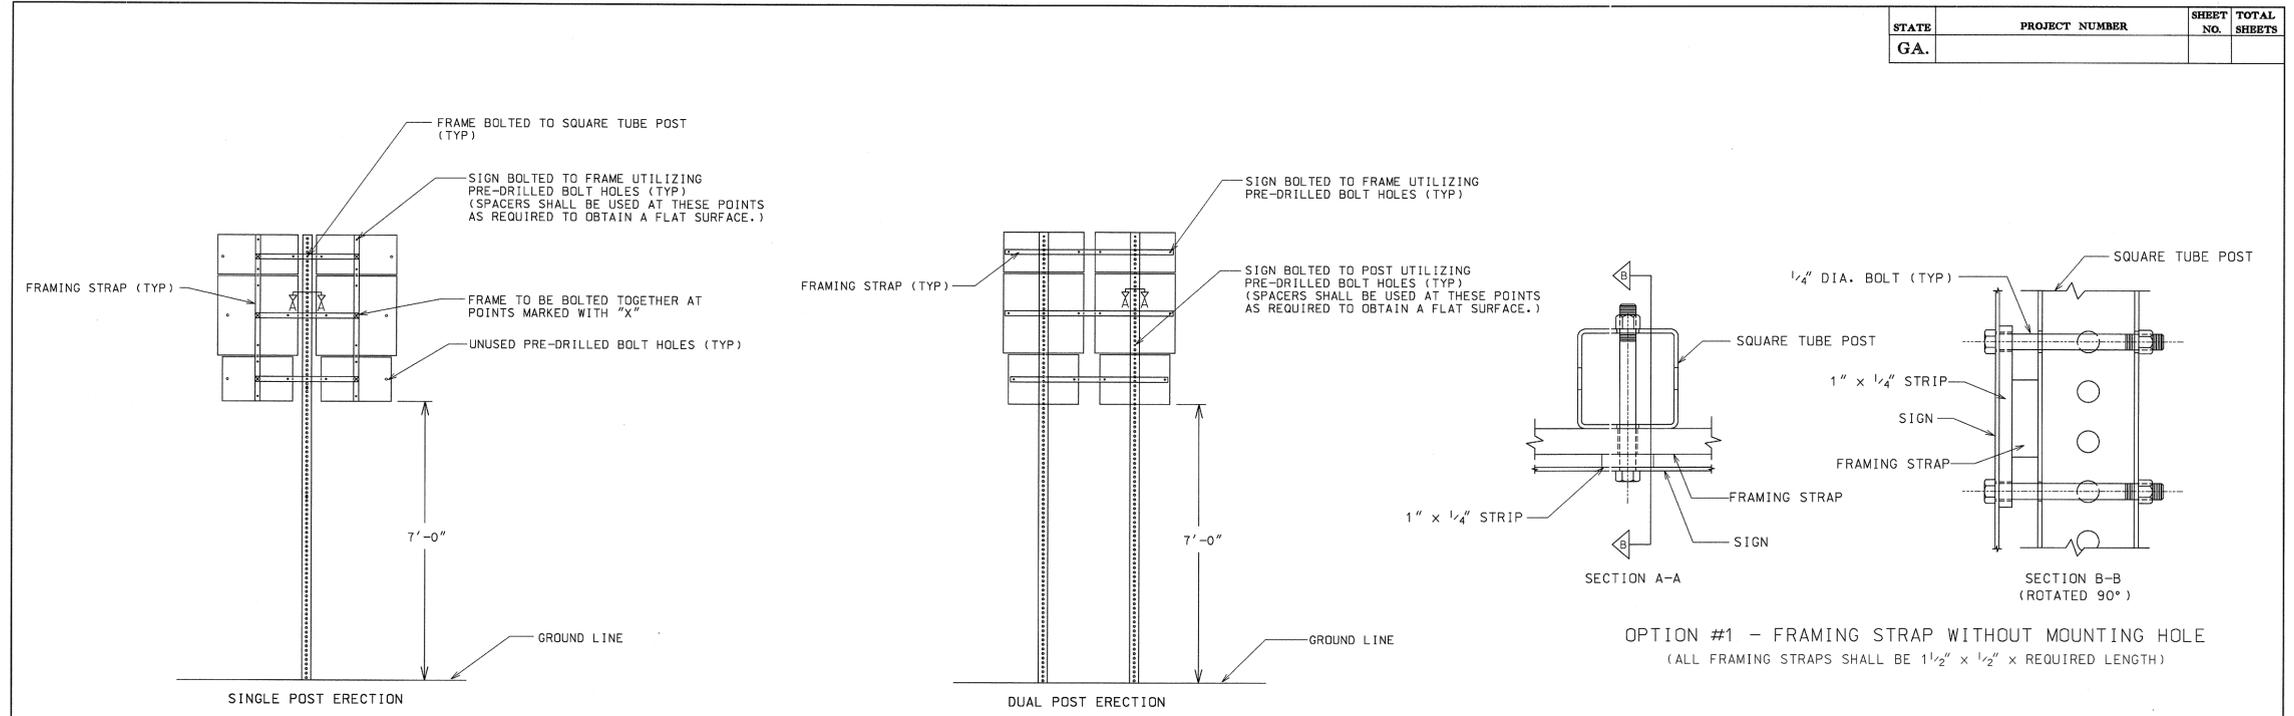

STATE	PROJECT NUMBER	SHEET NO.	TOTAL SHEETS
GA.			

TYPICAL ASSEMBLY UNIT (BACK VIEW)

- GENERAL NOTES:
1. STYLE OF FRAMING IS OPTIONAL. ALTERNATE DESIGNS ARE ACCEPTABLE UPON APPROVAL OF THE ENGINEER. FRAME SHALL BE DESIGNED SO AS TO HOLD THE ASSEMBLY IN A FIXED, RIGID POSITION.
 2. FRAMING STRAPS SHALL BE GALVANIZED STEEL OR ALUMINUM.
 3. STEEL SHALL BE A.S.T.M. DESIGNATION A-283, GRADE D, GALVANIZED IN ACCORDANCE WITH A.S.T.M. DESIGNATION A-123.
 4. ALUMINUM SHALL BE ALLOY 6061-T6.
 5. BOLTS, NUTS, WASHERS, AND SPACERS SHALL CONFORM TO THE STANDARD SPECIFICATIONS AND/OR SPECIAL PROVISIONS.
 6. FRAMING STRAPS ON A DUAL POST ERECTION SHALL NOT BE BOLTED TO THE POST.

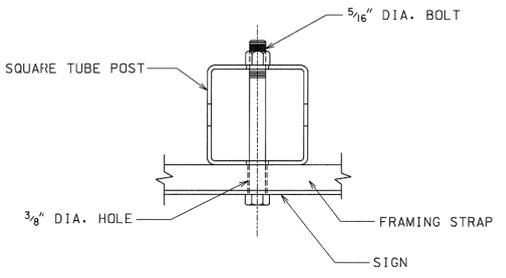

OPTION #2 - FRAMING STRAP WITH MOUNTING HOLE
(ALL FRAMING STRAPS SHALL BE 2" x 1/2" x REQUIRED LENGTH)

DATE	REVISIONS	GEORGIA DEPARTMENT OF TRANSPORTATION OFFICE OF TRAFFIC OPERATIONS
3/31/00	CHANGED U-CHANNEL POST TO SQUARE TUBE POST	
		DETAILS FOR TYPICAL FRAMING
		NO SCALE JANUARY 2000

T-2

THE LPA GROUP

TRANSPORTATION CONSULTANTS
 3595 ENGINEERING DRIVE
 NORCROSS, GEORGIA 30092
 (770) 263-9118

REVISION DATES		

STATE OF GEORGIA
 DEPARTMENT OF TRANSPORTATION
 OFFICE: INNOVATIVE PROGRAM DELIVERY
CONSTRUCTION DETAILS

DRAWING No.
40-019