
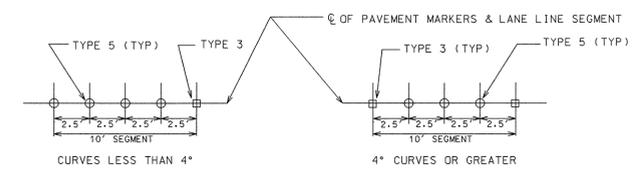
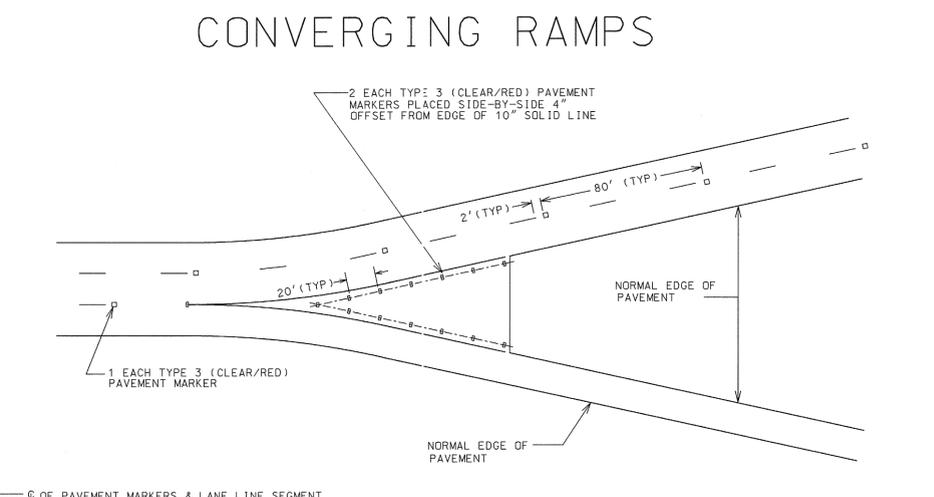
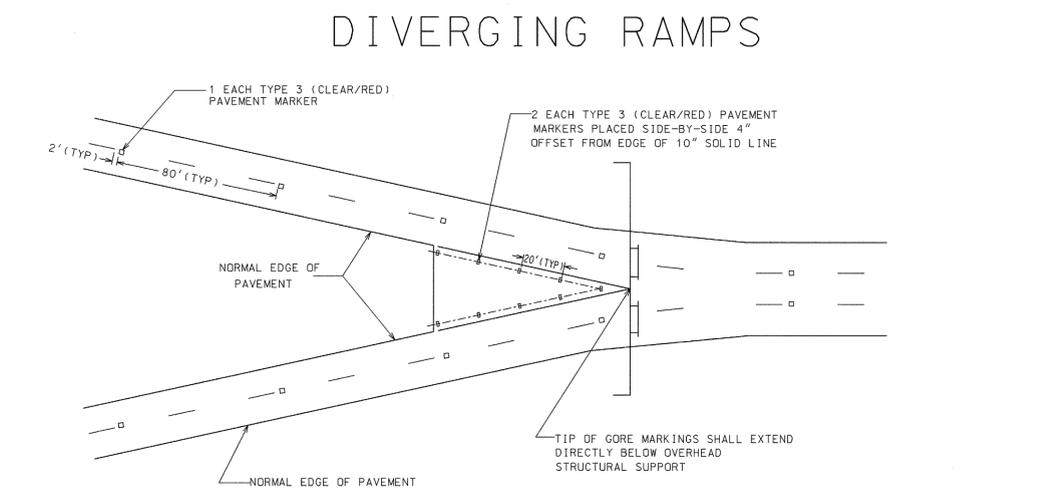
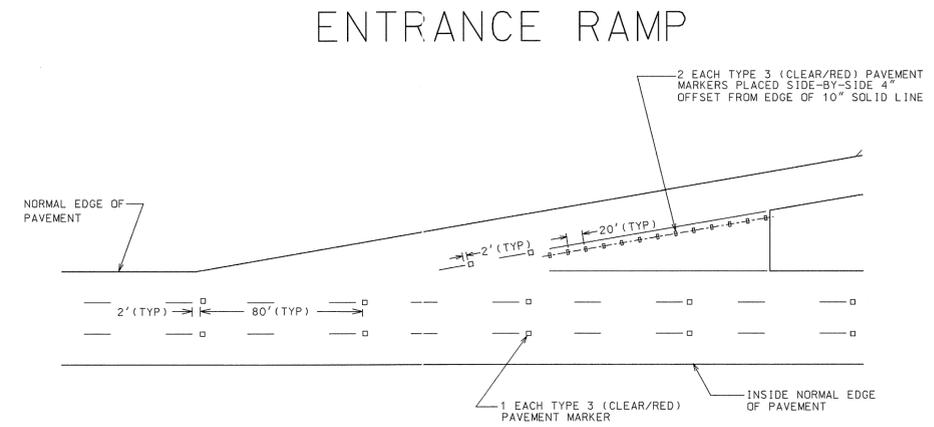


AS-BUILT PLANS 12/12/12

STATE	PROJECT NUMBER	SHEET NO.	TOTAL SHEETS
GA.			

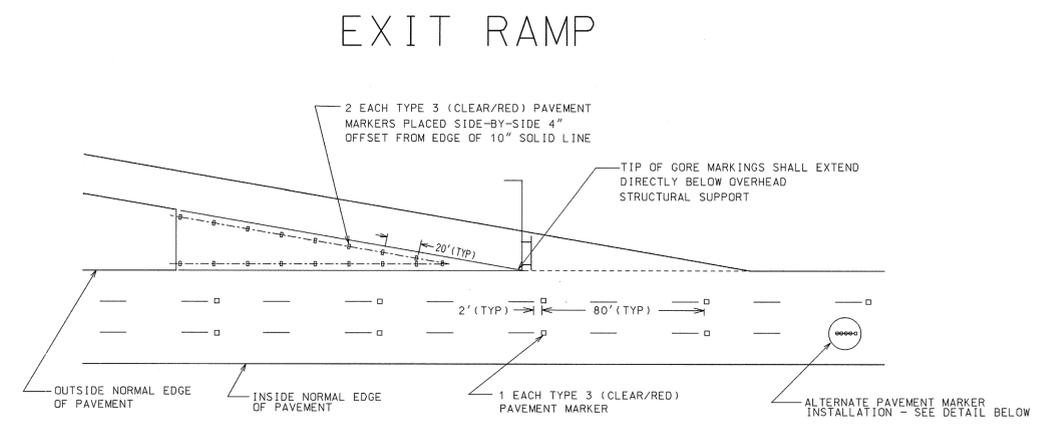

- GENERAL NOTES:**
- FOR SPECIFICATIONS REFER TO STANDARD SPECIFICATIONS; SECTION 654-RAISED PAVEMENT MARKERS.
  - CENTERLINE OF TYPE 3 RAISED PAVEMENT MARKERS SHALL COINCIDE WITH CENTERLINE OF LANES.
  - CLEAR FACE OF TYPE 3 RAISED PAVEMENT MARKERS SHALL BE ORIENTED TOWARD APPROACHING TRAFFIC.

DATE	REVISIONS	GEORGIA DEPARTMENT OF TRANSPORTATION OFFICE OF TRAFFIC SAFETY & DESIGN
		DETAILS OF RAISED PAVEMENT MARKER LOCATION LIMITED ACCESS ROADWAY
		NO SCALE JANUARY 2000

T-15B

**THE LPA GROUP**  
TRANSPORTATION CONSULTANTS  
3595 ENGINEERING DRIVE  
NORCROSS, GEORGIA 30092  
(770) 263-9118

REVISION DATES

STATE OF GEORGIA  
DEPARTMENT OF TRANSPORTATION  
OFFICE: INNOVATIVE PROGRAM DELIVERY  
**CONSTRUCTION DETAILS**

DRAWING No.  
**40-035**