


AS-BUILT PLANS 12/12/12

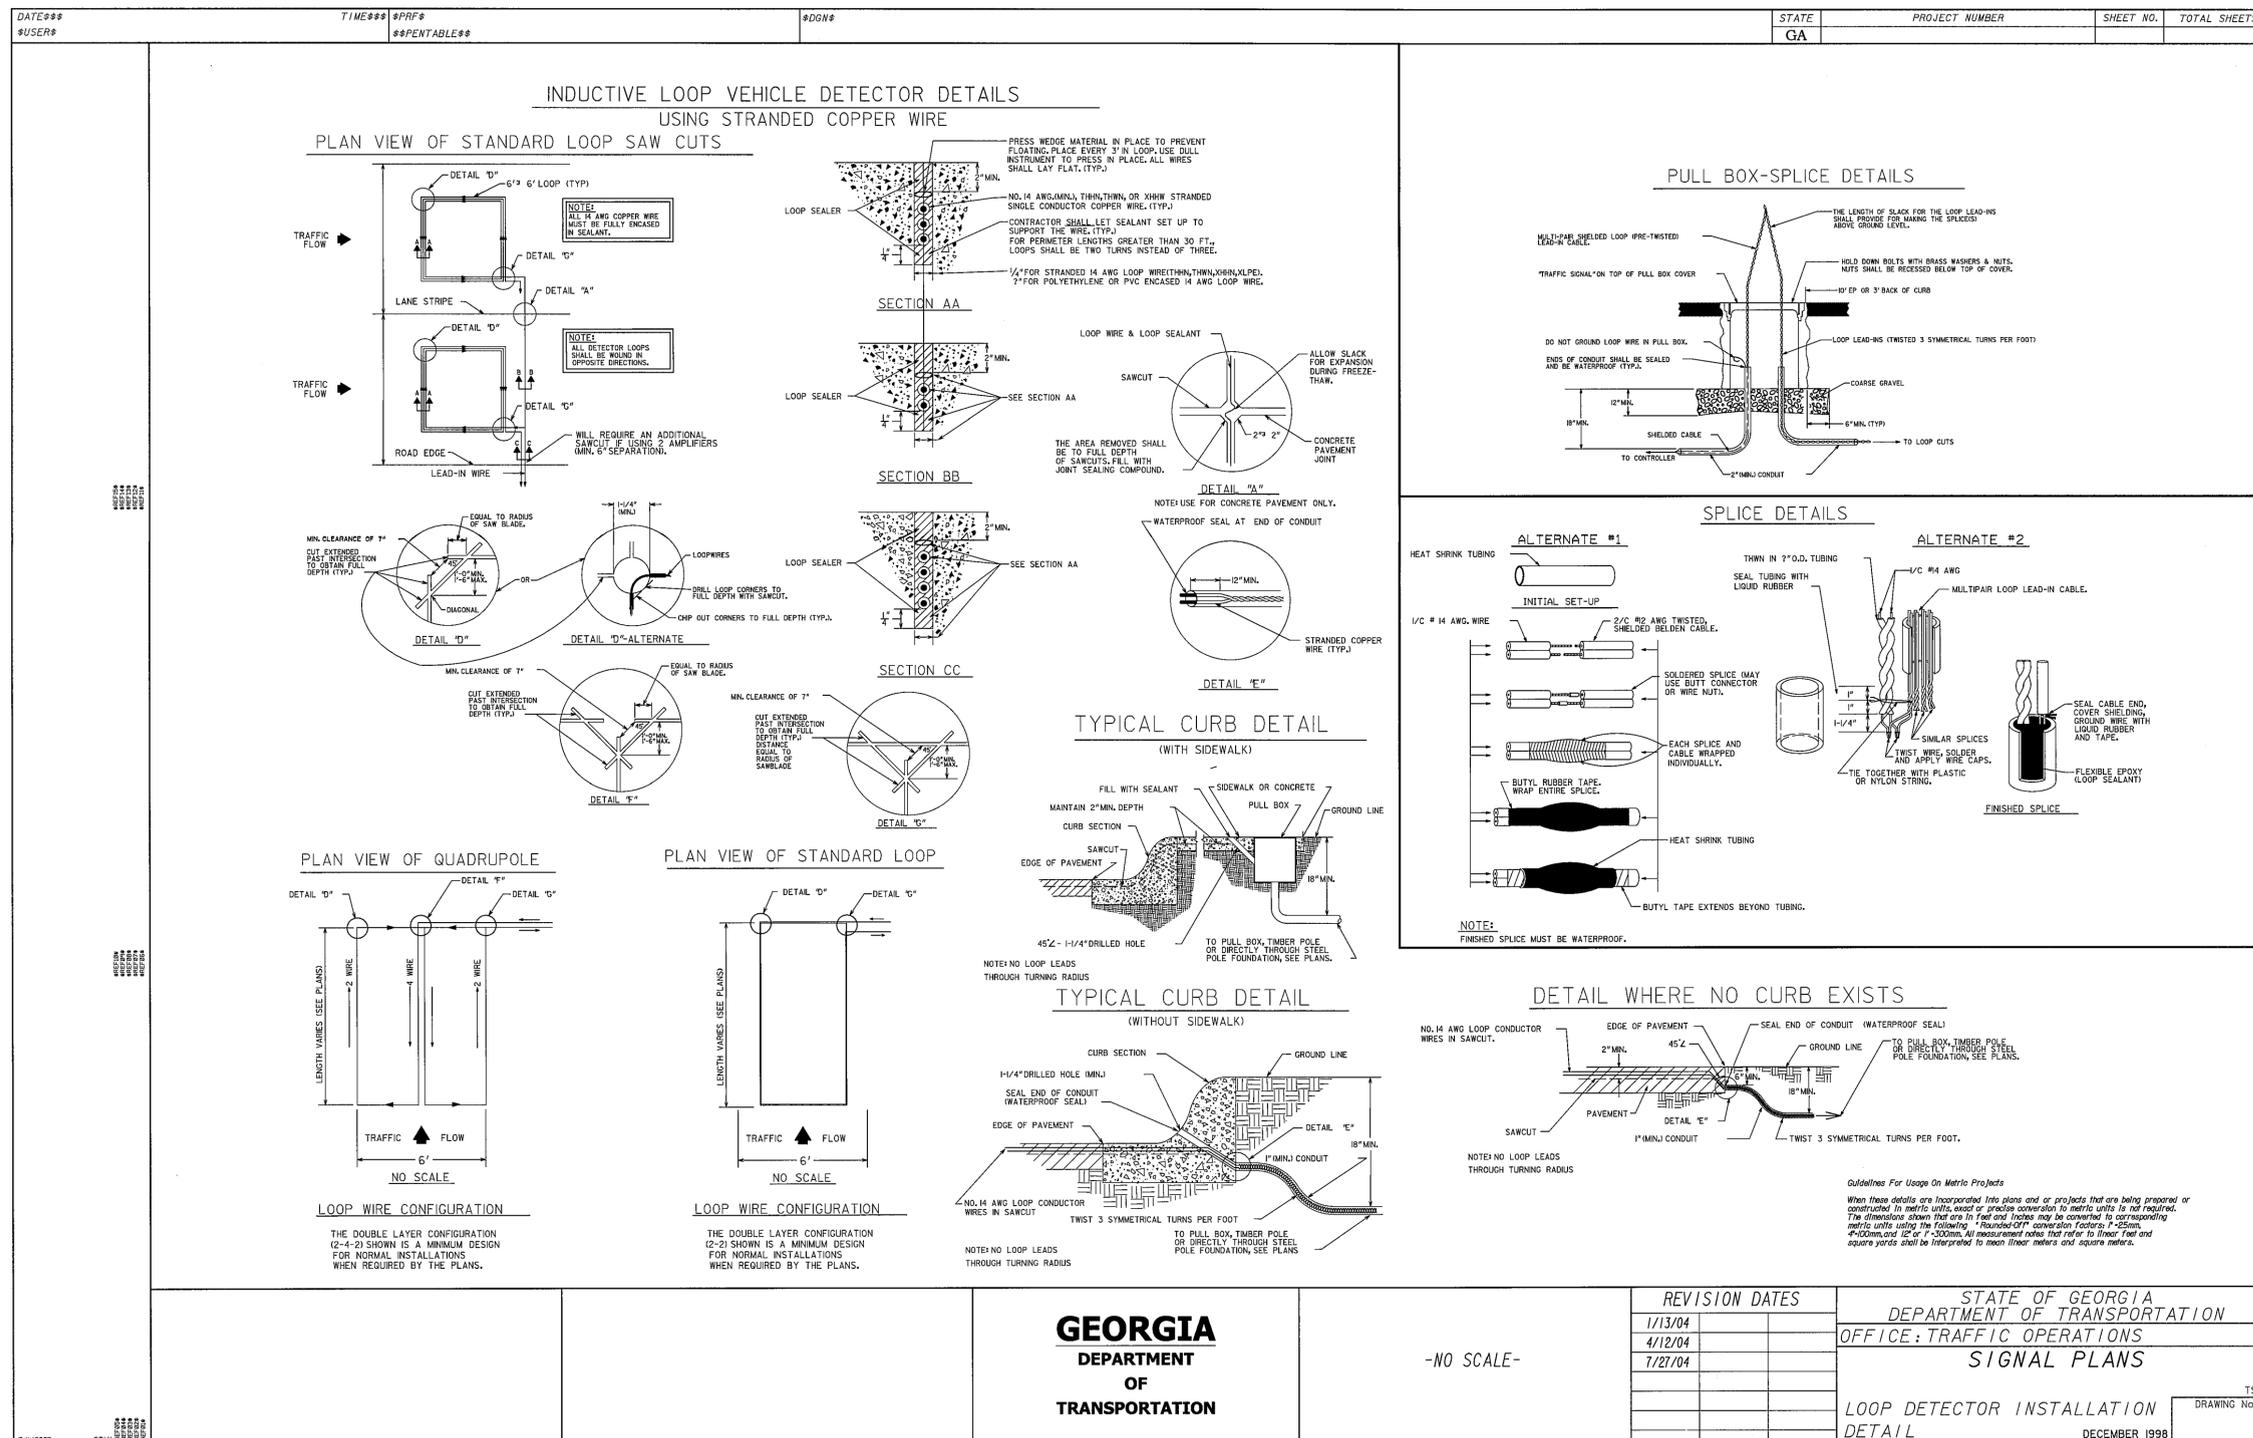

3/11/2007 GPM

3/11/2007 GPM

REVISION DATES	
1/13/04	
4/12/04	
7/27/04	

STATE OF GEORGIA DEPARTMENT OF TRANSPORTATION
OFFICE: INNOVATIVE PROGRAM DELIVERY
CONSTRUCTION DETAILS

TS-01
DRAWING No.
40-039