
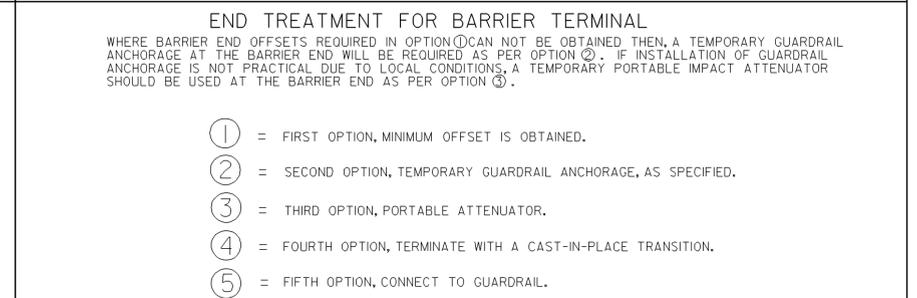
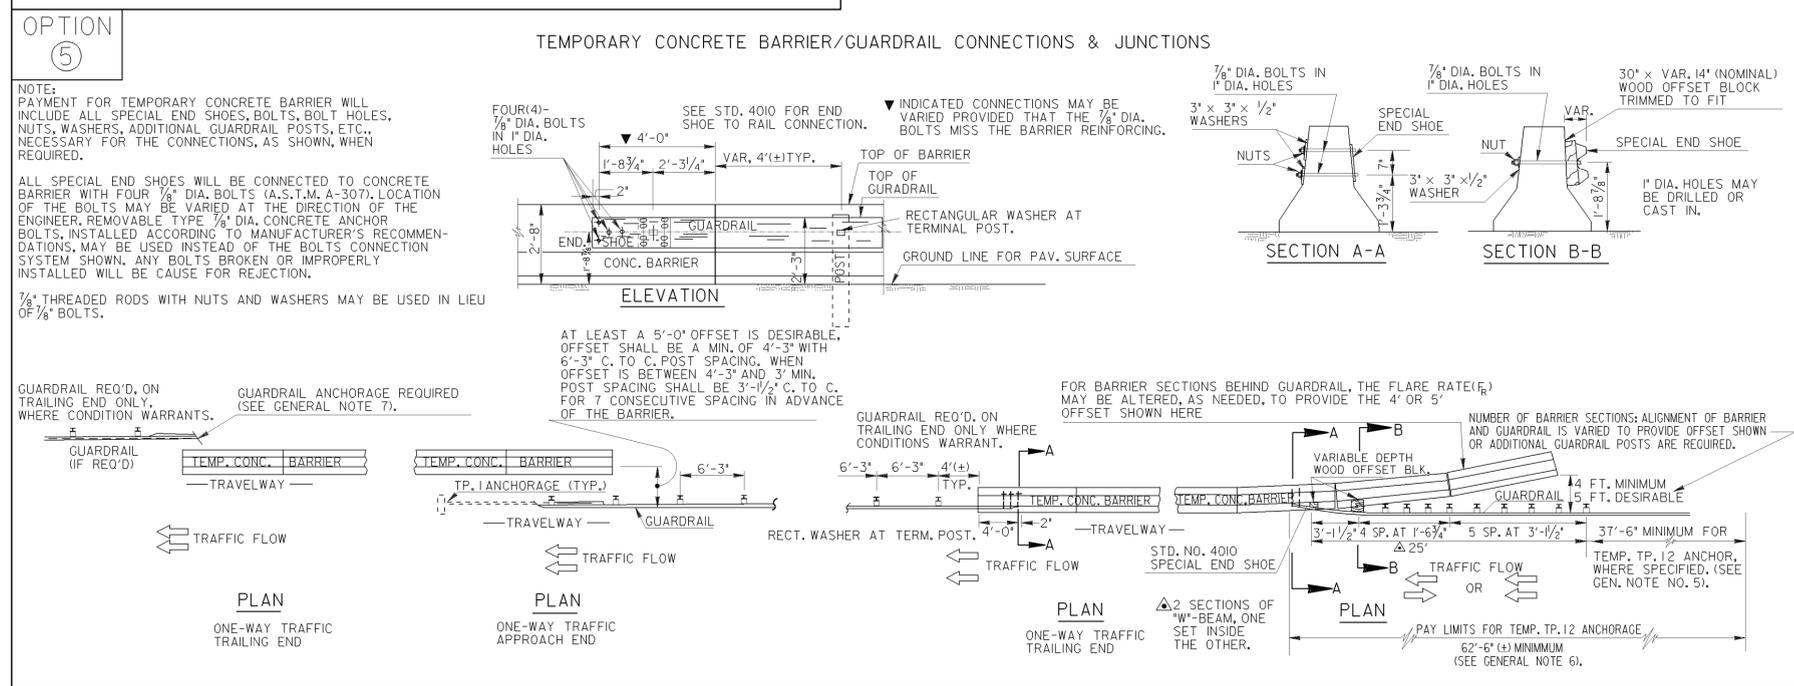
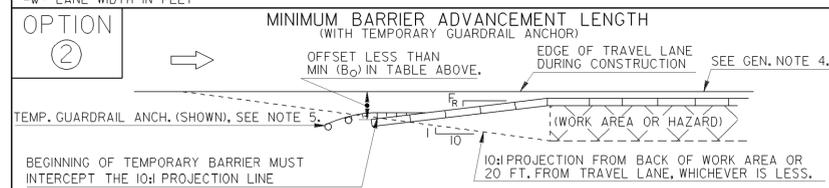
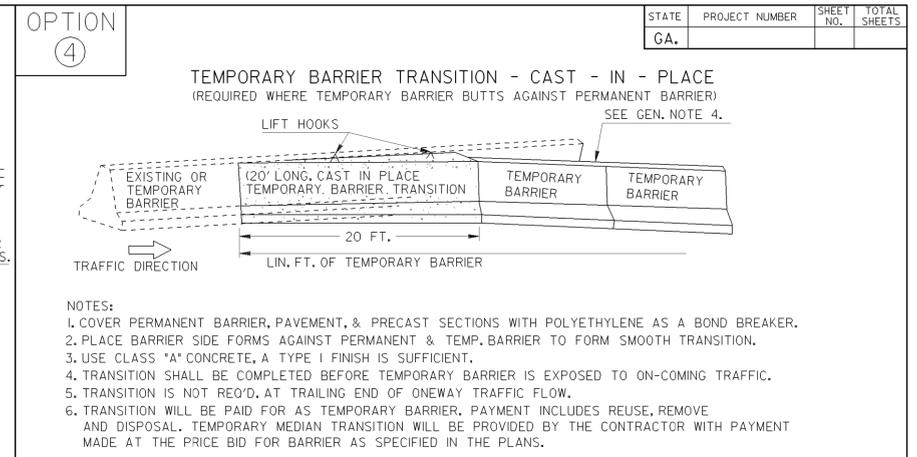
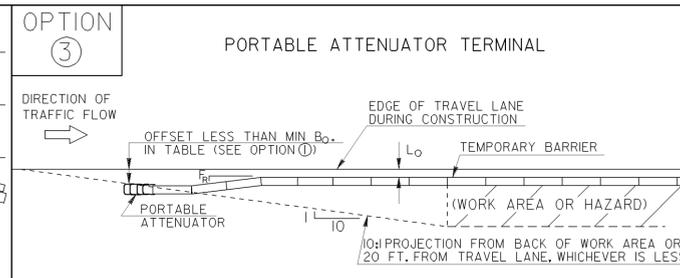


5/21/2007 11:14:50 AM \\6007-DSN1\G0PLOT\OCF\go\_11ff\_output.pdf\_gowens M:\BARY\REVISED\_4960\_EAM\4960.prf\_60-RDE

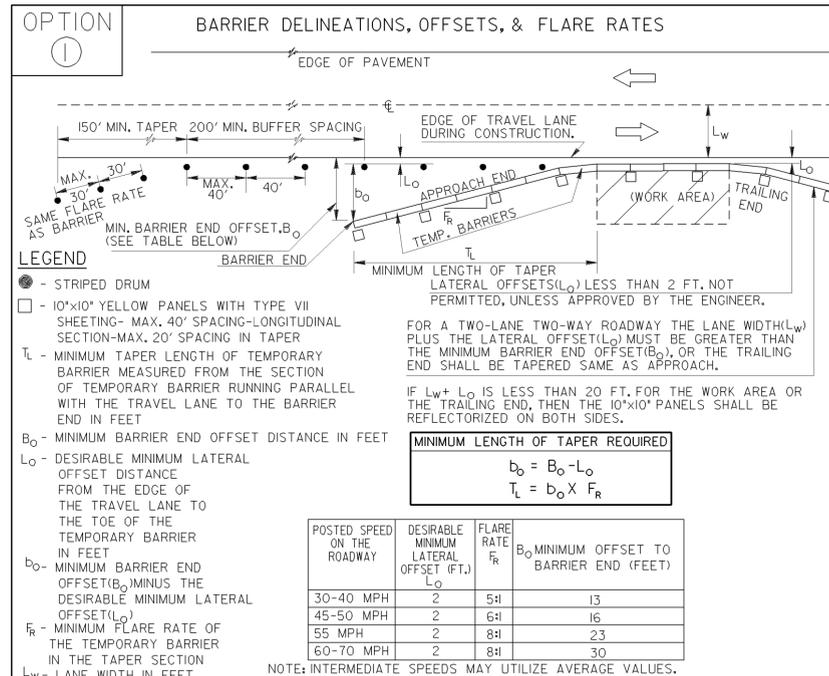

**GENERAL NOTES:**

- BARRIERS SHALL BE PLACED SUCH THAT OPENINGS BETWEEN INDIVIDUAL SECTIONS SHALL BE KEPT TO A MAXIMUM. ALL JOINTS BETWEEN PRECAST SECTIONS SHALL BE CONNECTED AS REQUIRED BY GA. STANDARD 4961 AND/OR MANUFACTURER'S RECOMMENDATIONS.
- THE BARRIER IS NOT TO BE CONNECTED TO THE BRIDGE DECK BY CONNECTING PINS OR REBAR UNLESS AN APPROVED METHOD FOR CONNECTION IS REQUIRED.
- PRECAST BARRIER SECTIONS SHALL CONFORM TO THE DIMENSIONAL REQUIREMENTS IN GA. STANDARD 4961 AND/OR MANUFACTURER'S RECOMMENDATIONS.
- TRAFFIC CONTROL NOT SHOWN ON THIS STANDARD SHALL BE IN ACCORDANCE WITH CURRENT EDITION OF SECTION 150, STANDARDS, CONSTRUCTION DETAILS AND/OR PLAN SHEETS, DRUMS, ETC. SHOWN FOR OPTION 1 SHALL BE APPLICABLE FOR THE OTHER OPTIONS AS WELL. DRUMS SHALL BE PROVIDED IN ADVANCE OF TEMPORARY BARRIERS INSTALLATION AND SHALL BE IN PLACE BEFORE THE BARRIER IS INSTALLED AND REMOVED AFTER THE BARRIER IS REMOVED.
- WHERE TEMPORARY GUARDRAIL ANCHORAGE IS SPECIFIED, THE FIRST BREAKAWAY SHALL BE 37'-6" MINIMUM IN ADVANCE OF BEGINNING THE TEMPORARY BARRIER INSTALLATION.
- PAYMENT FOR TEMPORARY GUARDRAIL ANCHORS INCLUDES END SHOE, CONNECTING BOLTS, NUTS AND WASHERS, ADDITIONAL POSTS AND OFFSETS BLOCKS, 25 FT. ADDITIONAL "W" BEAM WITH THE DOUBLE NESTED SECTION PLUS STANDARD ANCHORAGE COMPONENTS. (TOTAL LENGTH=62'-6" (+) MIN.
- UNACCEPTABLE OR NON-STANDARD END TREATMENT WILL NOT BE LEFT IN PLACE AFTER REMOVAL OF THE TEMPORARY BARRIER. ALL GUARDRAIL AND ALL ANCHORAGES LEFT IN PLACE WILL BE TREATED AS NECESSARY TO CONFORM WITH CURRENT STANDARDS IMMEDIATELY AFTER REMOVAL OF THE TEMPORARY BARRIER.

REVISED ALL OPTIONS AND REV. REFLECTIVE SHEETINGS		5-10-07	DEPARTMENT OF TRANSPORTATION STATE OF GEORGIA	
TYPE AND GENERAL NOTES		2-1-01	STANDARD	
DATE		REVISION	TEMPORARY BARRIER (END TREATMENT OPTIONS)	
NO SCALE		REV. & REDR. MAY, 1999	NUMBER 4960	
DES. (SUBMITTED) <i>[Signature]</i>	TRA. (APPROVED) <i>[Signature]</i>	CH. (APPROVED) <i>[Signature]</i>		
DRW.	TRA.	CH.		

AS-BUILT PLANS 12/12/12

**THE LPA GROUP**  
TRANSPORTATION CONSULTANTS  
A UNIT OF MICHAEL BAKER CORPORATION  
3595 ENGINEERING DRIVE  
NORCROSS, GEORGIA 30092  
(770) 263-9118

REVISION	DATE

STATE OF GEORGIA  
DEPARTMENT OF TRANSPORTATION  
OFFICE: INNOVATIVE PROGRAM DELIVERY  
**GEORGIA STANDARDS**