
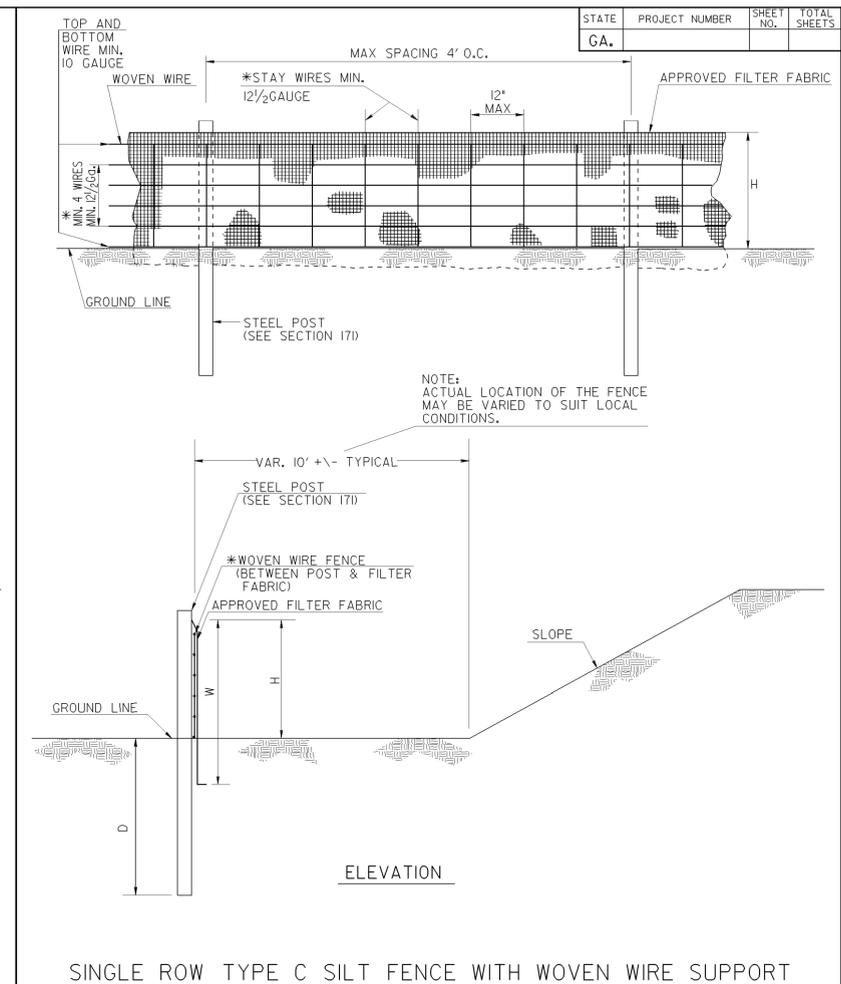
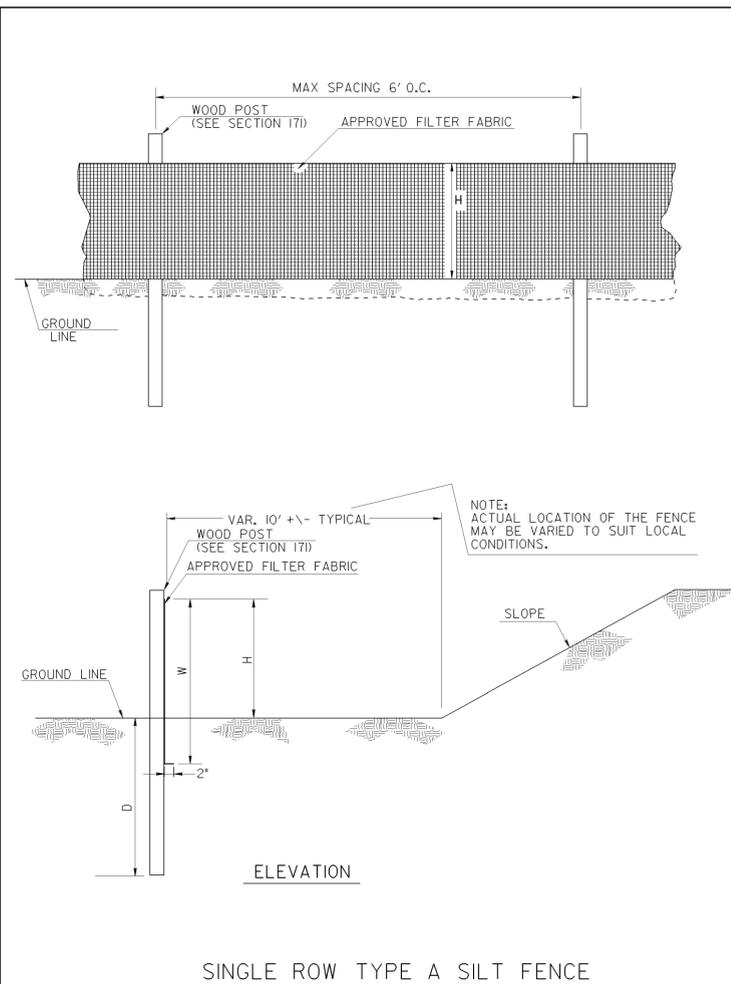


1/18/2011 1:25:13 PM \\GDOT-DSN\GOLPLOT\OCF\GO_K1p8000.qcf gowens V:\GARY\Rev. Construction Details\D-24A\D-24A.prf 60-R06

AS-BUILT PLANS 12/12/12

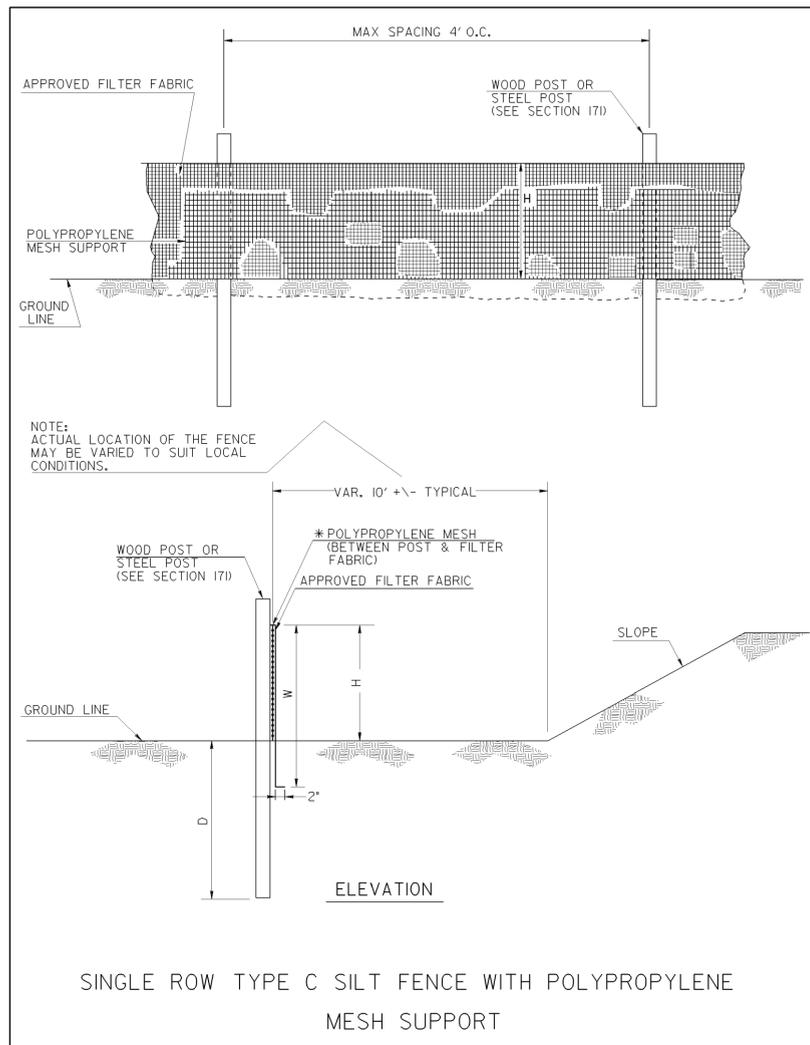

| FENCE TYPE | POST LENGTH | H | D | W | TYPICAL USES |
|------------|-------------|-------|-------|-------|---|
| TYPE "A" | 4 FT. | 2'-4" | 1'-6" | 3'-0" | |
| TYPE "C" | 4 FT. | 2'-4" | 1'-6" | 3'-0" | AT BRIDGE END ROLLS, DOUBLE ROW ALONG STREAMS, WETLANDS AND ENVIRONMENTALLY SENSITIVE AREAS FOR USE OF THIS MATERIAL IN FABRIC CHECKDAMS SEE D-24D. |

NOTES:

1. WIRE STAPLES SHALL BE AT LEAST 17 GAUGE, WITH LEGS AT LEAST 1/2 INCHES LONG AND A CROWN AT LEAST 3/4 INCHES WIDE. NAILS SHALL BE AT LEAST 14 GAUGE, 1 INCH LONG, WITH BUTTON HEADS AT LEAST 3/4 INCHES WIDE.
2. NAILS OR STAPLES SHALL BE EVENLY PLACED WITH AT LEAST 5 PER POST FOR TYPE A FENCE AND 4 PER POST FOR TYPE C FENCE.
3. THE VERTICAL WIRES FOR THE WOVEN WIRE SUPPORT FENCE SHALL HAVE A MAXIMUM SPACING OF 12 INCHES. THE TOP AND BOTTOM WIRES SHALL BE AT LEAST 10 GAUGE AND ALL OTHER WIRES SHALL BE AT LEAST 12 1/2 GAUGE.
4. TEMPORARY SILT FENCE INSTALLATION IS DIFFERENT THAN THE SILT RETENTION BARRIER INSTALLATION.
5. SEE SECTION 171 FOR SILT FENCE SPECIFICATIONS.
6. SEE SECTION 894 FOR FENCING SPECIFICATIONS.
7. SEE OPL-36 FOR A LIST APPROVED SILT FENCE FABRIC.
8. TEMPORARY SILT FENCE SHALL NOT BE PLACED WITHIN STATE WATERS UNLESS PERMITTED.

| | |
|----------|--|
| DATE | DEPARTMENT OF TRANSPORTATION STATE OF GEORGIA |
| REVISION | CONSTRUCTION DETAILS TEMPORARY SILT FENCE |
| BY | NO SCALE REV. AND REDRAWN JAN. 2011 |
| | NUMBER D-24A (SHEET 1 OF 4) |

1/18/2011 1:25:13 PM \\GDOT-DSN\GOLPLOT\OCF\GO_K1p8000.qcf gowens V:\GARY\Rev. Construction Details\D-24A\D-24A.prf

REVISION DATES

| | | |
|--|--|--|
| | | |
| | | |
