
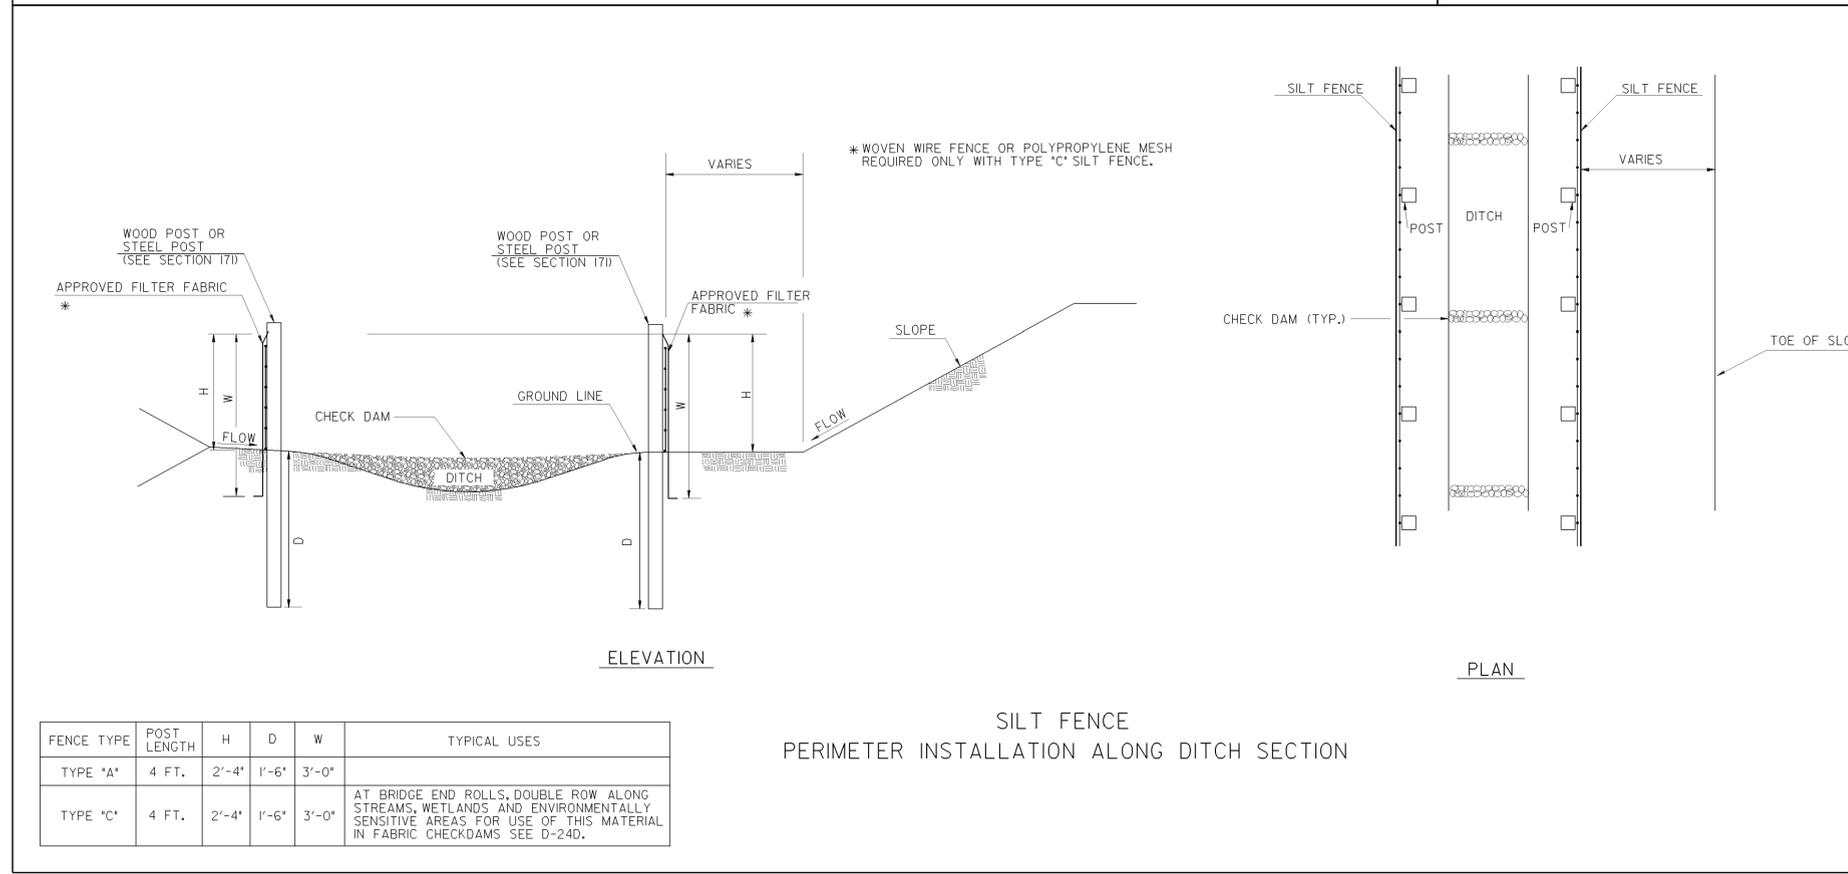
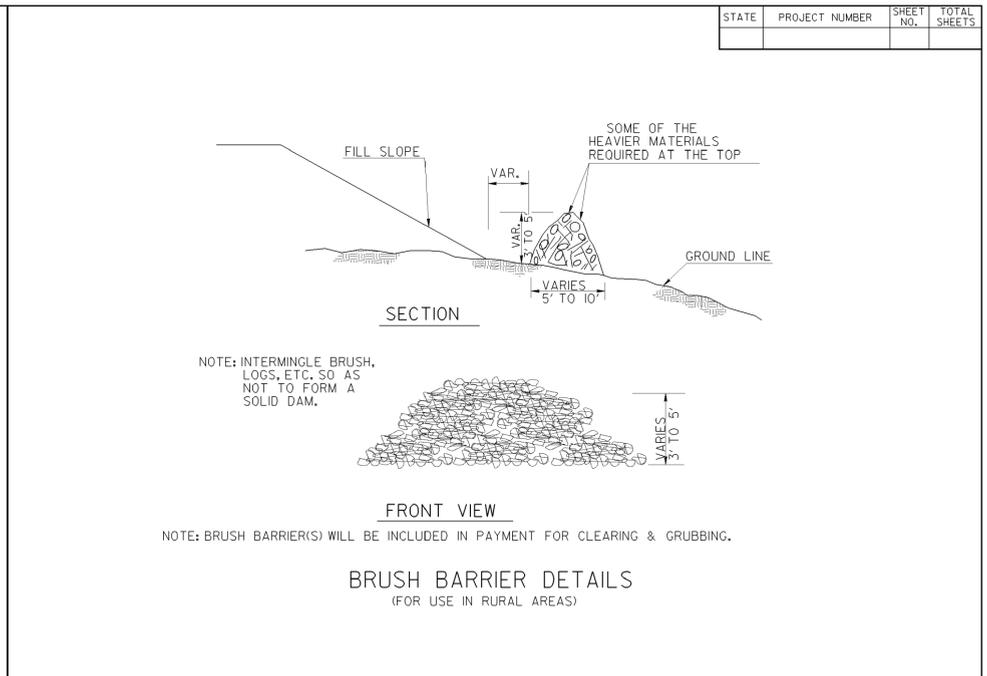


1/18/2011 2:04:43 PM \\GDOT-DSN\GDOT\DOT\GCF\G0_Xip8000.qcf gowens V:\GAR\Rev. Construction Details\D-24B\D-24B.prf 60-R06

AS-BUILT PLANS 12/12/12

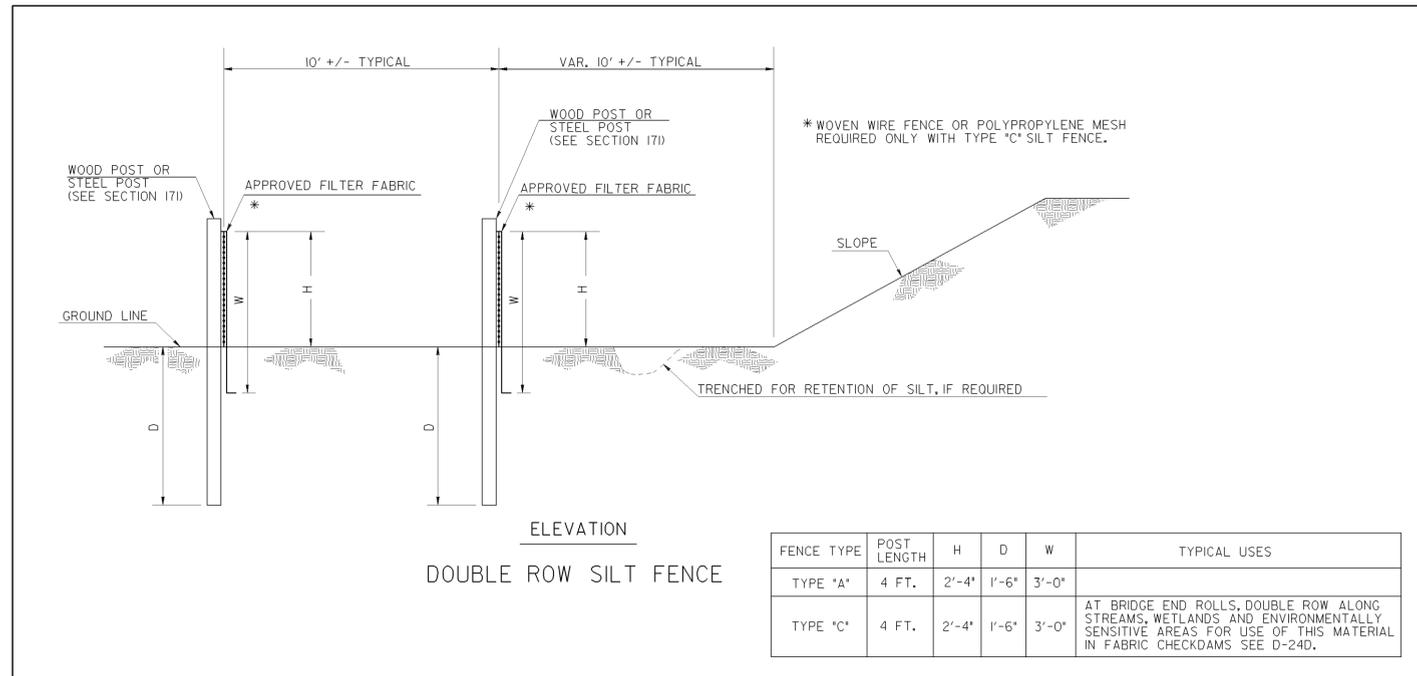

NOTE: TEMPORARY SILT FENCE SHALL NOT BE PLACED WITHIN STATE WATERS.

DATE	DEPARTMENT OF TRANSPORTATION STATE OF GEORGIA
REVISION	CONSTRUCTION DETAILS TEMPORARY SILT FENCE BERM DITCH, INSTALLATION, BRUSH BARRIER
BY	NO SCALE REV. AND REDRAWN JAN. 2011
	NUMBER D-24B (SHEET 2 OF 4)

1/18/2011 2:04:43 PM \\GDOT-DSN\GDOT\DOT\GCF\G0_Xip8000.qcf gowens V:\GAR\Rev. Construction Details\D-24B\D-24B.prf



REVISION	DATE	DESCRIPTION

STATE OF GEORGIA
DEPARTMENT OF TRANSPORTATION
OFFICE: INNOVATIVE PROGRAM DELIVERY

**EROSION CONTROL
CONSTRUCTION DETAILS**

DRAWING No.
56-007