


1/18/2011 9:32:29 AM \\GDOT-DSN\GDOT\GCP\G0_K1p8000.acf gowens V:\GARI\Rev. Construction Details\D-35\0-35.plt 00-RDE

AS-BUILT PLANS 12/12/12

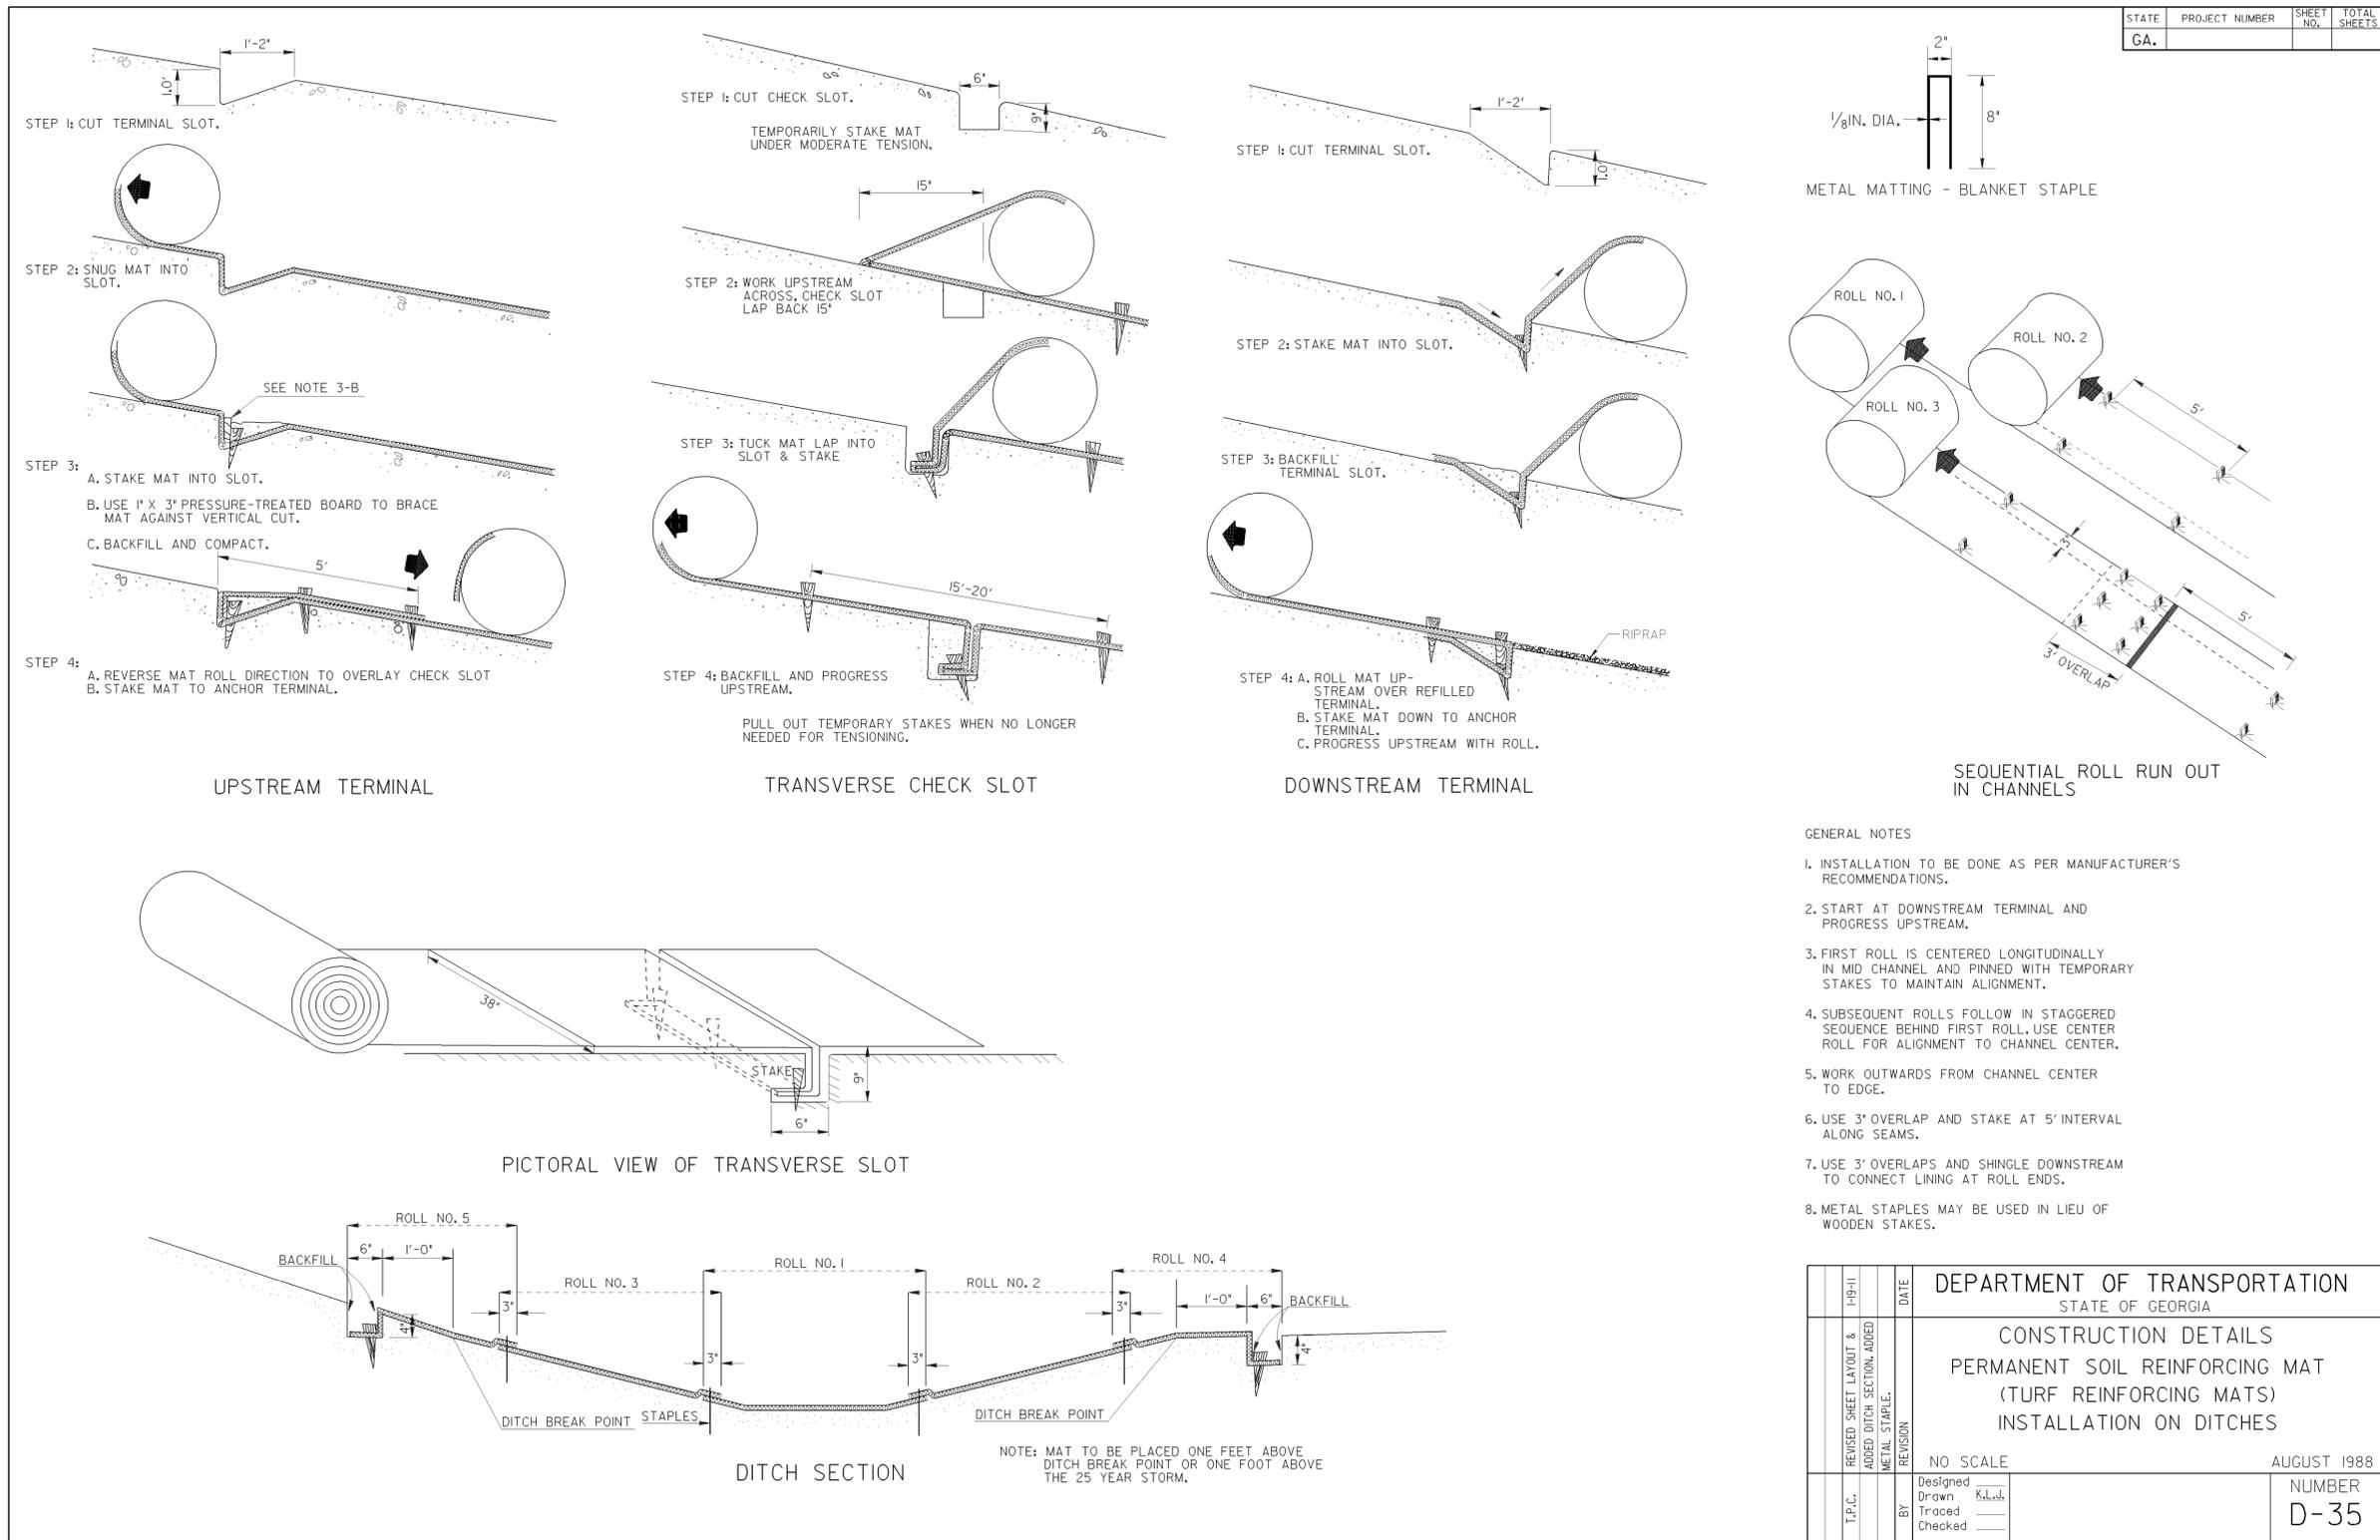

1/18/2011 9:32:29 AM \\GDOT-DSN\GDOT\GCP\G0_K1p8000.acf gowens V:\GARI\Rev. Const Details\D-35\0-35.plt