
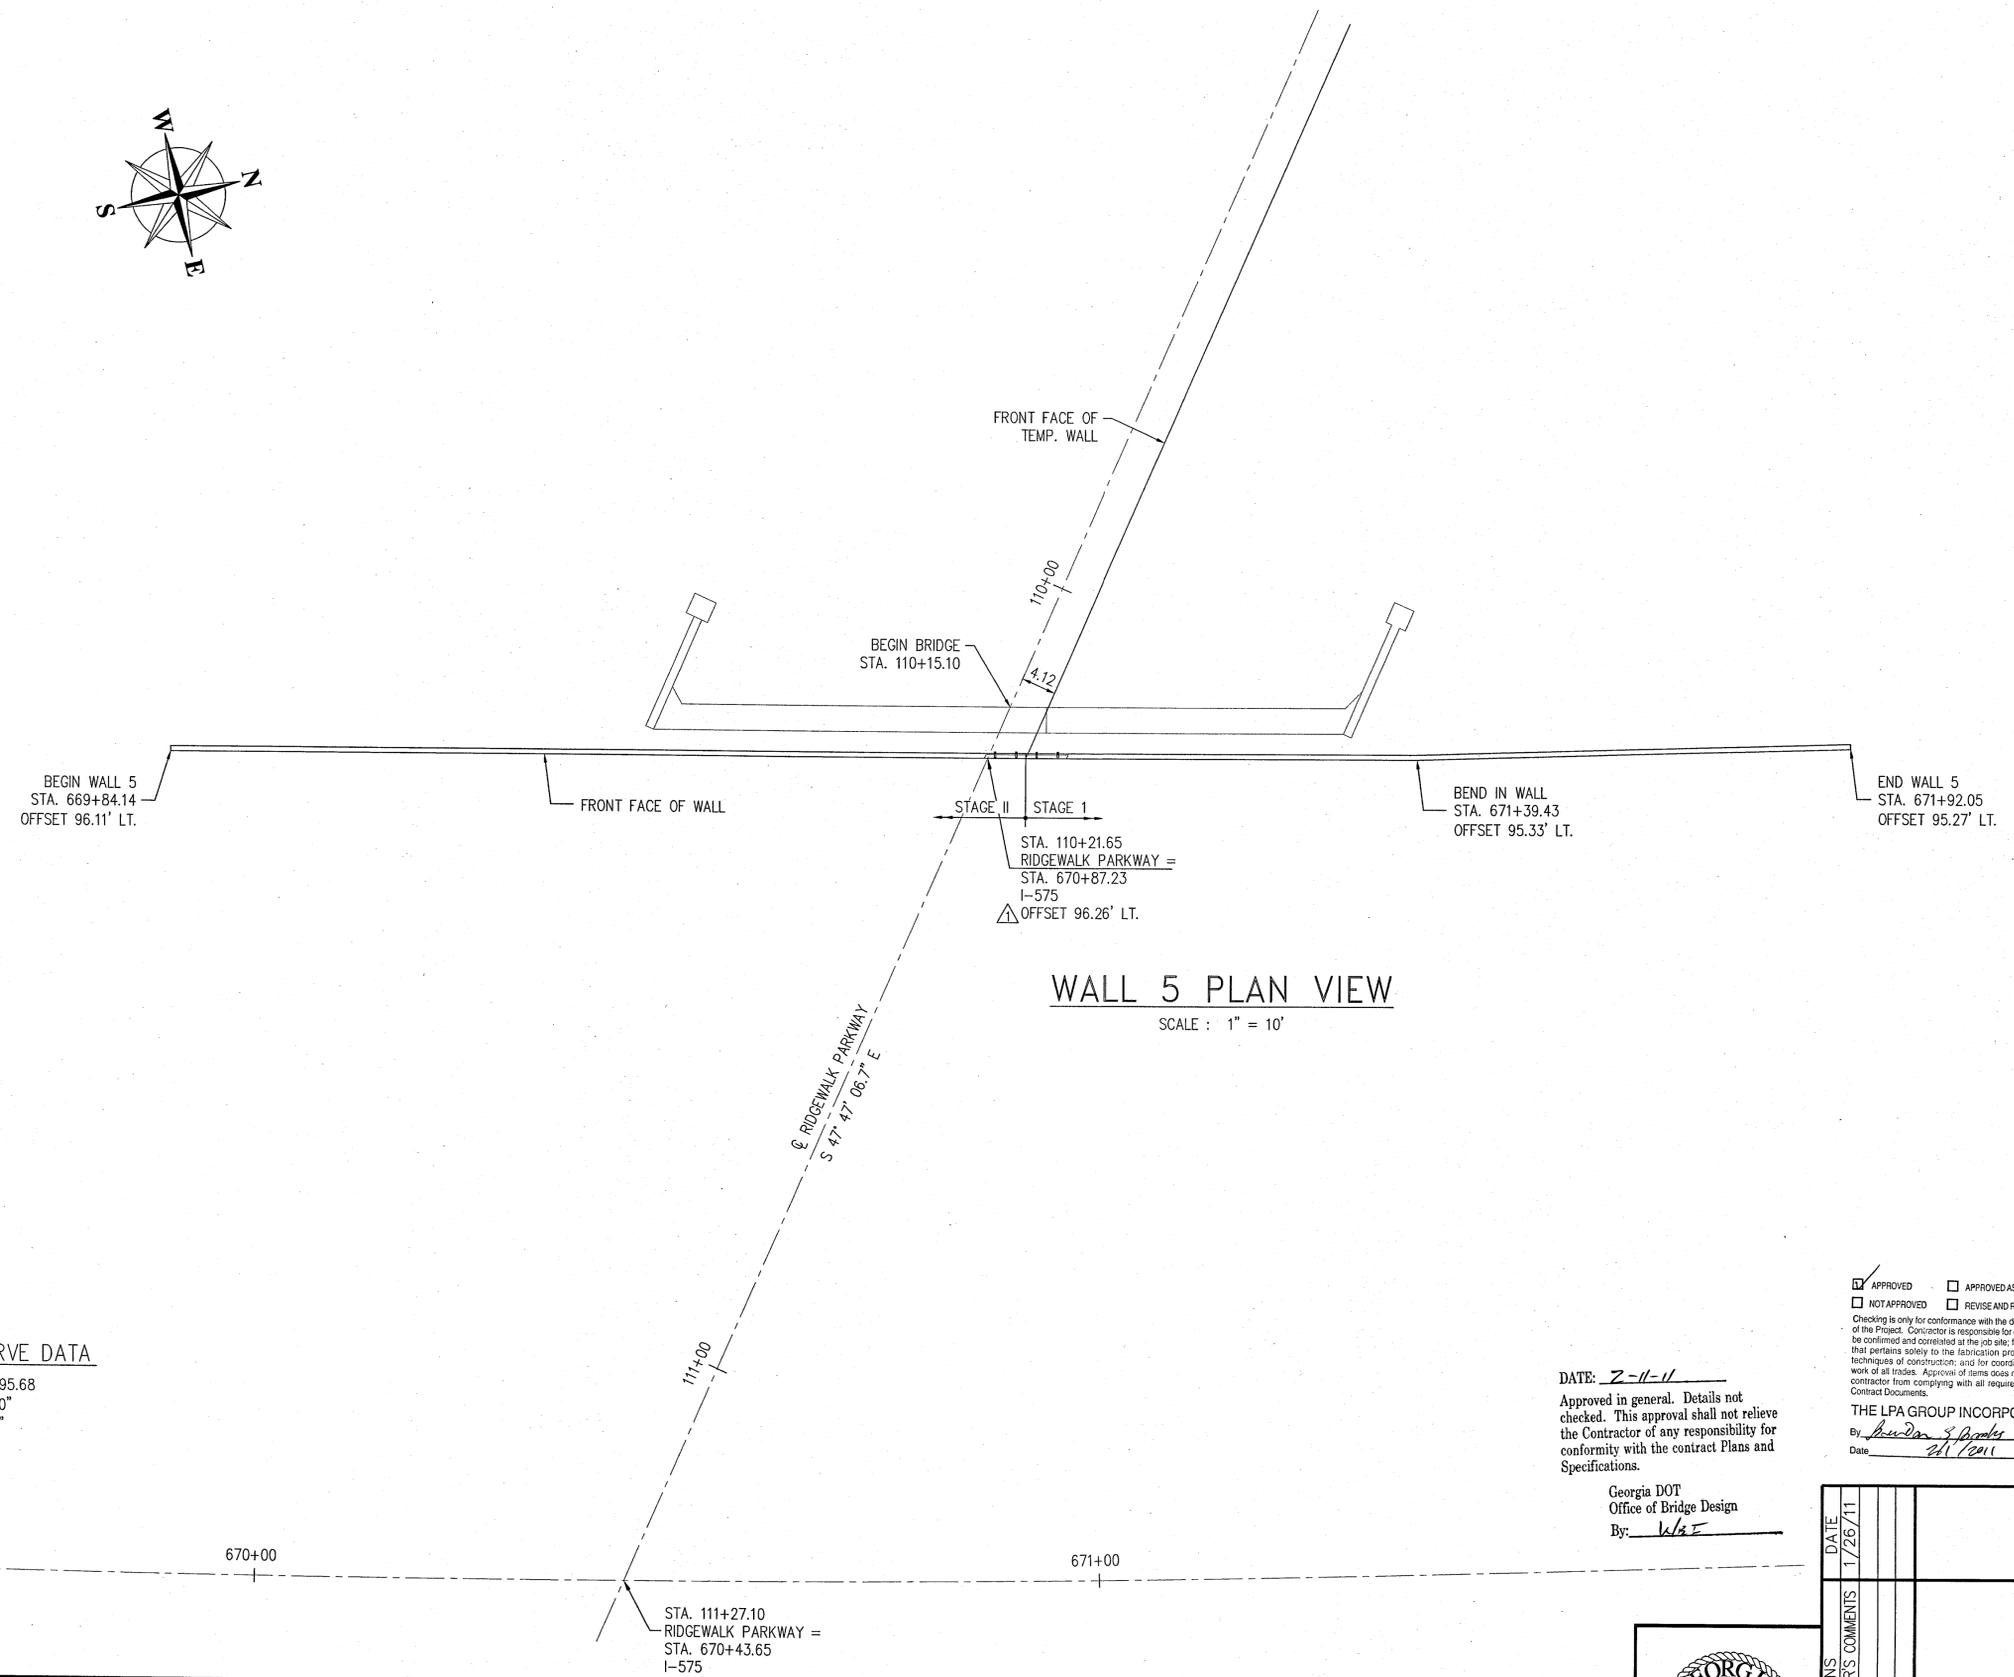


State	Project Number	Sheet No.	Total Sheets
GA	BRST0-0998-00 (001)	---	---

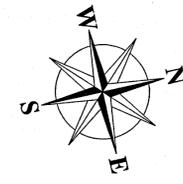

APPROVED     APPROVED AS CORRECTED  
 NOT APPROVED     REVISE AND RESUBMIT  
Checking is only for conformance with the design concept of the Project. Contractor is responsible for dimensions to be confirmed and coordinated at the job site, for information that pertains solely to the fabrication processes or to techniques of construction, and for coordination of the work of all trades. Approval of items does not relieve the contractor from complying with all requirements of the Contract Documents.

THE LPA GROUP INCORPORATED  
 By: *Brandon S. Peoples*  
 Date: *2/1/2011*

- NOTES:**
- OFFSETS ARE TO FRONT FACE OF WALL.
  - FOR WALL ELEVATIONS, SEE SHT. 5.
  - FOR TYPICAL SECTION, SEE SHT. 8.
  - FOR COPING DETAILS, SEE SHT. 8.

DATE: *2-1-11*  
 Approved in general. Details not checked. This approval shall not relieve the Contractor of any responsibility for conformity with the contract Plans and Specifications.  
 Georgia DOT  
 Office of Bridge Design  
 By: *WSE*

GEORGIA DEPARTMENT OF TRANSPORTATION HIGHWAY DIVISION - BRIDGE DESIGN	
RIDGEWALK PARKWAY OVER I-575 CHEROKEE COUNTY	
REINFORCED EARTH RETAINING WALL	
WALL 5 PLAN VIEW	
DESIGNED <i>VG</i> DRAWN <i>LOP</i>	TRACED _____ CHECKED <i>707</i> REVIEWED _____ APPROVED _____

**FINAL FOR REVIEW**  
JAN. 20, 2011



This drawing contains information proprietary to The Reinforced Earth Company, and is being furnished for the use of THE GEORGIA DEPT. OF TRANSPORTATION only in connection with this project, and the information contained is not to be transmitted to any other organization unless specifically authorized in writing by The Reinforced Earth Company. The Reinforced Earth Company is exclusive licensee in the United States under patents issued to Henri Vidal, and the furnishing of this drawing does not constitute an expressed or implied license under the Vidal patents.