



State	Project Number	Sheet No.	Total Sheets
GA	CSHNS-0006-00 (043)	---	---

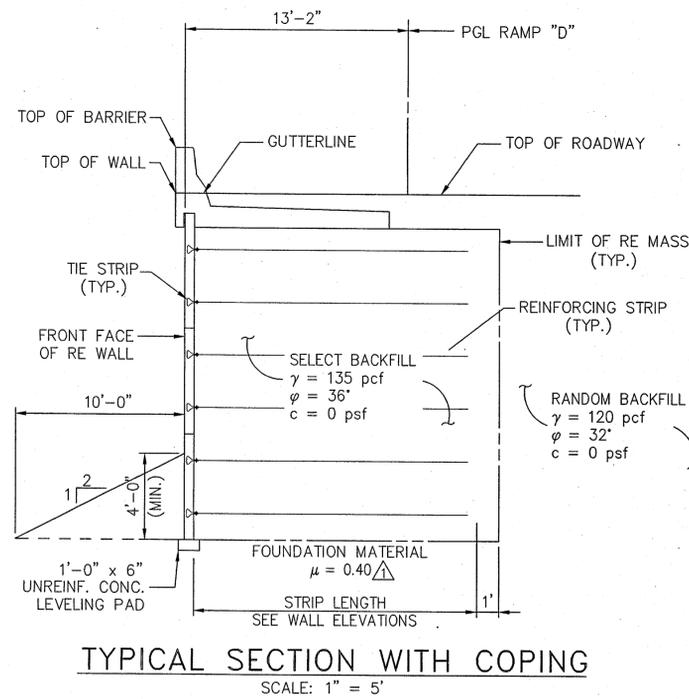


TYPICAL SECTION WITH COPING  
SCALE: 1" = 5'

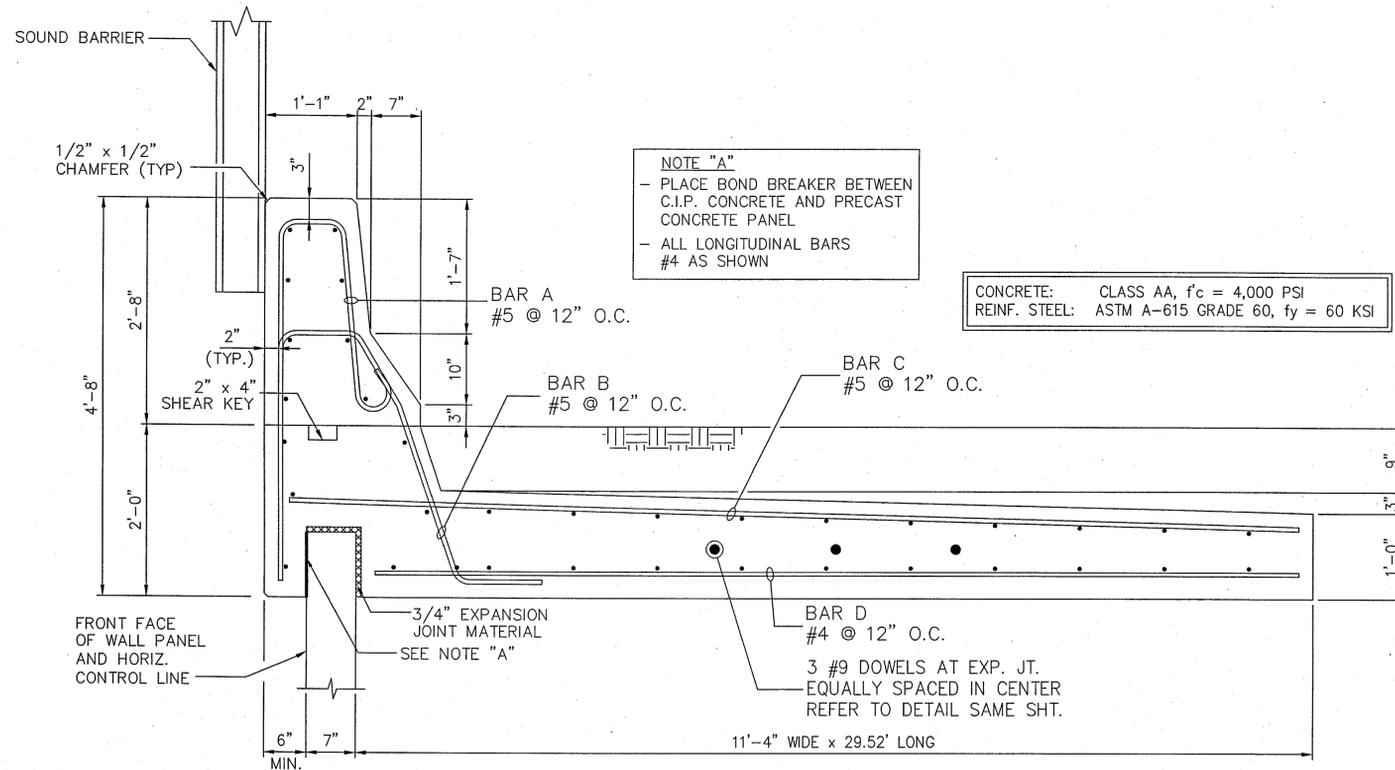

CAST-IN-PLACE BARRIER DETAIL W/ MOMENT SLAB  
SCALE: 1" = 1'-0"


NOTE:  
-ASHLAR STONE FINISH NOT SHOWN FOR CLARITY  
-2" CLR. COVER TO ALL REBAR

CONCRETE: CLASS AA, f<sub>c</sub> = 4,000 PSI  
REINF. STEEL: ASTM A-615 GRADE 60, f<sub>y</sub> = 60 KSI

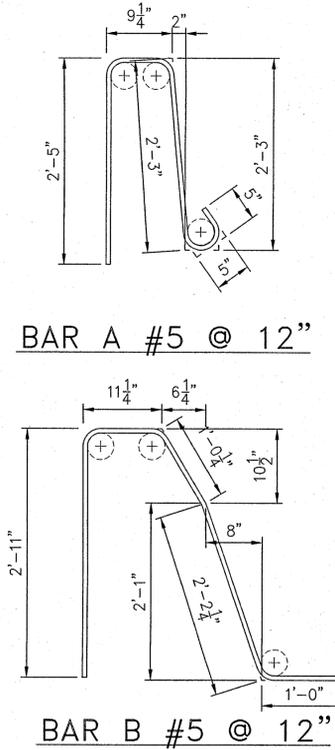


BAR A #5 @ 12"

BAR B #5 @ 12"

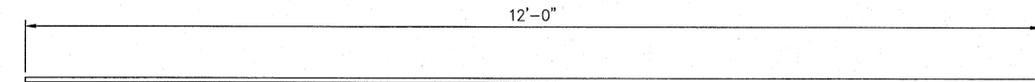

BAR C (#5)

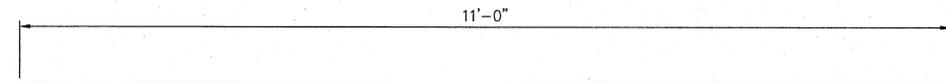

BAR D (#4)


BAR BENDING DETAILS

SCALE: 1" = 1'-0"

APPROVED  
 NOT APPROVED  
 APPROVED AS CORRECTED  
 REVISE AND RESUBMIT  
Checking is only for conformance with the design concept of the Project. Contractor is responsible for dimensions to that pertains solely to the fabrication processes or to work of all trades. Approval of items does not relieve the contractor from complying with all requirements of the Contract Documents.  
THE LPA GROUP INCORPORATED  
By: *[Signature]*  
Date: 2/1/2011


DATE: 2-11-11  
Approved in general. Details not checked. This approval shall not relieve the Contractor of any responsibility for conformity with the contract Plans and Specifications.

Georgia DOT  
Office of Bridge Design  
By: *[Signature]*

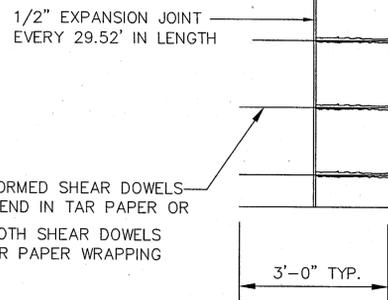

MOMENT SLAB EXPANSION JOINT DETAIL

SCALE: 1" = 1'-0"

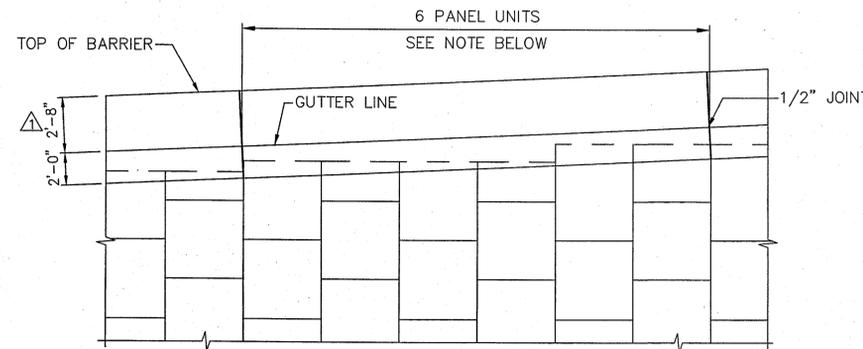

C.I.P. COPING "B" PARTIAL PARTIAL ELEVATION


SCALE: 3/16" = 1'-0"

NOTE:  
JOINTS IN PAVEMENT OR JUNCTION SLAB SHALL COINCIDE WITH JOINTS IN BARRIER

This drawing contains information proprietary to The Reinforced Earth Company, and is being furnished for the use of THE GEORGIA DEPT. OF TRANSPORTATION only in connection with this project, and the information contained is not to be transmitted to any other organization unless specifically authorized in writing by The Reinforced Earth Company. The Reinforced Earth Company is exclusive licensee in the United States under patents issued to Henri Vidal, and the furnishing of this drawing does not constitute an expressed or implied license under the Vidal patents.

FINAL FOR REVIEW  
JAN. 20, 2011

**The Reinforced Earth Company**  
25 Technology Parkway South, Suite 100, Norcross, GA 30092, (770) 242-9415

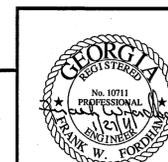

"REINFORCED EARTH" is the registered trademark of The Reinforced Earth Company.

WALL SHEET

DATE	1/26/11	GEORGIA DEPARTMENT OF TRANSPORTATION HIGHWAY DIVISION - BRIDGE DESIGN	
REVISIONS		RIDGEWALK PARKWAY OVER I-575 CHEROKEE COUNTY	
BY	VG	REINFORCED EARTH RETAINING WALL	
REVISOR	VG	TYPICAL SECTION AND BARRIER DETAILS	
DESIGNED	VG	TRACED	REVIEWED
DRAWN	LOP	CHECKED	APPROVED