




State	Project Number	Sheet No.	Total Sheets
GA	CSNHS-0006-00 (043)	---	---

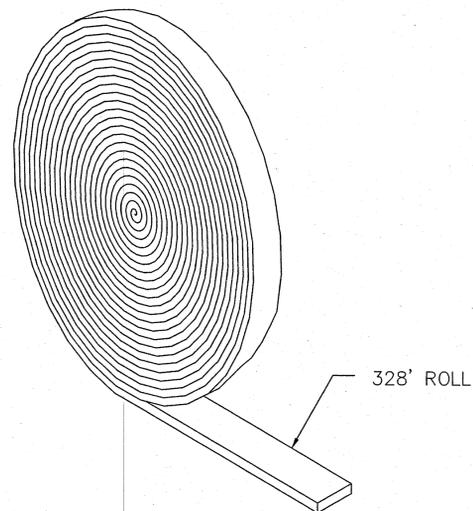


GEOSTRIP

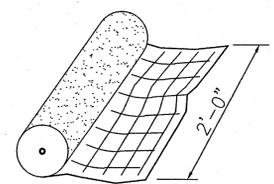


SOIL RETENTION FABRIC
CARTHAGE MILLS 15% WOVEN
FILTER CLOTH OR EQUAL

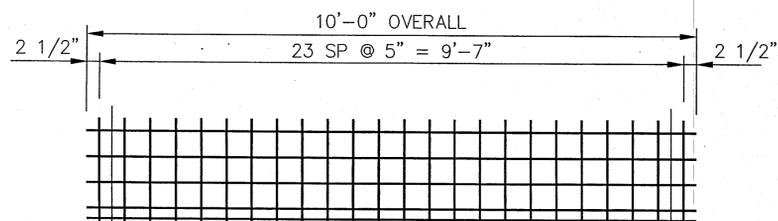

ELEVATION - TYPE "L"
5" x 5" - W5 x W5 WIRE MESH

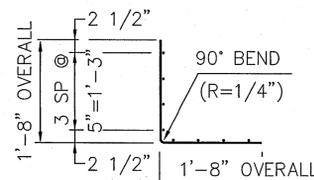

SECTION

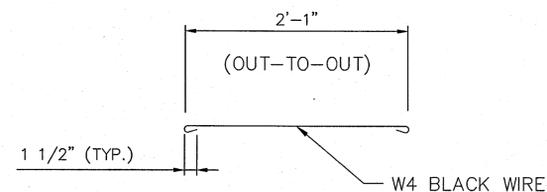

W4 WIRE STRUT

NOTES FOR WIRE FACINGS

- 1) WIRE FACINGS SHALL BE SHOP FABRICATED OF COLD DRAWN STEEL WIRE CONFORMING TO THE MINIMUM REQUIREMENTS OF ASTM A-82 (AASHTO M 32) AND WELDED INTO THE FINISHED CONFIGURATION IN ACCORDANCE WITH ASTM A-185 (AASHTO M55).
- 2) DIMENSIONAL TOLERANCE = $\pm 1/4$ ".
- 3) DESIGN LENGTH = 9'-10"

DATE: 2-11-11
Approved in general. Details not checked. This approval shall not relieve the Contractor of any responsibility for conformity with the contract Plans and Specifications.

Georgia DOT
Office of Bridge Design
By: WEF

APPROVED APPROVED AS CORRECTED
 NOT APPROVED REVISE AND RESUBMIT
Checking is only for conformance with the design concept of the Project. Contractor is responsible for dimensions to be confirmed and corrected at the job site; for information that pertains solely to the fabrication processes or to techniques of construction; and for coordination of the work of all trades. Approval of items does not relieve the contractor from complying with all requirements of the Contract Documents.
THE LPA GROUP INCORPORATED
By: Brandon S. Pender
Date: 2/11/2011

REVISIONS	DATE

GEORGIA DEPARTMENT OF TRANSPORTATION HIGHWAY DIVISION - BRIDGE DESIGN		
RIDGEWALK PARKWAY OVER I-575 CHEROKEE COUNTY		
REINFORCED EARTH RETAINING WALL		
GEOTREL COMPONENTS		
DESIGNED <u>VG</u>	TRACED _____	REVIEWED _____
DRAWN <u>LOP</u>	CHECKED <u>FWF</u>	APPROVED _____

This drawing contains information proprietary to The Reinforced Earth Company, and is being furnished for the use of THE GEORGIA DEPT. OF TRANSPORTATION only in connection with this project, and the information contained is not to be transmitted to any other organization unless specifically authorized in writing by The Reinforced Earth Company. The Reinforced Earth Company is exclusive licensee in the United States under patents issued to Henri Vidal, and the furnishing of this drawing does not constitute an expressed or implied license under the Vidal patents.

FINAL FOR REVIEW
JAN. 20, 2011



PROJECT STATUS

"REINFORCED EARTH" is the registered trademark of The Reinforced Earth Company.

WALL SHEET
OF