



State	Project Number	Sheet No.	Total Sheets
GA	CSNHS-0006-00(043)		

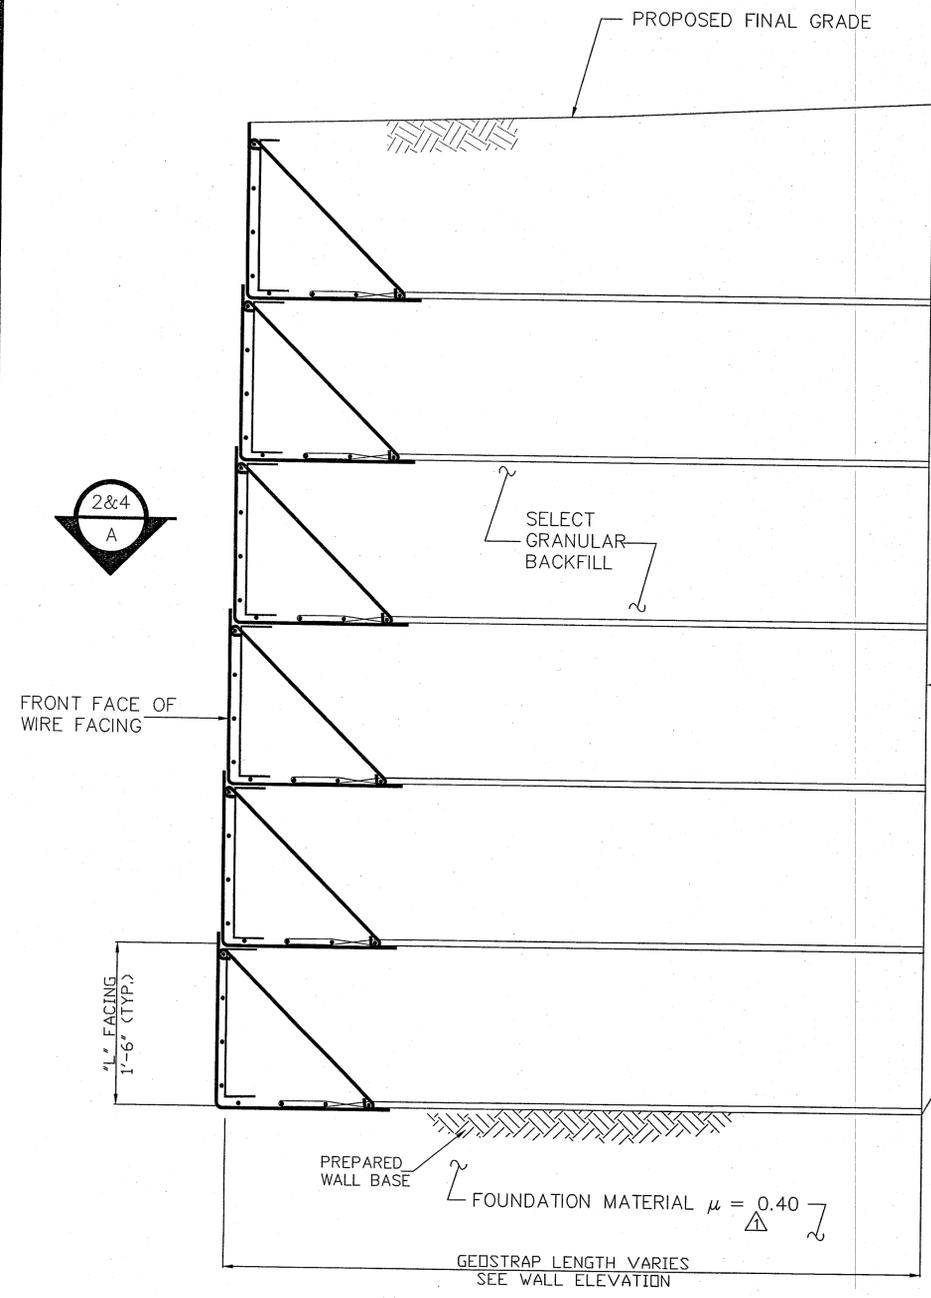

**1 COMPLETED WIRE WALL SECTION**  
NOT TO SCALE


NOTE: SEE DETAIL SHEET "13" FOR THE CONSTRUCTION SEQUENCE.

NOTE:  
USE 1 STRUT/GEOSTRIP AND 1 STRUT/BASKET OVERLAP FOR 4 GEOSTRIPS/BASKET AND LESS.  
USE 2 STRUTS/GEOSTRIP AND 2 STRUTS/BASKET OVERLAP FOR 5 GEOSTRIPS/BASKET AND MORE.

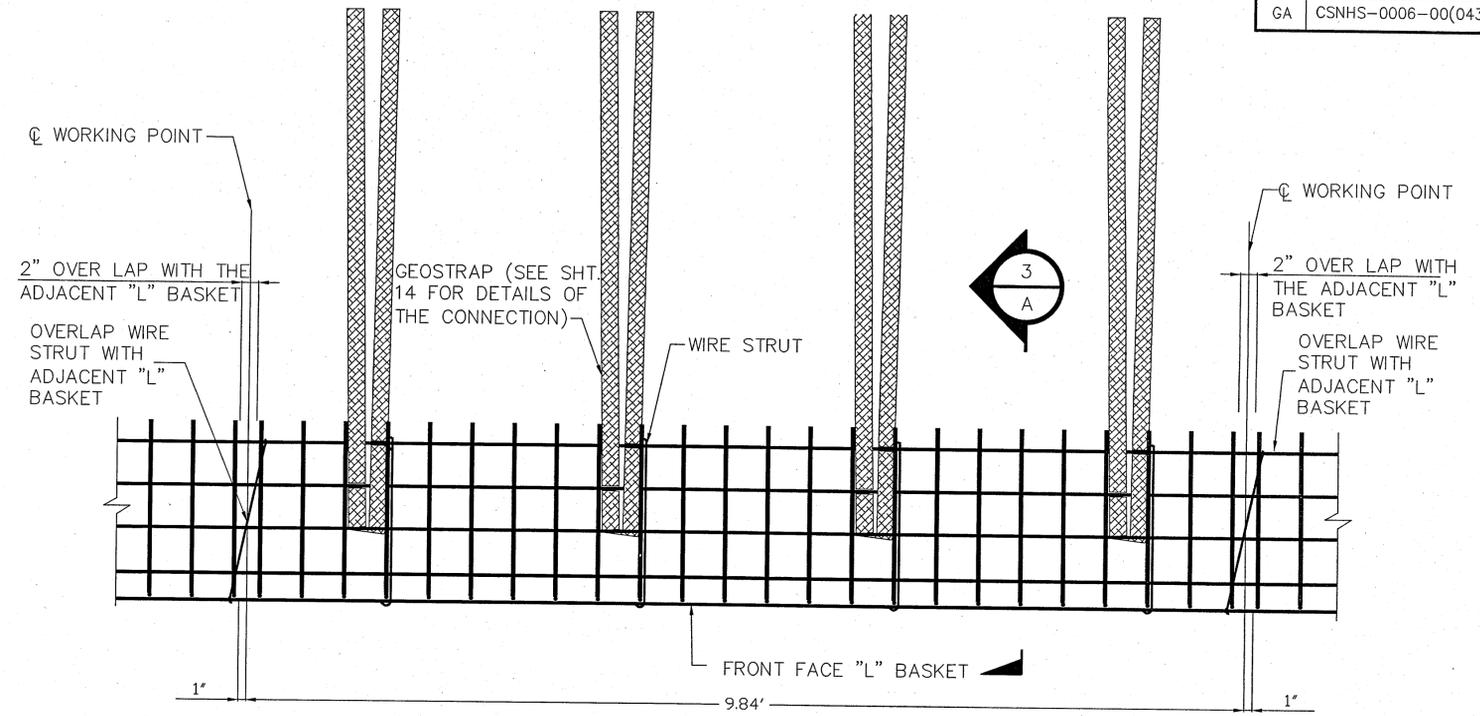


**2 PARTIAL PLAN**  
NOT TO SCALE

NOTE: THIS PLAN SHOWS 1 STRUT/GEOSTRIP AND 4 GEOSTRIPS PER "L" BASKET.  
ATTACH 2 STRUTS/GEOSTRIP FOR "L" BASKETS WITH MORE THAN 4 GEOSTRIPS. REFER TO 14 FOR DETAILS.

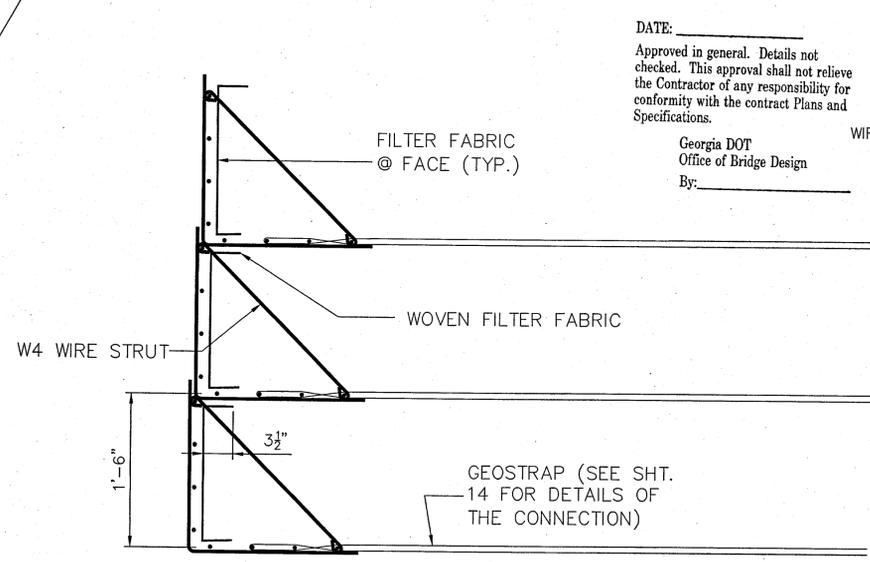

**3 PARTIAL SECTION**  
NOT TO SCALE

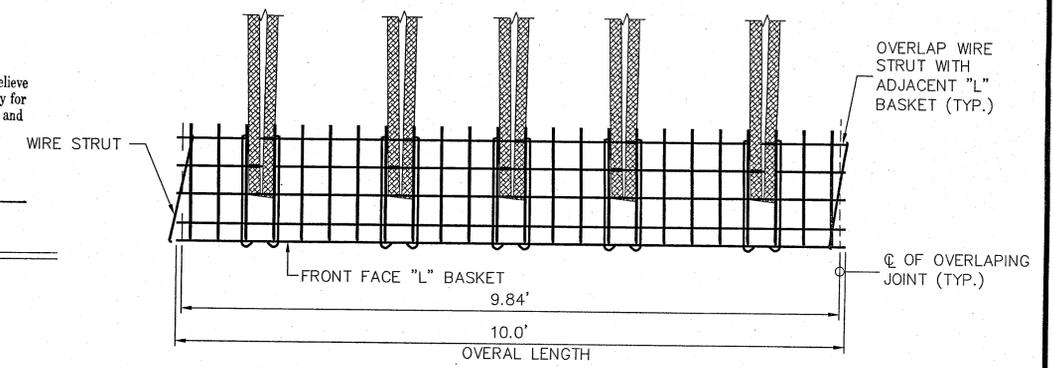

**4 PARTIAL PLAN WITH 5 STRAPS**  
NOT TO SCALE

DATE: \_\_\_\_\_  
Approved in general. Details not checked. This approval shall not relieve the Contractor of any responsibility for conformity with the contract Plans and Specifications.  
Georgia DOT  
Office of Bridge Design  
By: \_\_\_\_\_

APPROVED  REVISED AS CORRECTED  
 NOT APPROVED  REVISE AND RESUBMIT  
Checking is only for conformance with the design concept of the Project. Contractor is responsible for dimensions to be confirmed and correlated at the job site; for information that pertains solely to the fabrication processes or to techniques of construction; and for coordination of the work of all trades. Approval of items does not relieve the contractor from complying with all requirements of the Contract Documents.  
THE LPA GROUP INCORPORATED  
By: *Brandon J. Brink*  
Date: *2/1/2011*

This drawing contains information proprietary to The Reinforced Earth Company, and is being furnished for the use of THE GEORGIA DEPT. OF TRANSPORTATION only in connection with this project, and the information contained is not to be transmitted to any other organization unless specifically authorized in writing by The Reinforced Earth Company. The Reinforced Earth Company is exclusive licensee in the United States under patents issued to Henri Vidal, and the furnishing of this drawing does not constitute an expressed or implied license under the Vidal patents.

**FINAL FOR REVIEW**  
**JAN. 20, 2011**



GEORGIA  
DEPARTMENT OF TRANSPORTATION  
HIGHWAY DIVISION - BRIDGE DESIGN

RIDGEWALK PARKWAY OVER I-575  
CHEROKEE COUNTY

REINFORCED EARTH RETAINING WALL

GEOTREL SECTIONS & DETAILS

PROJECT STATUS

"REINFORCED EARTH" is the registered trademark of The Reinforced Earth Company.

WALL SHEET  
OF

BY	DATE
VG	1/26/11
REVISIONS	
REVISOR	REVISOR'S COMMENTS

DESIGNED	VG	TRACED		REVIEWED	
DRAWN	LOP	CHECKED	TMT	APPROVED	