

12/22/2008
clanz


63732-K1A
AGMENG.1b1

G:\TRA\63732-K1A\rdy\008232CV01-As-Built.dgn

COUNTY	PROJECT NUMBER	SHEET NO.	TOTAL SHEETS
TROUP	CSNHS-0008-00(232)	1A	839

DEPARTMENT OF TRANSPORTATION STATE OF GEORGIA

AS-BUILT PLAN AND PROFILE OF PROPOSED I-85 INTERCHANGE AT CR 98 / GABBETTVILLE ROAD CSNHS-0008-00(232) TROUP COUNTY

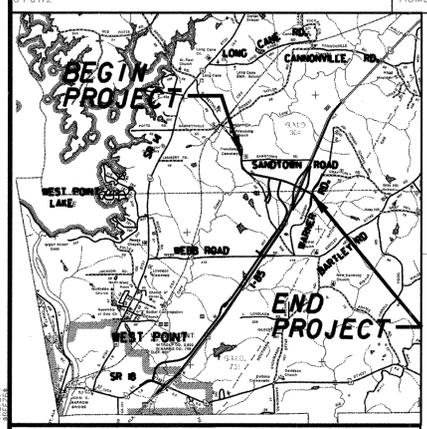


LOCATION SKETCH

NOTE: THE CO-ORDINATES LISTED ARE WEST ZONE GRID CO-ORDINATES BASED ON THE GA. STATE PLANE CO-ORDINATE SYSTEM OF:
HORIZONTAL DATUM : NAD 83/94
VERTICAL DATUM : NAVD 88

MIDPOINT COORDINATE
STATION 142+26.40
N 1067272.7619
E 2004811.8969

FEDERAL AID PROJECT

Georgia D.O.T. P.I. No. 0008232
FEDERAL ROUTE No. N/A
STATE ROUTE No. N/A

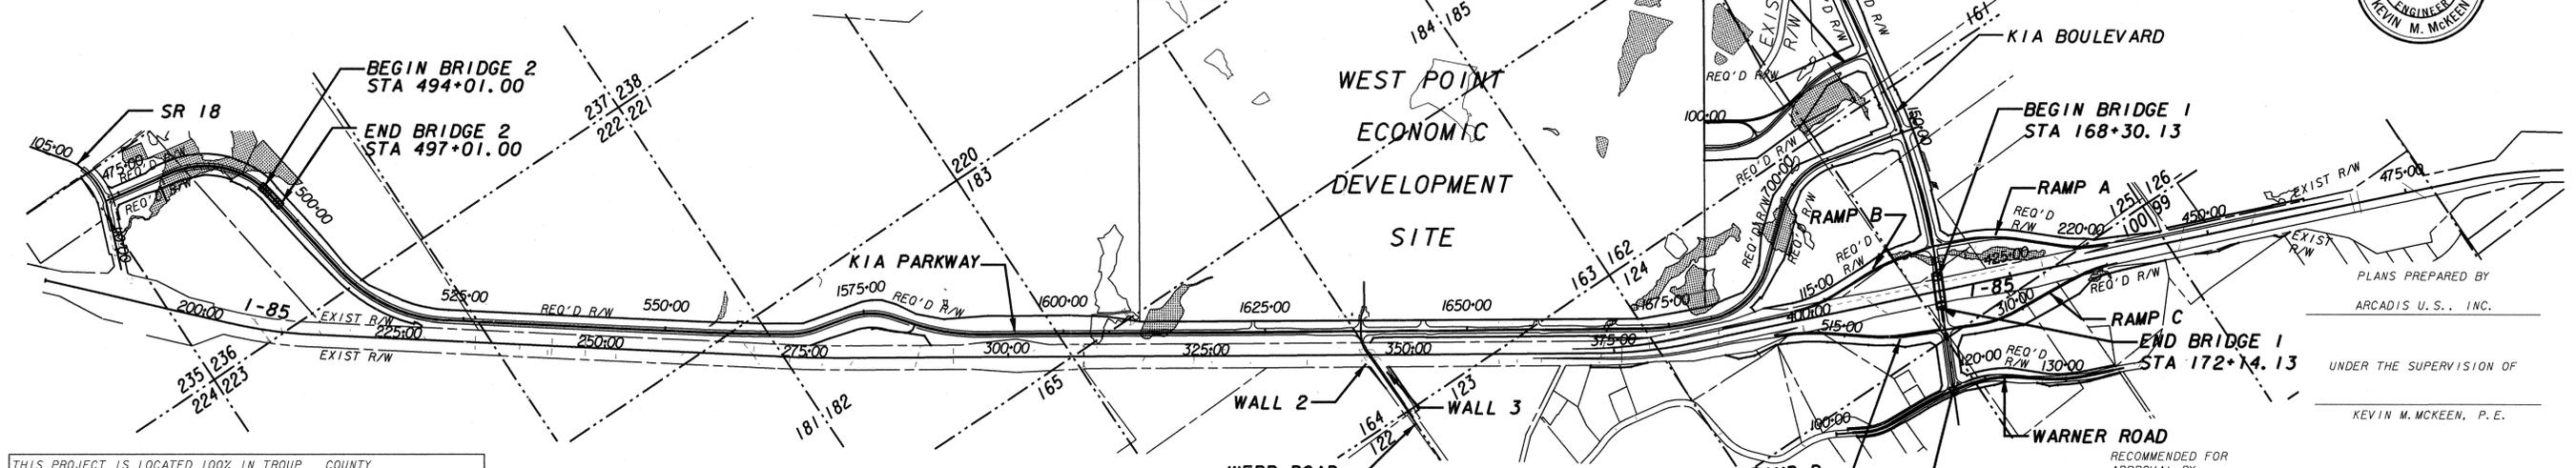

THIS PROJECT IS LOCATED 100% IN TROUP COUNTY AND CONGRESSIONAL DISTRICT 3.
PROJECT DESIGNATION : FULL OVERSIGHT
PDP CLASSIFICATION : MAJOR
FUNCTIONAL CLASSIFICATION : LOCAL COLLECTOR (KIA BLVD) LOCAL ROAD (KIA PKWY)

NOTE: THESE PLANS ARE IN ENGLISH UNITS

NOTES:
ALL REFERENCES IN THIS DOCUMENT, WHICH INCLUDES ALL PAPERS, WRITINGS, DOCUMENTS, DRAWINGS OR PHOTOGRAPHS USED, OR TO BE USED IN CONNECTION WITH THIS DOCUMENT, TO "STATE HIGHWAY DEPARTMENT OF GEORGIA", "STATE HIGHWAY DEPARTMENT", "GEORGIA STATE HIGHWAY DEPARTMENT", "HIGHWAY DEPARTMENT", OR "DEPARTMENT" WHEN THE CONTEXT THEREOF MEANS THE STATE HIGHWAY DEPARTMENT OF GEORGIA MEAN, AND SHALL BE DEEMED TO MEAN THE DEPARTMENT OF TRANSPORTATION.

THE DATA, TOGETHER WITH ALL OTHER INFORMATION SHOWN ON THESE PLANS, OR IN ANY WAY INDICATED THEREBY, WHETHER BY DRAWINGS OR NOTES, OR IN ANY OTHER MANNER, ARE BASED UPON FIELD INVESTIGATIONS AND ARE BELIEVED TO BE INDICATIVE OF ACTUAL CONDITIONS. HOWEVER, THE SAME ARE SHOWN AS INFORMATION ONLY, ARE NOT GUARANTEED, AND DO NOT BIND THE DEPARTMENT OF TRANSPORTATION IN ANY WAY. THE ATTENTION OF THE BIDDER IS SPECIFICALLY DIRECTED TO ARTICLES 102.04, 102.05, AND 104.03 OF THE SPECIFICATIONS OF THE DEPARTMENT OF TRANSPORTATION, STATE OF GEORGIA, FOR THE CONSTRUCTION OF TRANSPORTATION SYSTEMS, CURRENT EDITION, AND ANY MODIFICATIONS THEREOF, WHICH WILL BE A PART OF THIS CONTRACT.


ALL WORK TO BE DONE IN ACCORDANCE WITH THE SPECIFICATIONS OF THE DEPARTMENT OF TRANSPORTATION OF GEORGIA, CURRENT EDITION, AS APPROVED BY THE FEDERAL HIGHWAY ADMINISTRATION.



COUNTY NO. 285	KIA BLVD	KIA PKWY
LENGTH OF PROJECT	MILES	MILES
PI NO 0008232-TROUP COUNTY		
NET LENGTH OF ROADWAY	1.452	4.526
NET LENGTH OF BRIDGES	0.073	0.057
NET LENGTH OF PROJECT	1.525	4.583
NET LENGTH OF EXCEPTIONS	0.000	0.000
GROSS LENGTH OF PROJECT	1.525	4.583

DESIGN DATA	KIA BLVD	KIA PKWY
TRAFFIC A.D.T.:	14,200 (2009)	14,000 (2009)
TRAFFIC A.D.T.:	27,900 (2029)	20,300 (2029)
TRAFFIC D.H.V.:	3530 (2029)	2530 (2029)
DIRECTIONAL DIST.:	46%/54% WB/EB	56%/44% SB/NB
% TRUCKS:	8.0%	8.0%
% 24 HR. TRUCKS:	10.0%	10.0%
SPEED DESIGN:	45 MPH	45 MPH

END PROJECT
CSNHS-0008-00(232)
STA 182+52.79

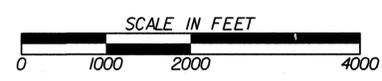

PLANS PREPARED BY
ARCADIS U.S., INC.
UNDER THE SUPERVISION OF
KEVIN M. MCKEEN, P.E.
RECOMMENDED FOR APPROVAL BY: _____
STATE URBAN DESIGN ENGINEER

DATE _____ CHIEF ENGINEER
LOCATION AND DESIGN APPROVAL DATE: MARCH 8, 2007
PLANS COMPLETED DATE: SEPTEMBER 9, 2007
REVISION DATES:

AS-BUILT

PLAN DATE: 09-07-07