


STATE	PROJECT NUMBER	SHEET NO.	TOTAL SHEETS
GA.		655	831

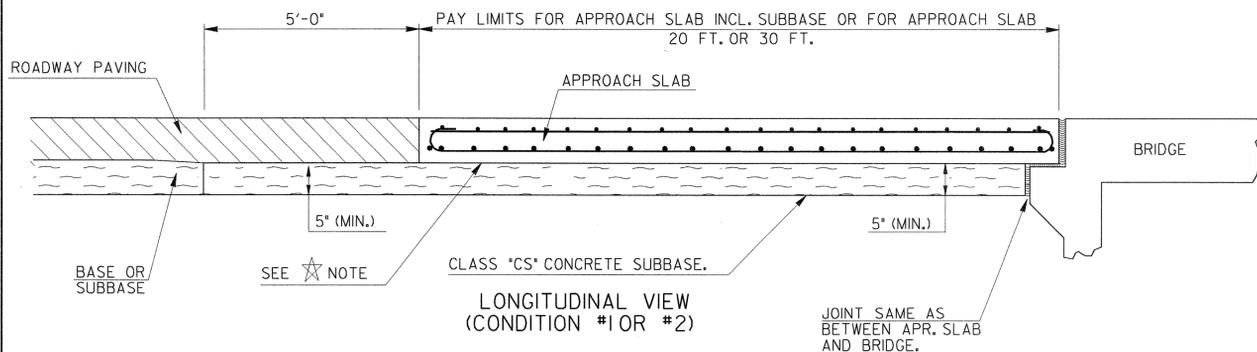


"C"	CUBIC YARDS OF SUBBASE FOR APPROACH SLAB			
	STD. 9017K	STD. 9017L	STD. 9017P	STD. 9017Q
28'-0"	15.63	11.08		
29'-6"			16.47	11.67
30'-0"				
31'-6"			17.54	12.43
32'-0"	17.75	12.58		
33'-6"			18.60	13.18
34'-0"				
35'-6"			19.67	13.94
36'-0"	19.87	14.08		
37'-6"			20.74	14.70
38'-0"				
39'-6"			21.81	15.46
40'-0"	21.99	15.59		
41'-6"			22.88	16.21
42'-0"	23.05	16.34		
43'-6"			23.94	16.97
44'-0"				
45'-6"			25.01	17.73
46'-0"		17.84		
47'-6"			26.08	
48'-0"	26.23	18.59		
49'-6"			27.15	
50'-0"				
51'-6"			28.22	
52'-0"	28.35			
53'-6"			29.29	
54'-0"				
55'-6"			30.35	
56'-0"				
57'-6"			31.42	
58'-0"	31.53			
59'-6"			32.49	
60'-0"	32.59			
61'-6"			33.56	
62'-0"	33.65			
63'-6"			34.63	
64'-0"	34.71			
65'-6"			35.70	
66'-0"	35.77			

⊗ QUANTITIES GIVEN IN THE TABLE ARE BASED UPON MINIMUM DIMENSIONS AND ARE GIVEN FOR INFORMATION ONLY.


CUBIC YARDS OF SUBBASE FOR USE WITH STD. 9017M, STD. 9017N OR FOR USE WITH SLAB SIZES NOT GIVEN IN TABLE, MAY BE ESTIMATED WITH THE FOLLOWING FORMULAE:

FOR 30' APPROACH SLABS:
CU. YARDS = 0.5298 TIMES SLAB WIDTH (IN FEET)

FOR 20' APPROACH SLABS:
CUBIC YARDS = 0.3755 TIMES SLAB WIDTH (IN FEET)

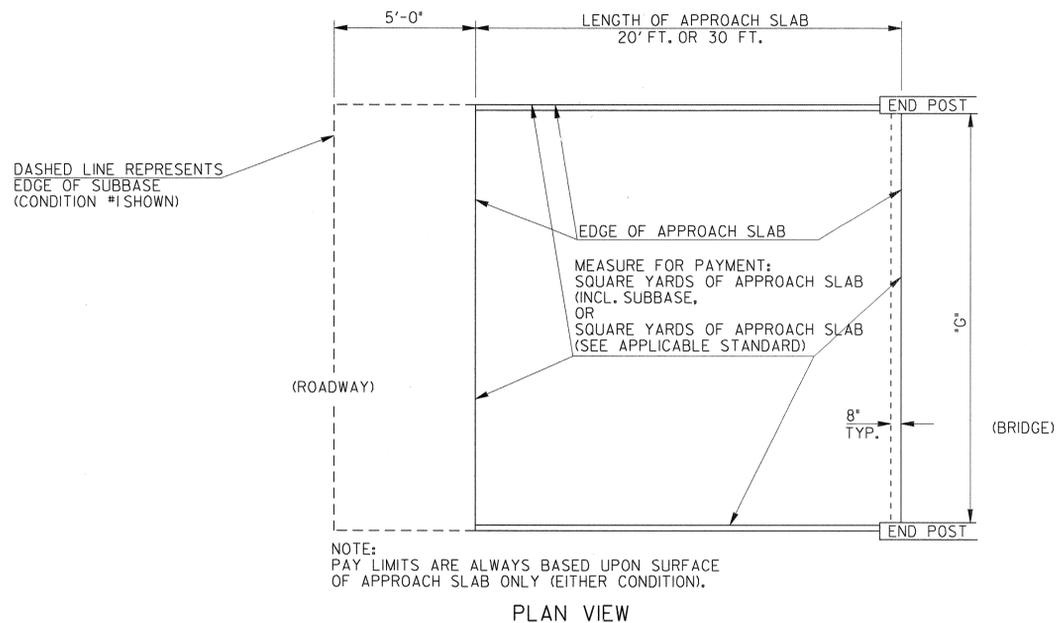



NOTE: PAY LIMITS ARE ALWAYS BASED UPON SURFACE OF APPROACH SLAB ONLY (EITHER CONDITION).

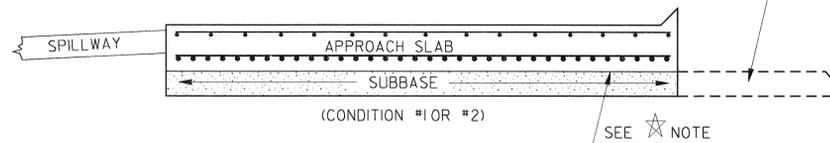

IF MAT'L UNDER APPROACH SLAB IS FLEXIBLE ENOUGH TO ALLOW DRIVING OF GUARDRAIL POST, THE LIMITS SHALL BE EXTENDED SIMILARLY TO THAT ON THE ROADWAY.

★ NOTE: IF 'CS' CONCRETE OR P.C. CONC. SUBBASE IS USED, CLEAR POLYETHYLENE SHEETING 8 MILS. MIN. THICKNESS, WITH A 6" OVERLAP, UNIFORMLY LAYED, SHALL BE REQUIRED UNDER THE APPROACH SLAB TO PREVENT BONDING POLYETHYLENE SHEETING SHALL BE NEW, UNUSED AND FREE OF HOLES, RIPS AND TEARS.

NOTE: SUBBASE SHOWN ABOVE FOR APPROACH SLAB WITH SPILLWAY ON ONE SIDE AND SLOPED EDGE ON OTHER SIDE. SUBBASE DETAILS SIMILAR FOR APPROACH SLAB WITH TRANSITION CURB OR OTHER DRAINAGE STRUCTURES.

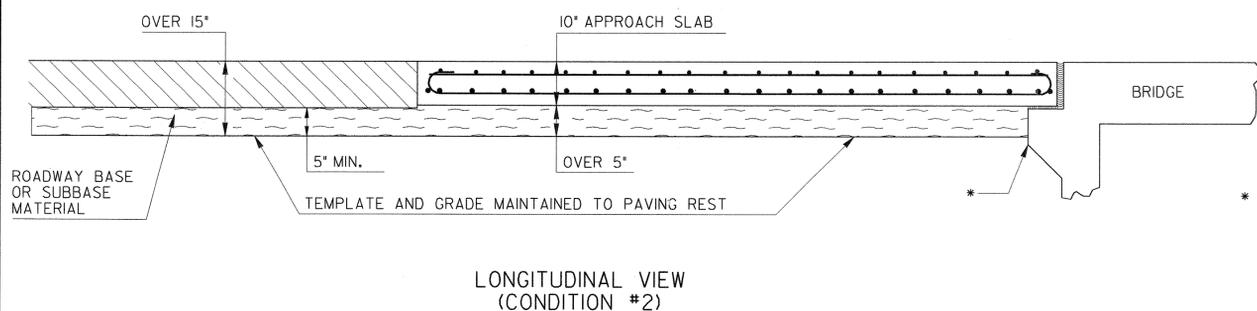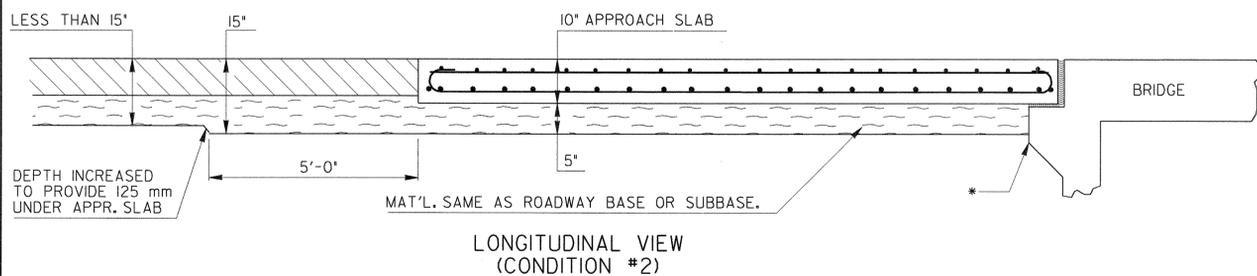

CONDITION #1:
WHERE THE CONTRACT FOR THE BRIDGE AND APPROACH SLABS IS LET SEPARATE FROM THE ROADWAY PAVING CONTRACT, THE SUBBASE FOR THE APPROACH SLAB WILL BE CLASS 'CS' CONCRETE ACCORDING TO SECTION 500. IN THIS CASE, PAYMENT FOR THE SUBBASE WILL BE INCLUDED IN THE PAYMENT FOR THE APPROACH SLAB.

CONDITION #2:
WHERE THE ROADWAY PAVING AND THE BRIDGE ARE LET UNDER THE SAME CONTRACT, THE APPROACH SLAB SUBBASE MAY BE EITHER CLASS 'CS' CONCRETE OR MAY BE THE SAME MATERIAL AS REQUIRED FOR THE ROADWAY BASE OR SUBBASE SUCH AS GRADED AGGREGATE, P.C. CONC. SUBBASE, ETC. IN THIS CASE, PAYMENT FOR THE SUBBASE WILL BE INCLUDED IN THE PAYMENT FOR THE APPROACH SLAB.

* EXPANSION JOINT REQ'D. SAME AS BETWEEN APPROACH SLAB & BRIDGE, IF SUBBASE IS PORTLAND CEMENT CONCRETE OR CLASS 'CS' CONCRETE.

REVISED NOTES		DATE		DEPARTMENT OF TRANSPORTATION	
3-28-06		6-14-88		STATE OF GEORGIA	
PAY ITEM - COND. #2		REVISION		CONSTRUCTION DETAIL	
BY		NO SCALE		SUBBASES FOR APPROACH SLABS	
G.L.O.		REV. & REDRAWN OCT. 1985		NUMBER	
				M-2	

AS-BUILT