



GENERAL NOTES:

1. SPECIFICATIONS: GEORGIA STANDARD, CURRENT EDITION, & SUPPLEMENTS THERETO.
2. THIS PLAN IS NOT COMPLETE IN ITSELF-FOR GENERAL NOTES, DETAILS AND DIMENSIONS NOT SHOWN SEE GEORGIA STANDARD NO. 2321 FOR SINGLE CULVERTS AND GEORGIA STANDARD NO. 2325 FOR DOUBLE AND TRIPLE CULVERTS.
3. CHAMFER - CHAMFER ALL EXPOSED EDGES $\frac{3}{4}$ ".
4. CONCRETE APRONS (SEPARATE STANDARD) ARE REQUIRED AT ALL OUTLETS. THE ENGINEER MAY ALLOW AN EXCEPTION FOR THE BED ROCK CONDITIONS. TOEWALLS UNDER PARAPETS MAY BE MODIFIED AT OUTLETS AS SHOWN ON STANDARD DETAIL FOR CONCRETE APRONS.
5. QUANTITIES FOR STEEL SHOWN ARE COMPUTED CONSIDERING ALL A,B,C,D,G AND H BARS AS PART OF BARREL QUANTITIES. STEEL PER LIN. FT. IS AN AVERAGE VALUE FOR A CULVERT OF 40' LENGTH ALLOWING ONE LAP IN LONGITUDINAL BARS.
6. PARAPETS AT INLETS SHALL BE CONSTRUCTED WITH A 4"/45° BEVEL.
7. COVER-CULVERT TO HAVE MINIMUM OF 1.0' BELOW BOTTOM OF BASE OR CONCRETE PAVEMENT.

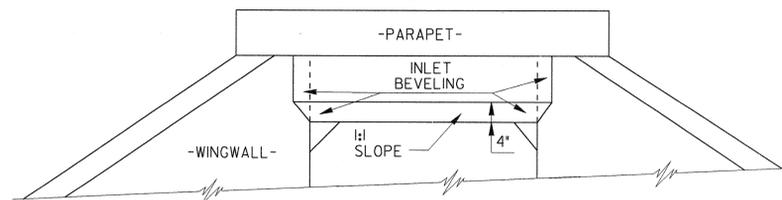

NOTE: INLET BEVELING IS REQUIRED AT THE INLET OF ALL BOX CULVERTS EXTENDING FROM WINGWALL TO WINGWALL, AT TOP OF CULVERT AS SHOWN.

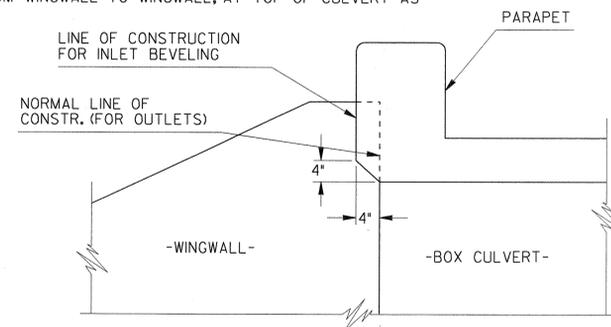

INLET BEVELING DETAIL

BOX CULVERT REQUIREMENTS:

MINIMUM FILL HEIGHT FROM TOP OF CULVERT TO BOTTOM OF BASE WITHIN TRAVELWAY SHALL BE 12 INCHES.

MAXIMUM POUR LENGTH SHALL NOT EXCEED 30 FEET ALONG THE LENGTH OF THE CULVERT.

TRANSVERSE CONSTRUCTION JOINTS SHALL BE PLACED IN THE BARREL, NORMAL TO THE CENTERLINE OF CULVERT, AT THE OUTSIDE SHOULDER BREAK POINTS. LONGITUDINAL BARREL REINFORCING STEEL SHALL NOT BE CONTINUOUS THROUGH THESE JOINTS, PROVIDED THAT THE JOINTS ARE MORE THAN 15 FEET FROM THE BARREL ENDS.

WHEN TRANSVERSE CONSTRUCTION JOINTS OCCUR WITHIN 15 FEET OF THE BARREL ENDS OR WITHIN THE LIMITS OF THE PAVEMENT, THE LONGITUDINAL BARREL REINFORCING SHALL THEN BE CONTINUOUS THROUGH SUCH JOINTS. THE MINIMUM LENGTH OF LAP SPLICE FOR LONGITUDINAL REINFORCING SHALL BE 24 INCHES.

TRANSVERSE CONSTRUCTION JOINTS PLACED AT ANY OTHER LOCATION NOT SPECIFIED ABOVE SHALL BE FORMED WITH NO LONGITUDINAL REINFORCING STEEL PASSING THROUGH THE JOINTS.

DATE		DEPARTMENT OF TRANSPORTATION STATE OF GEORGIA	
REVISION		STANDARD REINFORCED CONCRETE BOX CULVERTS SINGLE 3' X 2' TO TRIPLE 6' X 6' FOR 75°, 60°, AND 45° SKEWS	
NO SCALE		REV. & REDR. NOV., 2001	
BY	DESIGNED	(SUBMITTED)	NUMBER
	REDRAWN	STATE ROAD & AIRPORT DESIGN ENGINEER	2328
	TRACED	(APPROVED)	SHEET 3 OF 3
	CHECKED	CHIEF ENGINEER	

AS-BUILT