


DETAIL FOR PLUGGING DRILLED WELL

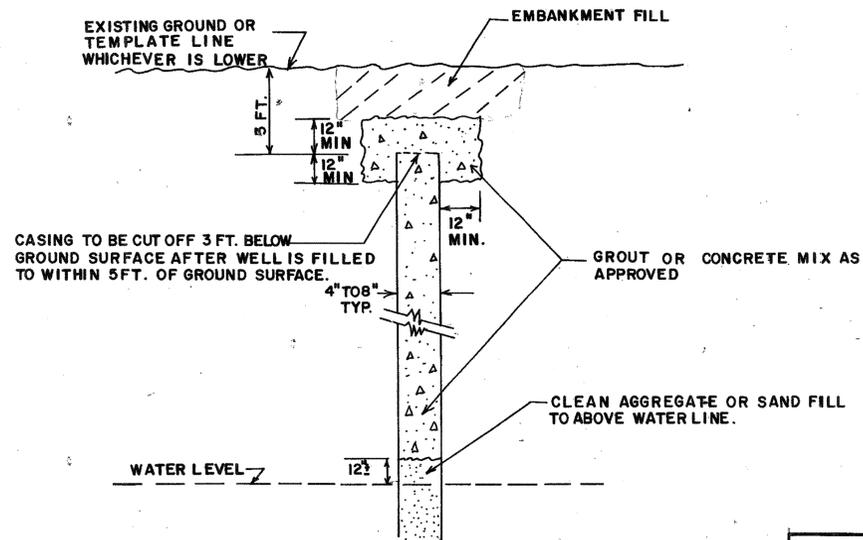


NOTES:
 ALL ABANDONED WELLS WITHIN THE RIGHT OF WAY OR CONSTRUCTION EASEMENTS SHALL BE PLUGGED BEFORE ANY OTHER ACTIVITY BEGINS.
 ALL COSTS FOR FILLING AND PLUGGING WELLS SHALL BE INCLUDED IN PAYMENT FOR OTHER ITEMS.

DETAIL OF CONCRETE SLAB WELL COVER


NOTE: ALL ABANDONED WELLS WITHIN THE R/W AND CONSTRUCTION EASEMENTS SHALL BE FILLED.

NOTE: DETAILS SHOWN ARE APPLICABLE FOR TYPICAL SIZE DUG WELLS, IF WELL OPENING IS TOO LARGE TO ALLOW 1 FT. MIN. BEARING AREA, ALL AROUND THE SLAB SIZE SHALL BE INCREASED PER PLANS OR AS DIRECTED BY ENGINEER.

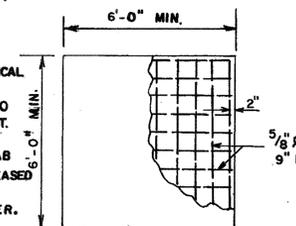

TYPICAL QUANTITIES:
 * CU. YDS. CL. A CONC. - 0.89
 * LBS. BAR REINF. STEEL - 107
 * CU. YDS. EMBANKMENT - VARIES

* ALL COSTS FOR FILLING & COVERING WELL SHALL BE INCLUDED IN PAYMENT FOR OTHER ITEMS.

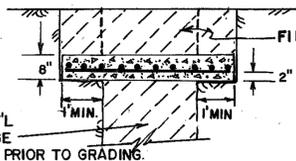


NOTE: CONCRETE SLAB REST OVER WELL SHALL BE PLACED TO A MINIMUM DEPTH OF 2'-6" BELOW SUBGRADE

CLAY OR OTHER IMPERVIOUS MAT'L PACKED IN LARGE DIAMETER WELL PRIOR TO GRADING.

CONCRETE SLAB SHALL BE CENTERED OVER WELL.

DETAIL OF TURNOUTS - RURAL

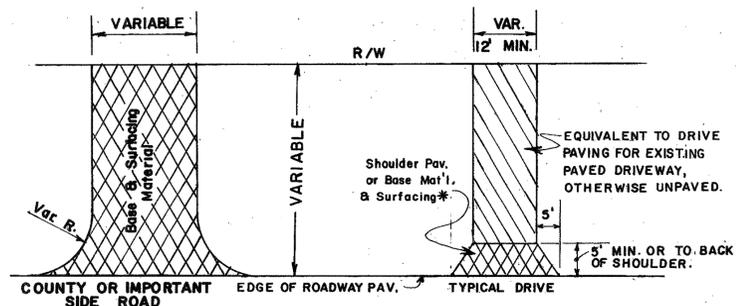


All turnouts are to be constructed as directed by the Engineer.

In general, 30' radii are to be used for County Roads and may be increased up to 50' on important County Roads where necessary to take care of turning movements.

* Driveway Paving may be omitted on lower class Roads.

STATIONING OF CONCRETE PAVEMENT

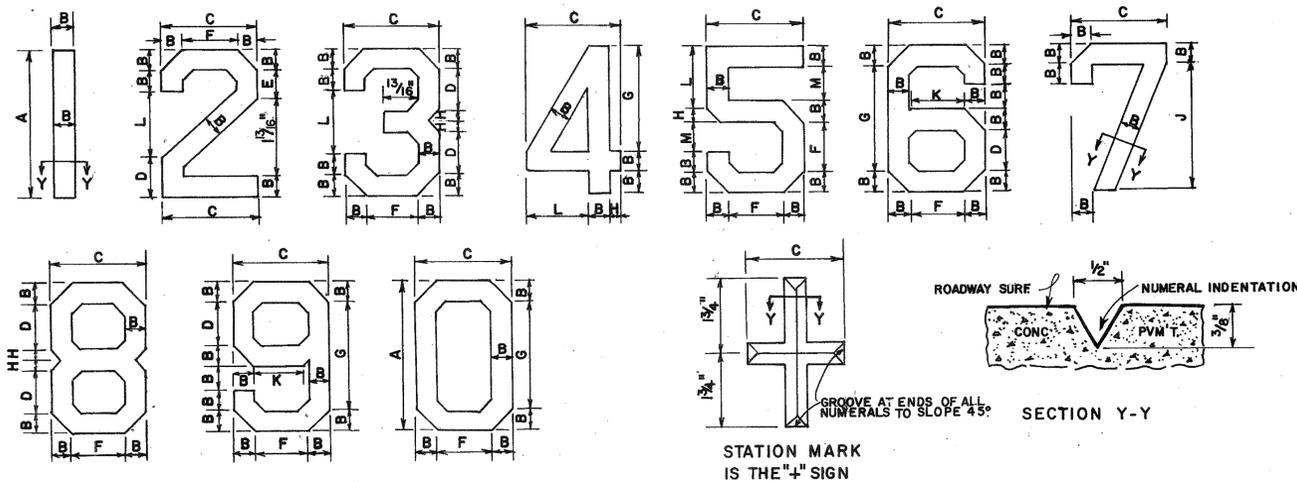


DIMENSIONS FOR NUMERALS (Inches)											
A	B	C	D	E	F	G	H	J	K	L	M
3 1/2	1/2	2 1/4	1	1 1/16	1 1/4	2 1/2	1/4	3	1 1/8	1 1/2	3/4

DETAILS OF NUMERALS AND STATION MARK "+"

NOTE: Every fifth station shall be stamped in concrete pavement with dies just before the initial set.

Undivided Highways - Stationing shall be placed within a one foot strip along the edge of pavement, right of the \mathcal{C} .

Divided Highways - Stationing shall be placed within a one foot strip along the outer edge of pavement, right and left of the \mathcal{C} .

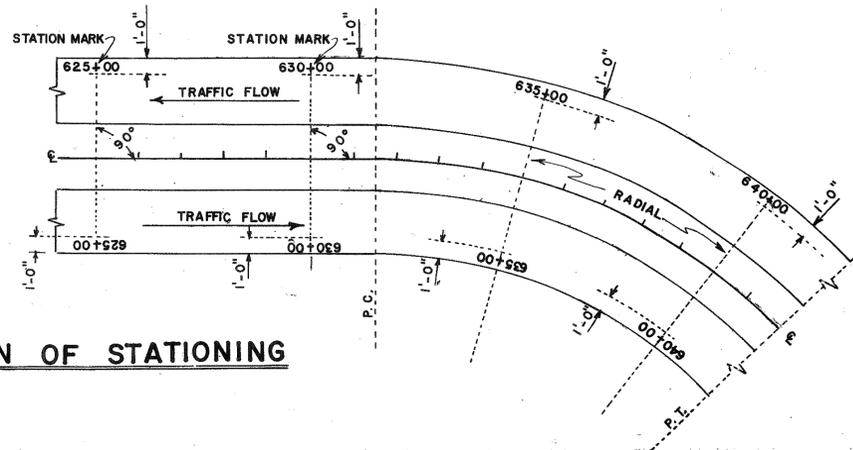

PLAN OF STATIONING

DEPARTMENT OF TRANSPORTATION
 STATE OF GEORGIA

STANDARD
 DETAIL FOR PLUGGING DRILLED WELL
 STATIONING OF CONCRETE PAVEMENT
 CONCRETE SLAB WELL COVER
 DETAIL OF TURNOUTS-RURAL

NO SCALE REV. & REDR. NOVEMBER, 1979

DES. DEC. 57 (SUBMITTED) *Ray B. Beck*
 RETRACED STATE ROAD & AIRPORT DESIGN ENGR.
 G.M.E. (APPROVED) *Thomas J. Meacham*
 NOV. 79 STATE HIGHWAY ENGINEER.

NUMBER
 9031H

AS-BUILT