
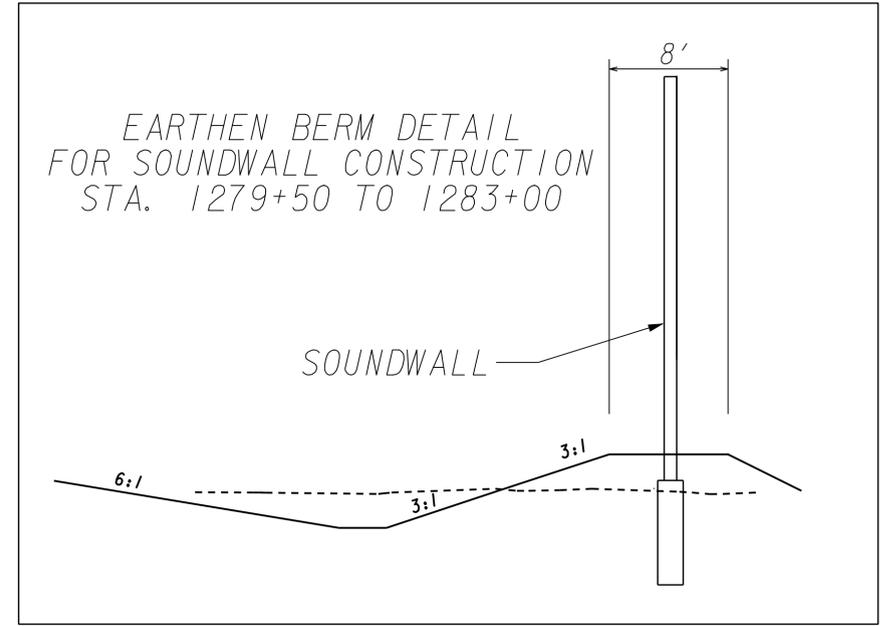
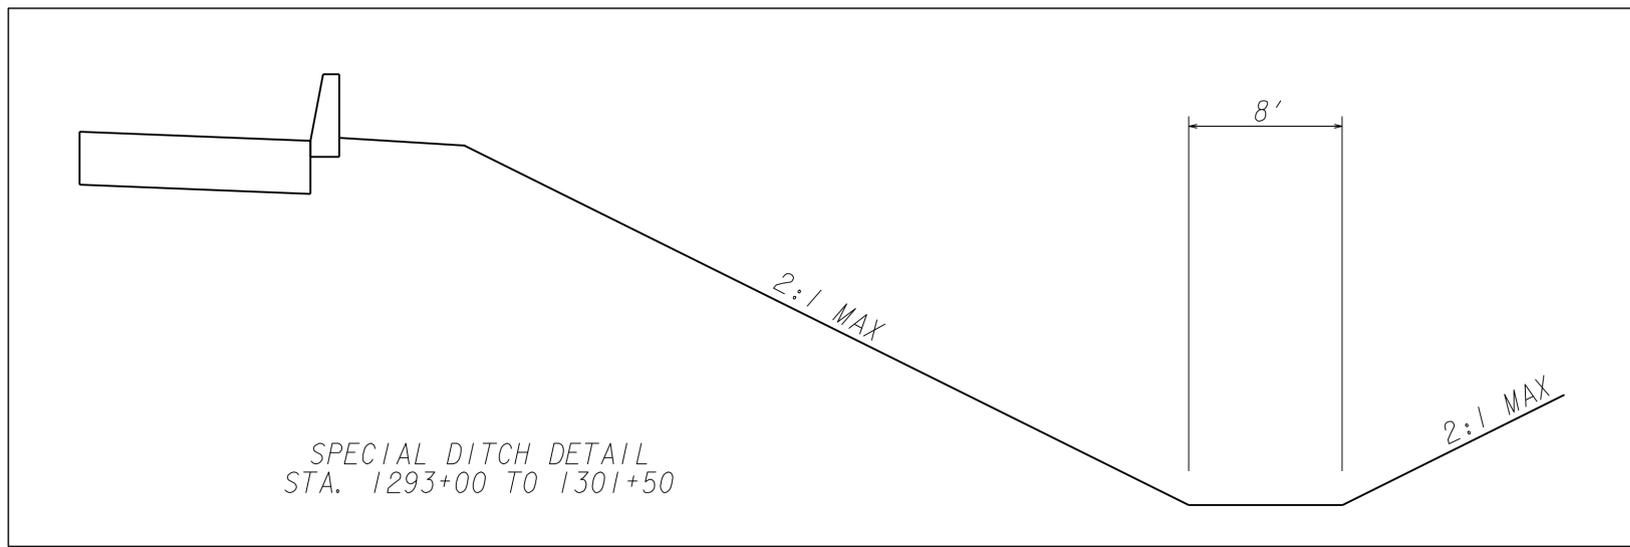
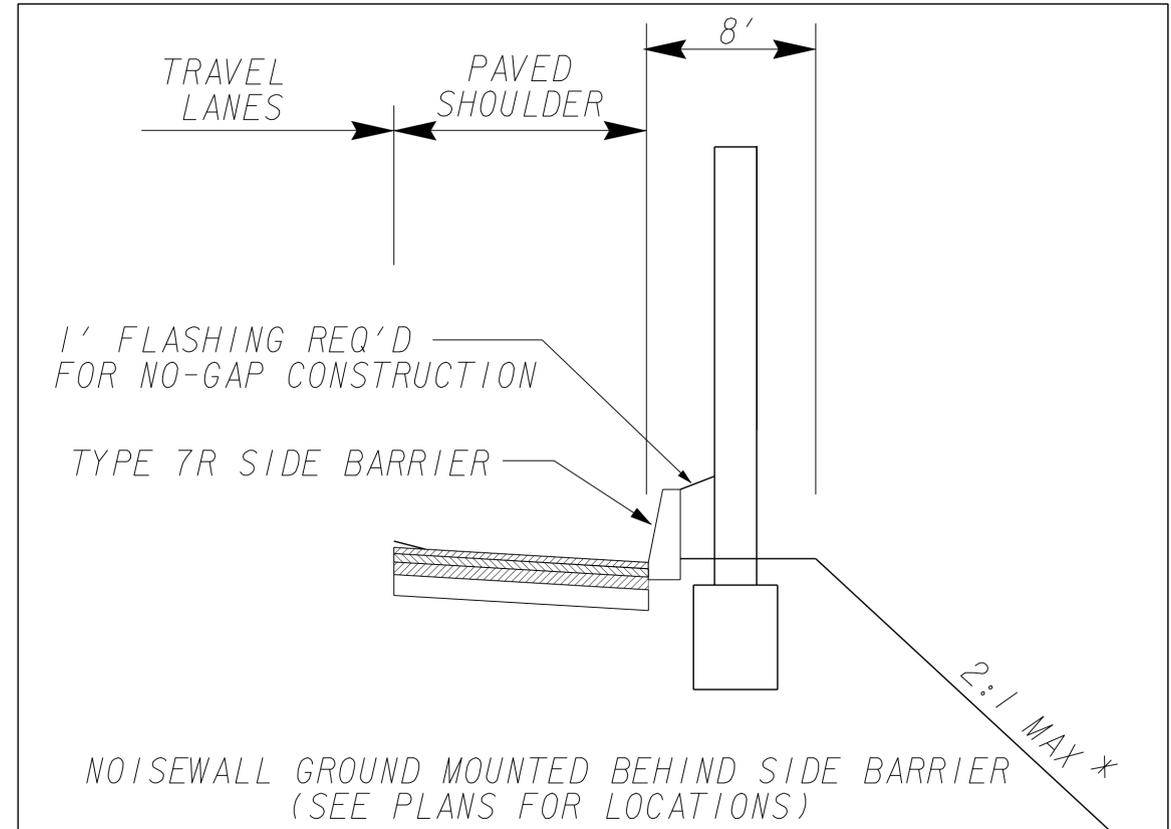


AS-BUILT PLANS - 08/30/13

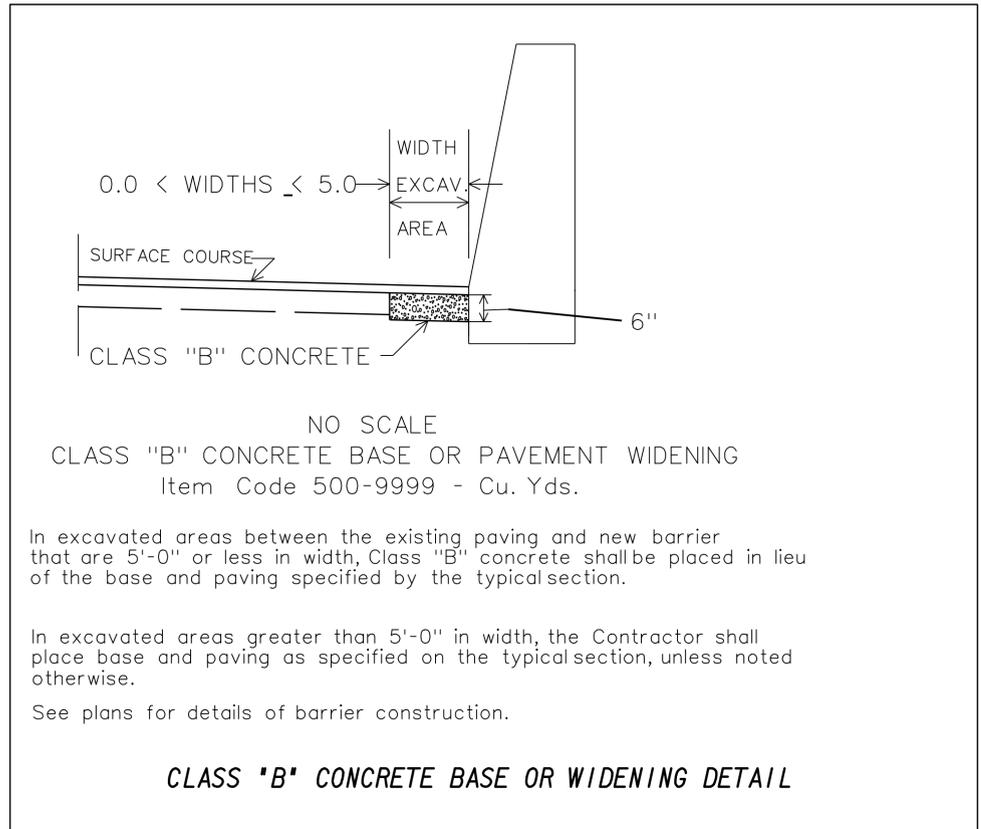

THE LPA GROUP

TRANSPORTATION CONSULTANTS
3595 ENGINEERING DRIVE
NORCROSS, GEORGIA 30092
(770) 263-9118

REVISION DATES			STATE OF GEORGIA DEPARTMENT OF TRANSPORTATION OFFICE: INNOVATIVE PROGRAM DELIVERY	
			TYPICAL SECTIONS	

DRAWING No. **05-015**