



AS-BUILT PLANS - 08/30/13

Wolverton & Associates

6745 Sugarloaf PKWY
Suite 100
Duluth, GA 30097
Office: 770-447-8999
Fax : 770-447-9070

Utility Location Report for Test Hole 9 of 12 in U.S. Survey Feet.

Pavement: <u>NA</u> in. Asphalt <u>NA</u> in. Concrete	Client: GEORGIA DOT	Project # <u>11-615</u>
Soil: Type <u>SAND</u> Conditions <u>DRY</u>	PI# <u>0009542</u>	Truck # <u>12</u>
Requested Utility: <u>TELEPHONE</u> Size: <u>9- 4 inch PVC Conduits</u>	Project <u>NA</u>	Crew Chief <u>M. HARTLEY</u>
UTILITY FOUND? <u>YES</u> CONDITION? <u>GOOD</u> OTHER UTILITIES? <u>NO</u>	Name: <u>I-20 COLLECTOR LANES</u>	Drawn By <u>A. WHITE</u>
BM#1: <u>TRAV. 108 ELEV. 870.45'</u> DESCRIPTION: <u>60D NAIL SOUTH OF EB LANE 1028' EAST OF MILLER ROAD BRIDGE</u>	City: <u>DECATUR</u>	Checked By <u>C. SELLARS</u>
BM#2: <u>TRAV. 109 ELEV. 881.14'</u> DESCRIPTION: <u>60D NAIL SOUTH OF EB LANE 2053' EAST OF MILLER ROAD BRIDGE</u>	County: <u>DEKALB</u>	Date <u>07/08/2011</u>
BM CHECK: <u>0.03'</u>	State: <u>GEORGIA</u>	

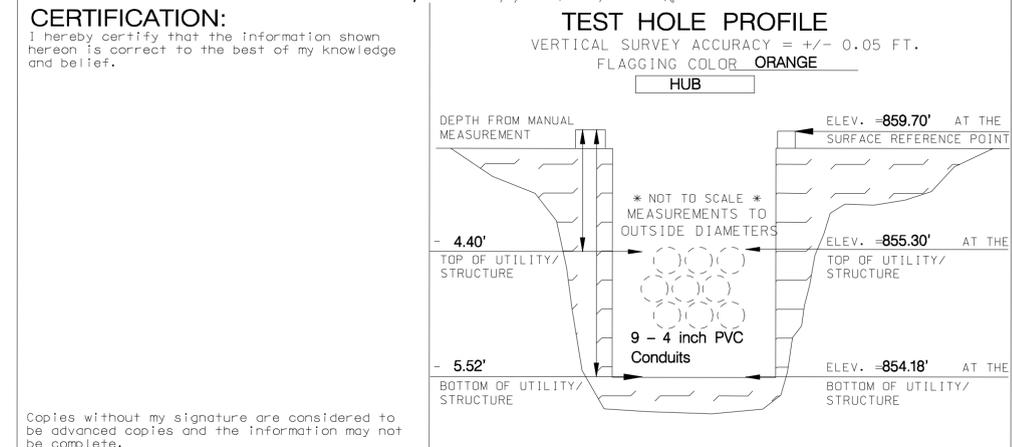
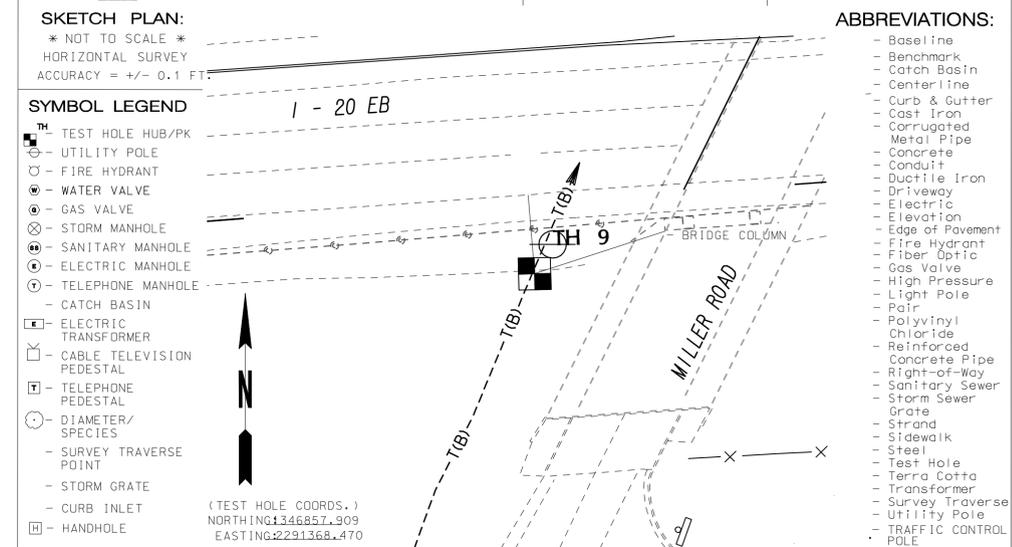


Wolverton & Associates

6745 Sugarloaf PKWY
Suite 100
Duluth, GA 30097
Office: 770-447-8999
Fax : 770-447-9070


Utility Location Report for Test Hole 10 of 12 in U.S. Survey Feet.

Pavement: <u>NA</u> in. Asphalt <u>NA</u> in. Concrete	Client: GEORGIA DOT	Project # <u>10-621</u>
Soil: Type <u>SAND</u> Conditions <u>DRY</u>	PI# <u>0009542</u>	Truck # <u>12</u>
Requested Utility: <u>WATER</u> Size: <u>36" DIP</u>	Project <u>NA</u>	Crew Chief <u>C. SELLARS</u>
UTILITY FOUND? <u>YES</u> CONDITION? <u>GOOD</u> OTHER UTILITIES? <u>NO</u>	Name: <u>I-20 COLLECTOR LANES</u>	Drawn By <u>A. WHITE</u>
BM#1: <u>TRAV. 108 ELEV. 870.45'</u> DESCRIPTION: <u>60D NAIL SOUTH OF EB LANE 1028' EAST OF MILLER ROAD BRIDGE</u>	City: <u>DECATUR</u>	Checked By <u>C. SELLARS</u>
BM#2: <u>TRAV. 109 ELEV. 881.14'</u> DESCRIPTION: <u>60D NAIL SOUTH OF EB LANE 2053' EAST OF MILLER ROAD BRIDGE</u>	County: <u>DEKALB</u>	Date <u>06/23/2011</u>
BM CHECK: <u>0.03'</u>	State: <u>GEORGIA</u>	

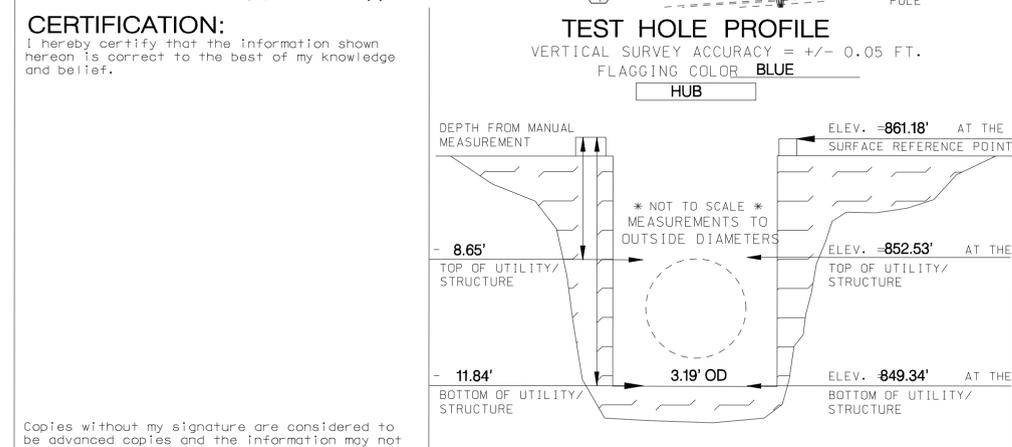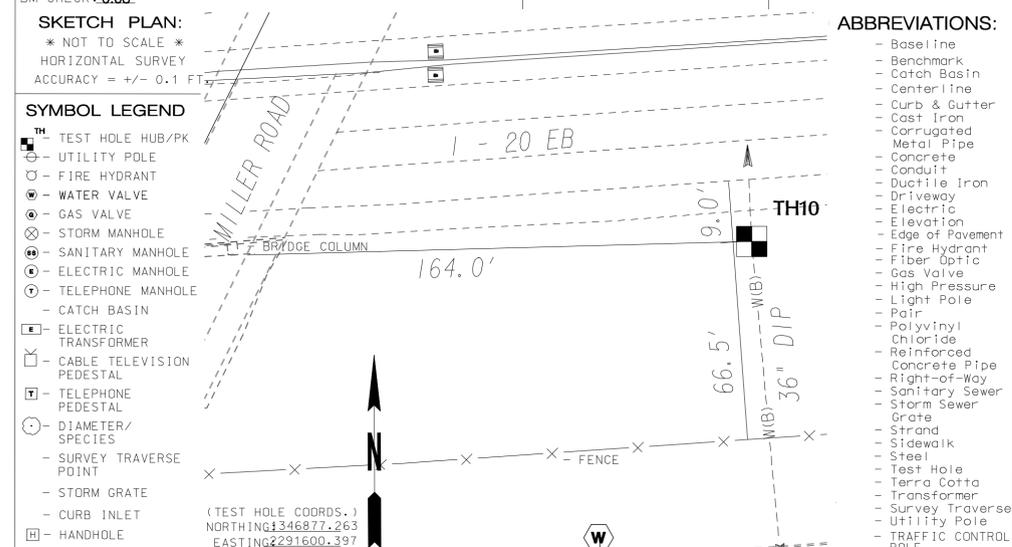

THE LPA GROUP
TRANSPORTATION CONSULTANTS
A UNIT OF MICHAEL BAKER CORPORATION

3595 ENGINEERING DRIVE
NORCROSS, GEORGIA 30092
(770) 263-9118

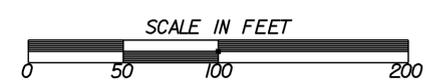

REVISION DATES	

STATE OF GEORGIA
DEPARTMENT OF TRANSPORTATION
OFFICE: INNOVATIVE PROGRAM DELIVERY

UTILITY PLANS

I-20 EASTBOUND CD LANES
I-285 TO PANOLA ROAD

DRAWING No. **24-0G**