

AS-BUILT PLANS - 08/30/13

Wolverton & Associates

6745 Sugarloaf PKWY
Suite 100
Duluth, GA 30097
Office: 770-447-8999
Fax : 770-447-9070


Utility Location Report for Test Hole 11 of 12 in U.S. Survey Feet.

Pavement: <u>NA</u> in. Asphalt <u>NA</u> in. Concrete <u>NA</u> in. Other	Client: <u>GEORGIA DOT</u>	Project # <u>11-615</u>
Soil: Type <u>SAND</u> Conditions <u>DRY/ROCKY</u>	PI# <u>0009542</u>	Truck # <u>12</u>
Requested Utility: <u>WATER</u> Size: <u>12" CIP</u>	Project <u>NA</u>	Crew Chief <u>M. HARTLEY</u>
UTILITY FOUND? <u>YES</u> CONDITION? <u>GOOD</u> OTHER UTILITIES? <u>NO</u>	Name: <u>I-20 COLLECTOR LANES</u>	Drawn By <u>A. WHITE</u>
BM#1: <u>TRAV. 108 ELEV. 870.45'</u> DESCRIPTION: <u>60D NAIL SOUTH OF EB LANE 1028' EAST OF MILLER ROAD BRIDGE</u>	City: <u>DECATUR</u>	Checked By <u>C. SELLARS</u>
BM#2: <u>TRAV. 109 ELEV. 881.14'</u> DESCRIPTION: <u>60D NAIL SOUTH OF EB LANE 2053' EAST OF MILLER ROAD BRIDGE</u>	County: <u>DEKALB</u>	Date <u>07/08/2011</u>
BM CHECK: <u>0.03'</u>	State: <u>GEORGIA</u>	



- ABBREVIATIONS:
- Baseline
 - Benchmark
 - Catch Basin
 - Centerline
 - Curb & Gutter
 - Cast Iron
 - Corrugated Metal Pipe
 - Concrete
 - Conduit
 - Ductile Iron
 - Driveway
 - Electric
 - Elevation
 - Edge of Pavement
 - Fire Hydrant
 - Fiber Optic
 - Gas Valve
 - High Pressure
 - Light Pole
 - Pair
 - Polyvinyl Chloride
 - Reinforced Concrete Pipe
 - Right-of-Way
 - Sanitary Sewer
 - Storm Sewer
 - Grate
 - Strand
 - Sidewalk
 - Steel
 - Test Hole
 - Terra Cotta
 - Transformer
 - Survey Traverse
 - Utility Pole
 - TRAFFIC CONTROL POLE


- SYMBOL LEGEND
- TH - TEST HOLE HUB/PK
 - U - UTILITY POLE
 - FH - FIRE HYDRANT
 - WV - WATER VALVE
 - GV - GAS VALVE
 - SM - STORM MANHOLE
 - SMH - SANITARY MANHOLE
 - EMH - ELECTRIC MANHOLE
 - TMH - TELEPHONE MANHOLE
 - CB - CATCH BASIN
 - ET - ELECTRIC TRANSFORMER
 - CTP - CABLE TELEVISION PEDESTAL
 - TP - TELEPHONE PEDESTAL
 - DS - DIAMETER/SPECIES
 - STP - SURVEY TRAVERSE POINT
 - SG - STORM GRATE
 - CI - CURB INLET
 - HH - HANDHOLE

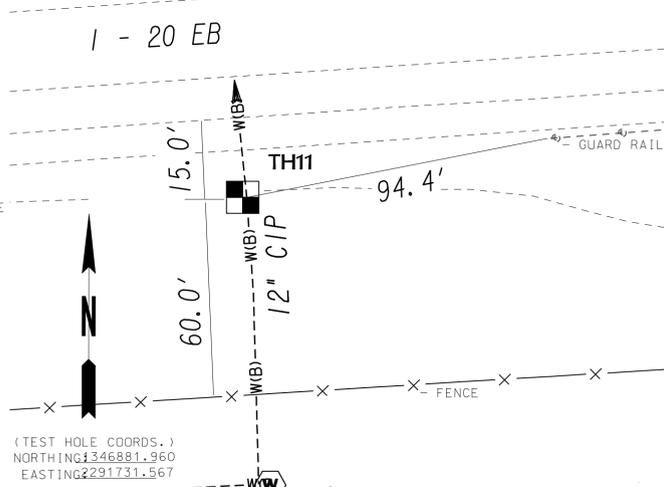

CERTIFICATION:
I hereby certify that the information shown hereon is correct to the best of my knowledge and belief.


(TEST HOLE COORDS.)
NORTHING 1346881.960
EASTING 2291731.567

TEST HOLE PROFILE
VERTICAL SURVEY ACCURACY = +/- 0.05 FT.
FLAGGING COLOR BLUE

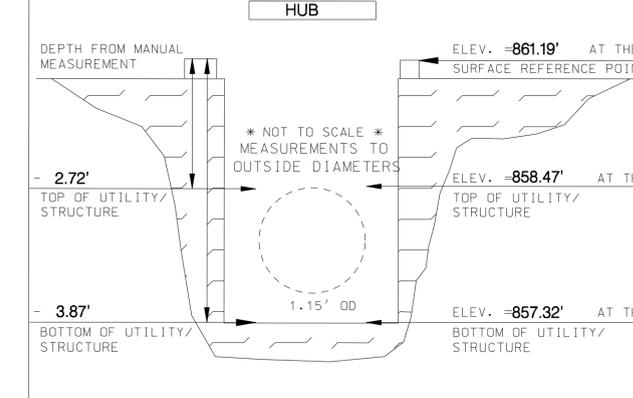

Copies without my signature are considered to be advanced copies and the information may not be complete.

THE LPA GROUP
TRANSPORTATION CONSULTANTS
A UNIT OF MICHAEL BAKER CORPORATION
3595 ENGINEERING DRIVE
NORCROSS, GEORGIA 30092
(770) 263-9118

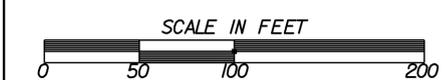

REVISION DATES	STATE OF GEORGIA DEPARTMENT OF TRANSPORTATION OFFICE: INNOVATIVE PROGRAM DELIVERY UTILITY PLANS 1-20 EASTBOUND CD LANES 1-285 TO PANOLA ROAD	DRAWING No. 24-0H
----------------	---	----------------------