

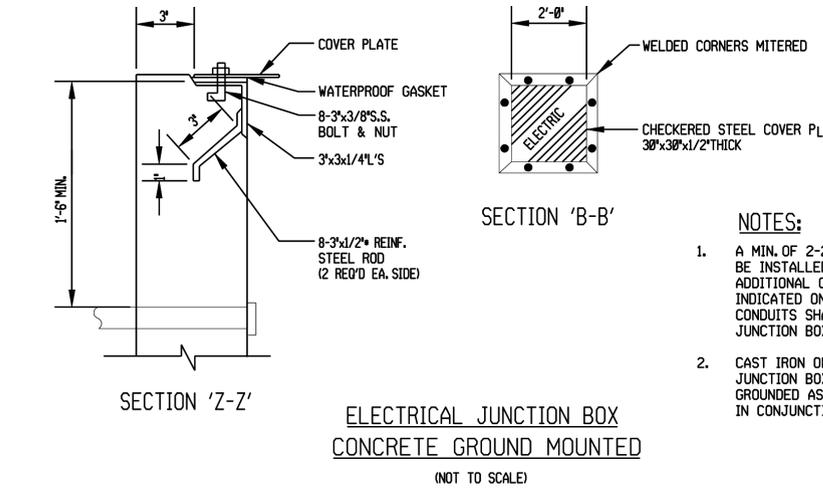



AS-BUILT PLANS - 08/30/13

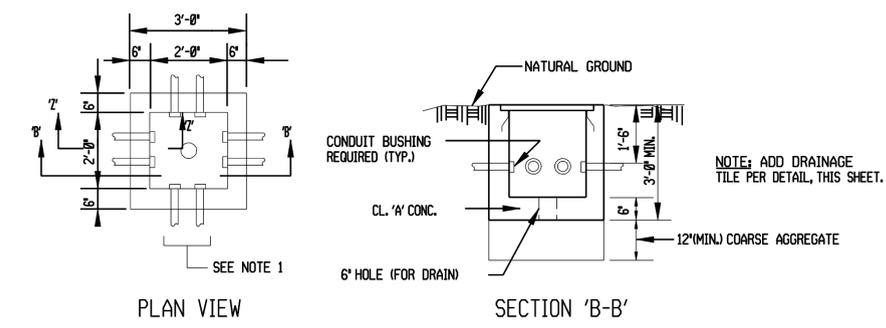



- NOTES:**
1. A MIN. OF 2-2" RIGID GALVANIZED CONDUITS SHALL BE INSTALLED ON EACH SIDE OF JUNCTION BOX. ADDITIONAL CONDUITS SHALL BE INSTALLED WHERE INDICATED ON PLANS (SUCH AS 4 WAY DUCT). UNUSED CONDUITS SHALL BE STUBBED OUT (ONE) FOOT FROM JUNCTION BOX AND CAPPED.
 2. CAST IRON OR STEEL COVERS USED ON ELECTRICAL JUNCTION BOXES OR PULL BOXES SHALL BE GROUNDED AS REQUIRED BY N.E.C. SECTION 314-28(C) IN CONJUNCTION WITH SECTION 250-110.

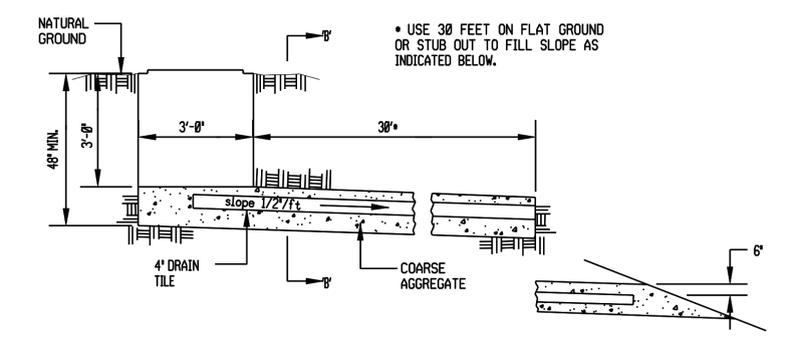

DRAINAGE DETAILS FOR GROUND MOUNTED ELECTRICAL JUNCTION BOXES
(NOT TO SCALE)

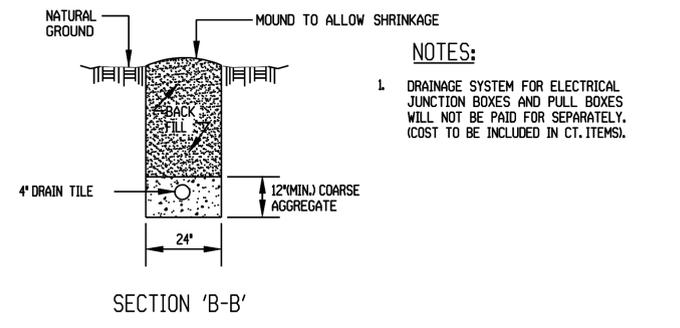

- NOTES:**
1. DRAINAGE SYSTEM FOR ELECTRICAL JUNCTION BOXES AND PULL BOXES WILL NOT BE PAID FOR SEPARATELY. (COST TO BE INCLUDED IN CT. ITEMS).

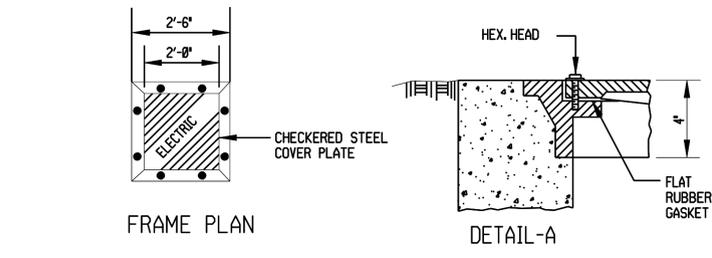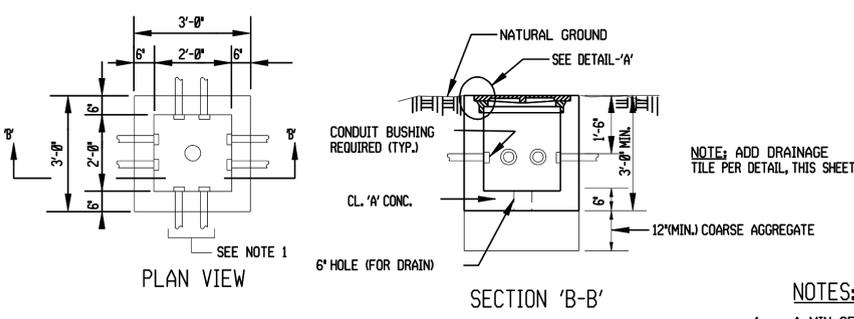

- NOTES:**
1. A MIN. OF 2-2" RIGID GALVANIZED CONDUITS SHALL BE INSTALLED ON EACH SIDE OF JUNCTION BOX. ADDITIONAL CONDUITS SHALL BE INSTALLED WHERE INDICATED ON PLANS (SUCH AS 4 WAY DUCT). UNUSED CONDUITS SHALL BE STUBBED OUT (ONE) FOOT FROM JUNCTION BOX AND CAPPED.
 2. JUNCTION BOXES MUST BE DESIGNED PER ASTM C-857-87 DESIGNATION A-16 (HS20-44) AND ASTM C-497.
 3. CAST IRON OR STEEL COVERS USED ON ELECTRICAL JUNCTION BOXES OR PULL BOXES SHALL BE GROUNDED AS REQUIRED BY N.E.C. SECTION 314-28(C) IN CONJUNCTION WITH SECTION 250-110.

ALTERNATE ELECTRICAL JUNCTION BOX CONCRETE GROUND MOUNTED
(NOT TO SCALE)

© 2011 ATLANTA CONSULTING ENGINEERS, INC. ALL RIGHTS RESERVED.
THESE CONSTRUCTION DOCUMENTS AND PERMITTED REPRODUCTIONS, IN WHOLE OR IN PART, ARE INSTRUMENTS OF SERVICE AND ARE THE SOLE PROPERTY OF ATLANTA CONSULTING ENGINEERS, INC. UNLESS OTHERWISE NOTED TO THE CONTRARY, THEY SHALL NOT BE REPRODUCED OR CONVEYED IN ANY MANNER NOR ARE THEY TO BE USED FOR ANY OTHER PROJECTS OTHER THAN THAT SPECIFICALLY INDICATED HEREIN WITHOUT WRITTEN PERMISSION FROM AND THE COMPOSITION TO ATLANTA CONSULTING ENGINEERS, INC.

ATLANTA CONSULTING ENGINEERS
500 SUN VALLEY DRIVE
UNIT 02
ROSWELL, GEORGIA 30076
Tel: 678-205-2240
Fax: 678-205-2239

THE LPA GROUP
TRANSPORTATION CONSULTANTS
A UNIT OF MICHAEL BAKER CORPORATION
3595 ENGINEERING DRIVE
NORCROSS, GEORGIA 30092
(770) 263-9118

REVISION DATES	
01-20-2012	

STATE OF GEORGIA
DEPARTMENT OF TRANSPORTATION
OFFICE: INNOVATIVE PROGRAM DELIVERY
LIGHTING PLANS
LIGHTING DETAILS
DRAWING No. 25-006