
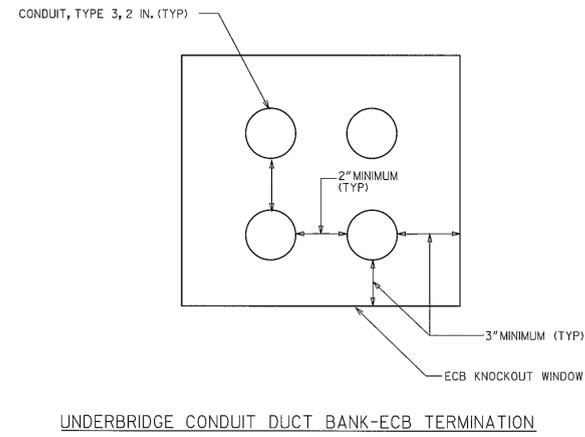


AS-BUILT PLANS - 08/30/13

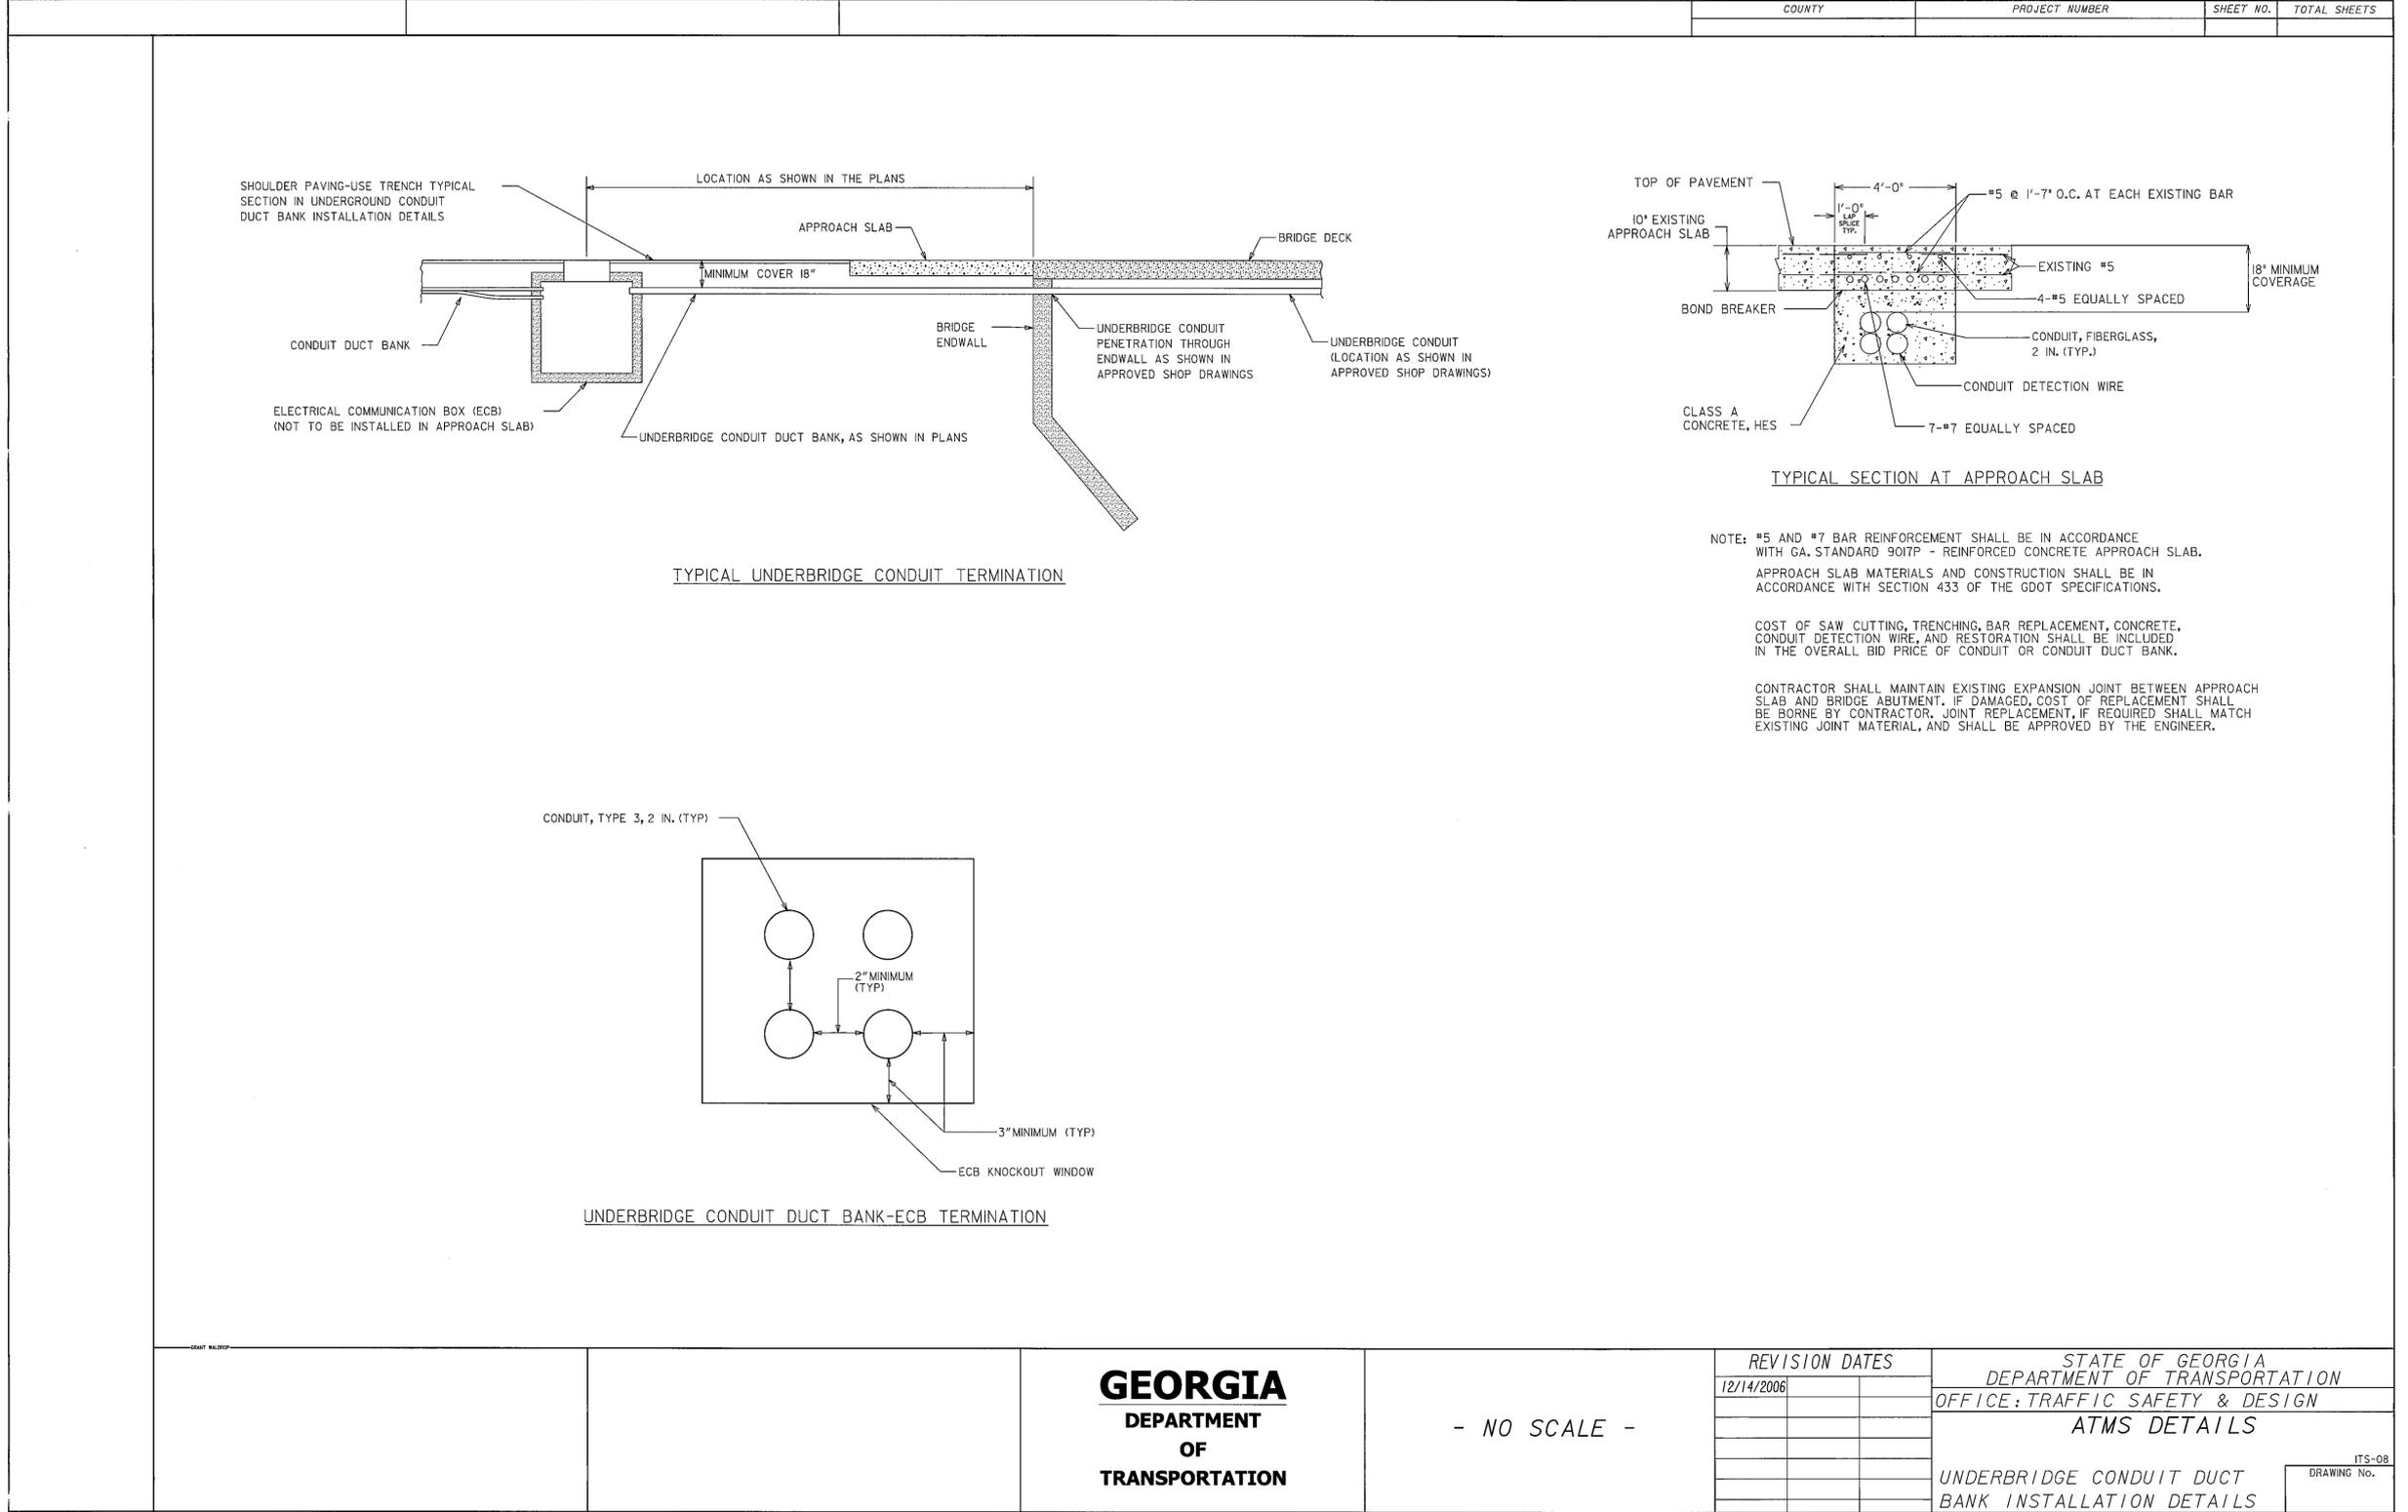


GEORGIA DEPARTMENT OF TRANSPORTATION	- NO SCALE -	STATE OF GEORGIA DEPARTMENT OF TRANSPORTATION OFFICE: TRAFFIC SAFETY & DESIGN ATMS DETAILS	ITS-08 DRAWING No.
		STATE OF GEORGIA DEPARTMENT OF TRANSPORTATION OFFICE: INNOVATIVE PROGRAM DELIVERY ATMS DETAILS	DRAWING No. 28-026

PROPERTY AND EXISTING R/W LINE	— P — —
REQUIRED R/W LINE	— — — —
CONSTRUCTION LIMITS	— G — F —
EASEMENT FOR CONSTR & MAINTENANCE OF SLOPES	[Hatched Box]
EASEMENT FOR CONSTR OF SLOPES	[Hatched Box]
EASEMENT FOR CONSTR OF DRIVES	[Hatched Box]

BEGIN LIMIT OF ACCESS.....BLA	— o — o —
END LIMIT OF ACCESS.....ELA	— — — —
LIMIT OF ACCESS	— — — —
R/W AND LIMIT OF ACCESS	— — — —
HISTORICAL BOUNDARY	— — — —

A&R Engineering, Inc.
 2160 Kingston Court, Suite 0
 Marietta, GA 30067
 Tel: (770) 690-9255 Fax: (770) 690-9210
 www.a&r-eng.com

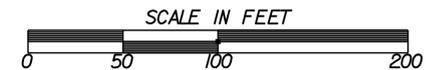

REVISION DATES 12/14/2006 	STATE OF GEORGIA DEPARTMENT OF TRANSPORTATION OFFICE: INNOVATIVE PROGRAM DELIVERY ATMS DETAILS 1-20 EASTBOUND CD LANES 1-285 TO PANOLA ROAD
--	--