


AS-BUILT PLANS - 08/30/13

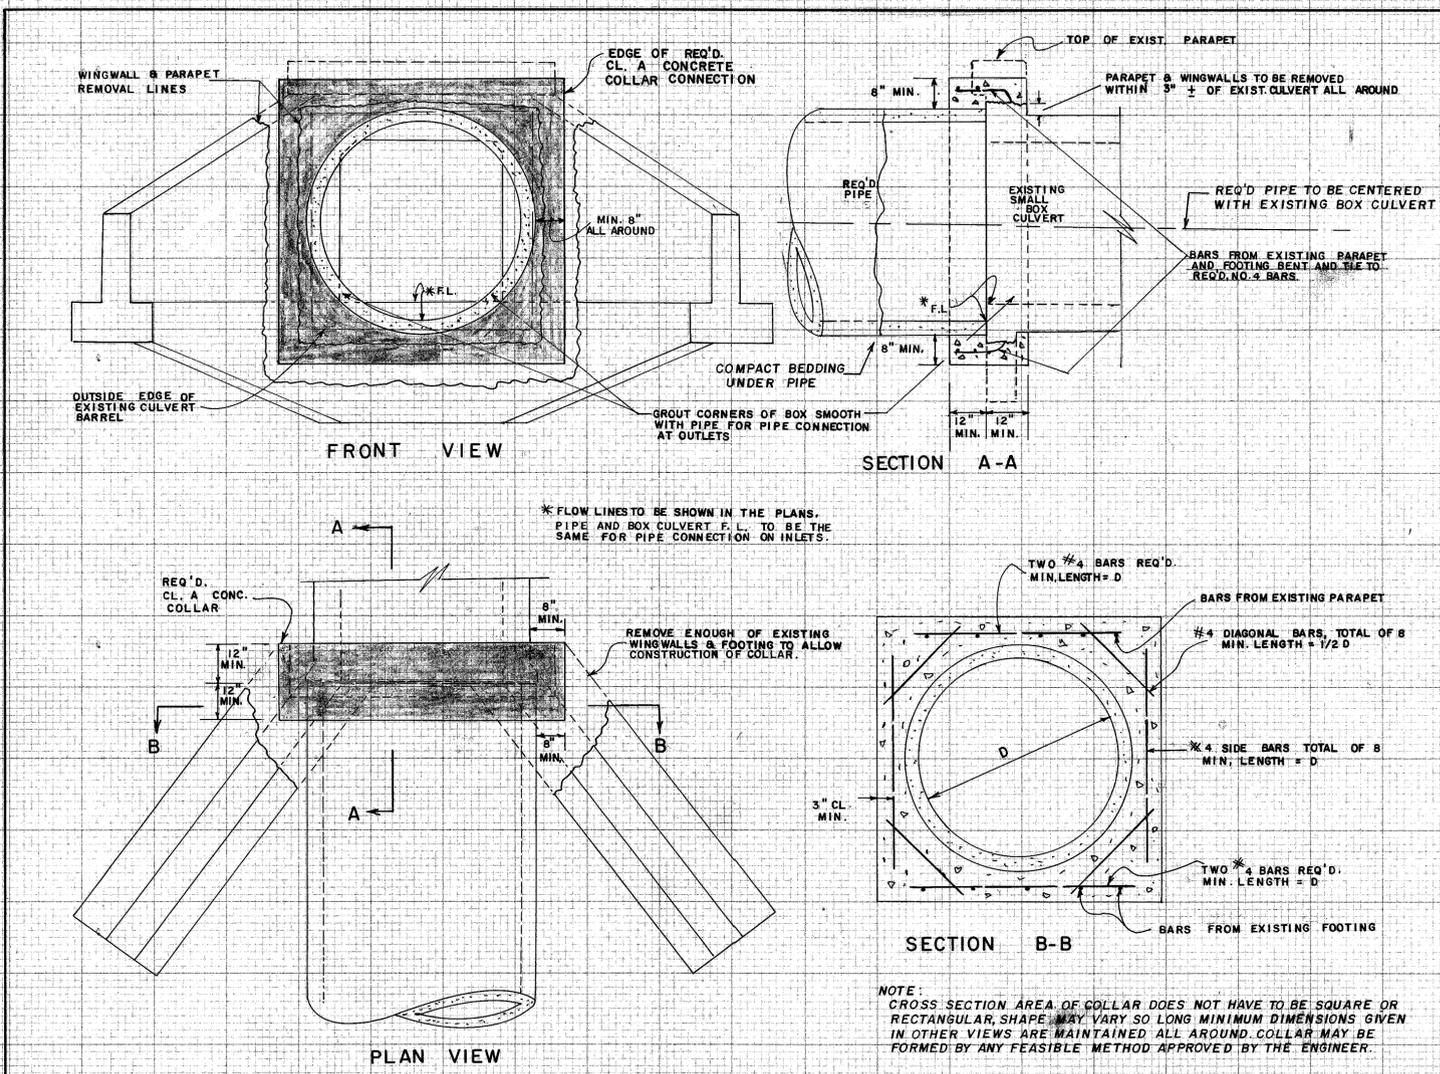

- NOTES:
1. PAYMENT FOR PIPE CULVERT SHALL INCLUDE REMOVING PORTIONS OF WINGWALLS & PARAPET AS SHOWN AND THE CONCRETE AND STEEL REQUIRED FOR COLLAR CONNECTION.
 2. COLLAR DIMENSIONS SHOWN ARE MINIMUM. COLLAR MAY BE FORMED AGAINST COMPACTED OR UNDISTURBED SOIL OR AGAINST EDGES OF EXISTING STRUCTURE. EXTERIOR OF COLLAR DOES NOT HAVE TO BE SMOOTH LINES.
 3. THESE DETAILS ARE FOR USE WHERE IT IS NOT FEASIBLE TO EXTEND BOX CULVERT WITH SAME. WHERE PLANS SHOW BOX CULVERT EXTENDED WITH PIPE, THE CONTRACTOR MAY ELECT TO EXTEND WITH PRECAST BOX OR CAST-IN-PLACE BOX OF SAME SIZE WHERE FILL HEIGHT PERMITS AND AT NO ADDITIONAL COST TO THE DEPARTMENT.
 4. ADJUSTMENTS TO DETAILS SHOWN MAY BE MADE IN THE FIELD AT THE DIRECTION OF THE ENGINEER TO SUIT INDIVIDUAL SITE.

NOTE:
CROSS SECTION AREA OF COLLAR DOES NOT HAVE TO BE SQUARE OR RECTANGULAR, SHAPE MAY VARY SO LONG MINIMUM DIMENSIONS GIVEN IN OTHER VIEWS ARE MAINTAINED ALL AROUND. COLLAR MAY BE FORMED BY ANY FEASIBLE METHOD APPROVED BY THE ENGINEER.

CONSTRUCTION DETAILS
PIPE-BOX CULVERT
COLLAR CONNECTIONS
DETAILS
MARCH, 1988

FORM EF00003

THE LPA GROUP
TRANSPORTATION CONSULTANTS
3595 ENGINEERING DRIVE
NORCROSS, GEORGIA 30092
(770) 263-9118

REVISION DATES		

STATE OF GEORGIA
DEPARTMENT OF TRANSPORTATION
OFFICE: INNOVATIVE PROGRAM DELIVERY
CONSTRUCTION DETAILS

DRAWING No.
40-009