



STATE	PROJECT NUMBER	SHEET NO.	TOTAL SHEETS
GA			

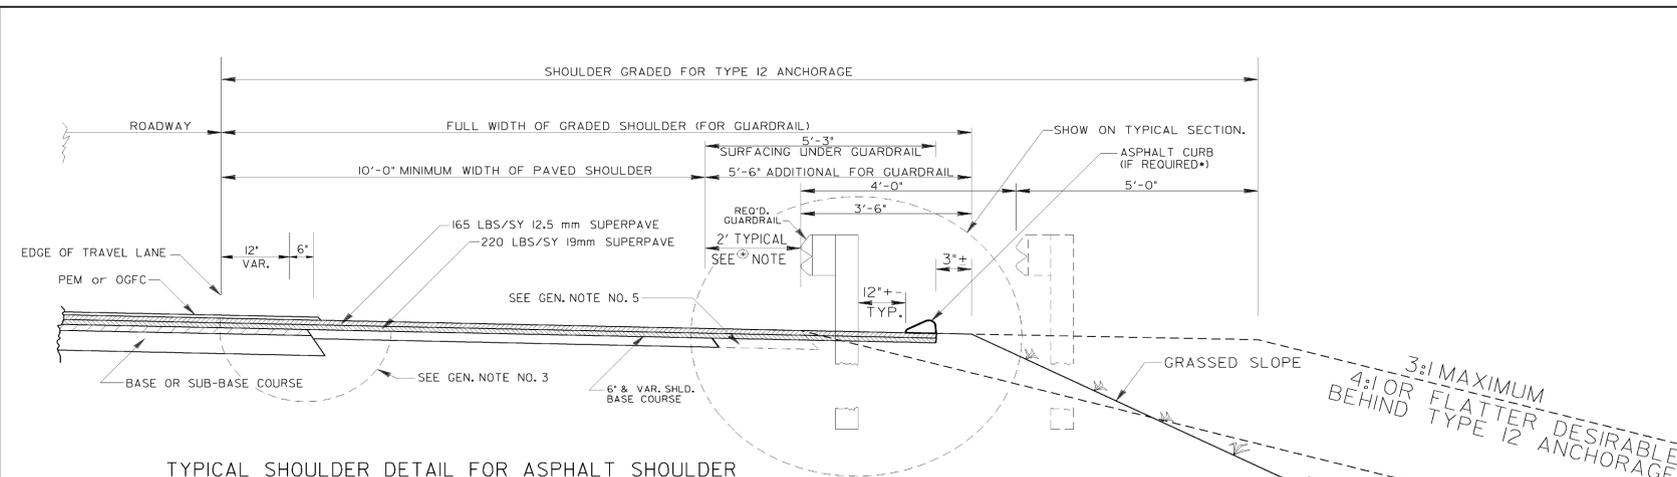

TYPICAL SHOULDER DETAIL FOR ASPHALT SHOULDER
(FOR GUARDRAIL REQUIRED ON SHOULDER)

GENERAL NOTES:

- SPECIFICATIONS: GEORGIA STANDARD, CURRENT EDITION, & SUPPLEMENTS THERETO.
- THE TREATMENT SHOWN FOR THE OUTER PORTION OF THE SHOULDER APPLIES ONLY WHERE GUARDRAIL IS TO BE LOCATED ALONG PAVED SHOULDER.
- PAYMENT DESIGN AND NORMAL SHOULDER PAVING ARE ILLUSTRATED AS TYPICAL, OTHER MATERIALS SUCH AS SELECT BORROW, DRAINAGE COURSE, 12.5 MM SUPERPAVE, ETC. SHALL BE AS SPECIFIED ON THE PROJECT, WHERE REQUIRED.
- AFTER GUARDRAIL POSTS HAVE BEEN INSTALLED, THE SURFACE AREA AROUND THE POSTS SHALL BE SEALED WITH THE APPROPRIATE ASPHALT OR OTHER APPROVED MATERIAL AT NO ADDITIONAL PAYMENT, IF THE ENGINEER DETERMINES IT IS NECESSARY.
- THE PAVED SHOULDER WIDTH MAY BE EXTENDED TO THE FACE OF THE GUARDRAIL, WHERE SPECIFIED.
- NORMAL USE OF ASPHALTIC CURB SHALL BE WHERE 2:1 FILL SLOPES WARRANT GUARDRAIL, EXCEPT ON THE HIGH SIDE OF SUPERELEVATION. SEE SEPARATE DETAILS.

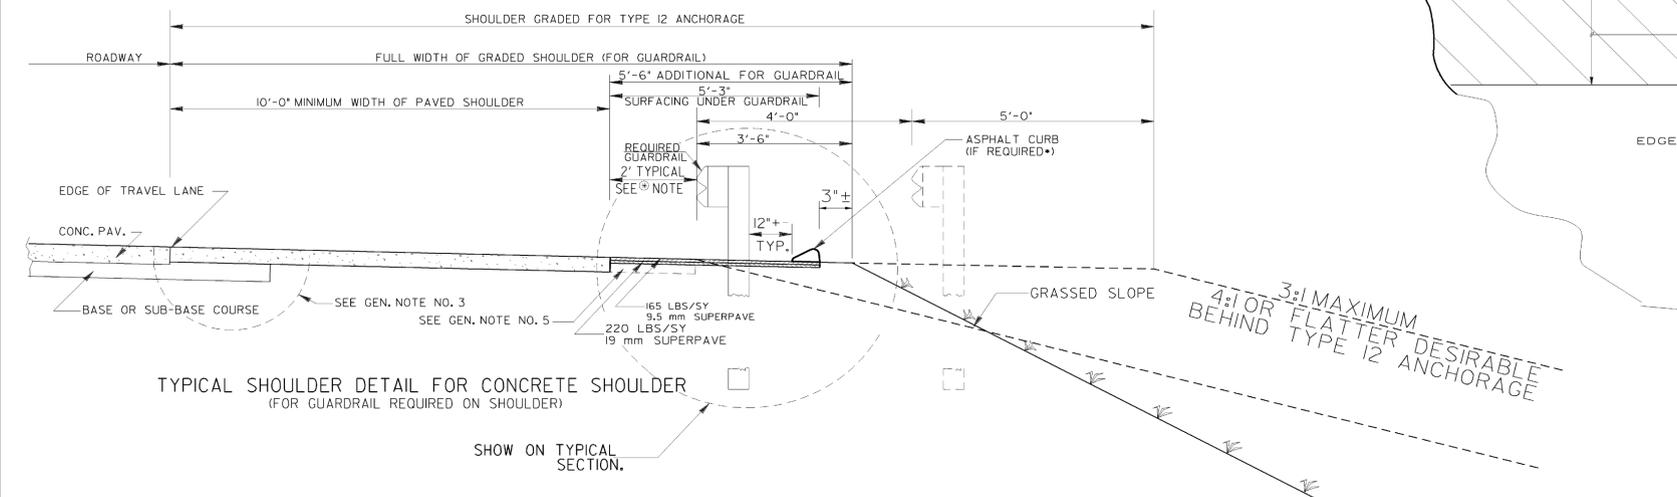


TYPICAL SHOULDER DETAIL FOR CONCRETE SHOULDER
(FOR GUARDRAIL REQUIRED ON SHOULDER)

NOTE:

STANDARD OFFSET TO FACE OF GUARDRAIL IS 2 FT. GREATER THAN THE USABLE SHOULDER WIDTH. SHOULDER PAVING SHALL BE AT LEAST THE WIDTH OF THE USABLE SHOULDER FOR USE OF THESE DETAILS. (SHOULDER PAVING WIDTH MAY BE ADDITIONALLY INCREASED AT GUARDRAIL RUNS TO REDUCE AREA REQUIRING WEED CONTROL). GRADED SHOULDER SHALL HAVE ADDITIONAL WIDTH FOR GUARDRAIL LOCATION PER STANDARD DETAILS.

* ASPHALTIC CONCRETE CURB PER SECTION 436 SHALL BE REQUIRED WHERE SPECIFIED. TYPICAL USE IS FOR EROSION PREVENTION OF HIGH FILL SLOPES. THE SHAPE OF ASPHALTIC CURB BEHIND GUARDRAIL MAY VARY AS APPROVED BY THE ENGINEER.

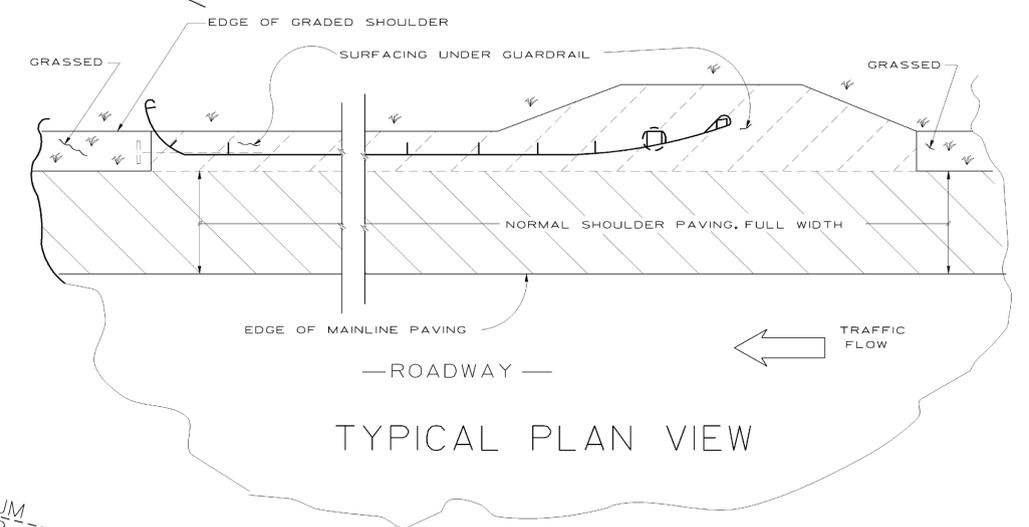

TYPICAL PLAN VIEW

NOTE: NORMAL USE OF THESE DETAILS IS WHERE FULL WIDTH SHOULDER PAVING IS SPECIFIED AND GUARDRAIL IS REQUIRED.

REVISION		DATE
REVISED	9-30-02	
REVISED	4-23-02	

CONSTRUCTION DETAILS
SHOULDER PAVING AND SURFACING UNDER GUARDRAIL
Interstates & Freeways

NO SCALE RE-DRAWN OCT. 1999

DES. & REV. MGR. (SUBMITTED) _____
REDR. ADS. (APPROVED) STATE ROAD & AIRPORT DESIGN ENGR.
CHK. (APPROVED) _____
CHIEF ENGINEER

Sheet 2 of 2
S-4

AS-BUILT PLANS - 08/30/13



REVISION DATES	

STATE OF GEORGIA
DEPARTMENT OF TRANSPORTATION
OFFICE: INNOVATIVE PROGRAM DELIVERY
CONSTRUCTION DETAILS

DRAWING No.
40-017