


AS-BUILT PLANS - 08/30/13

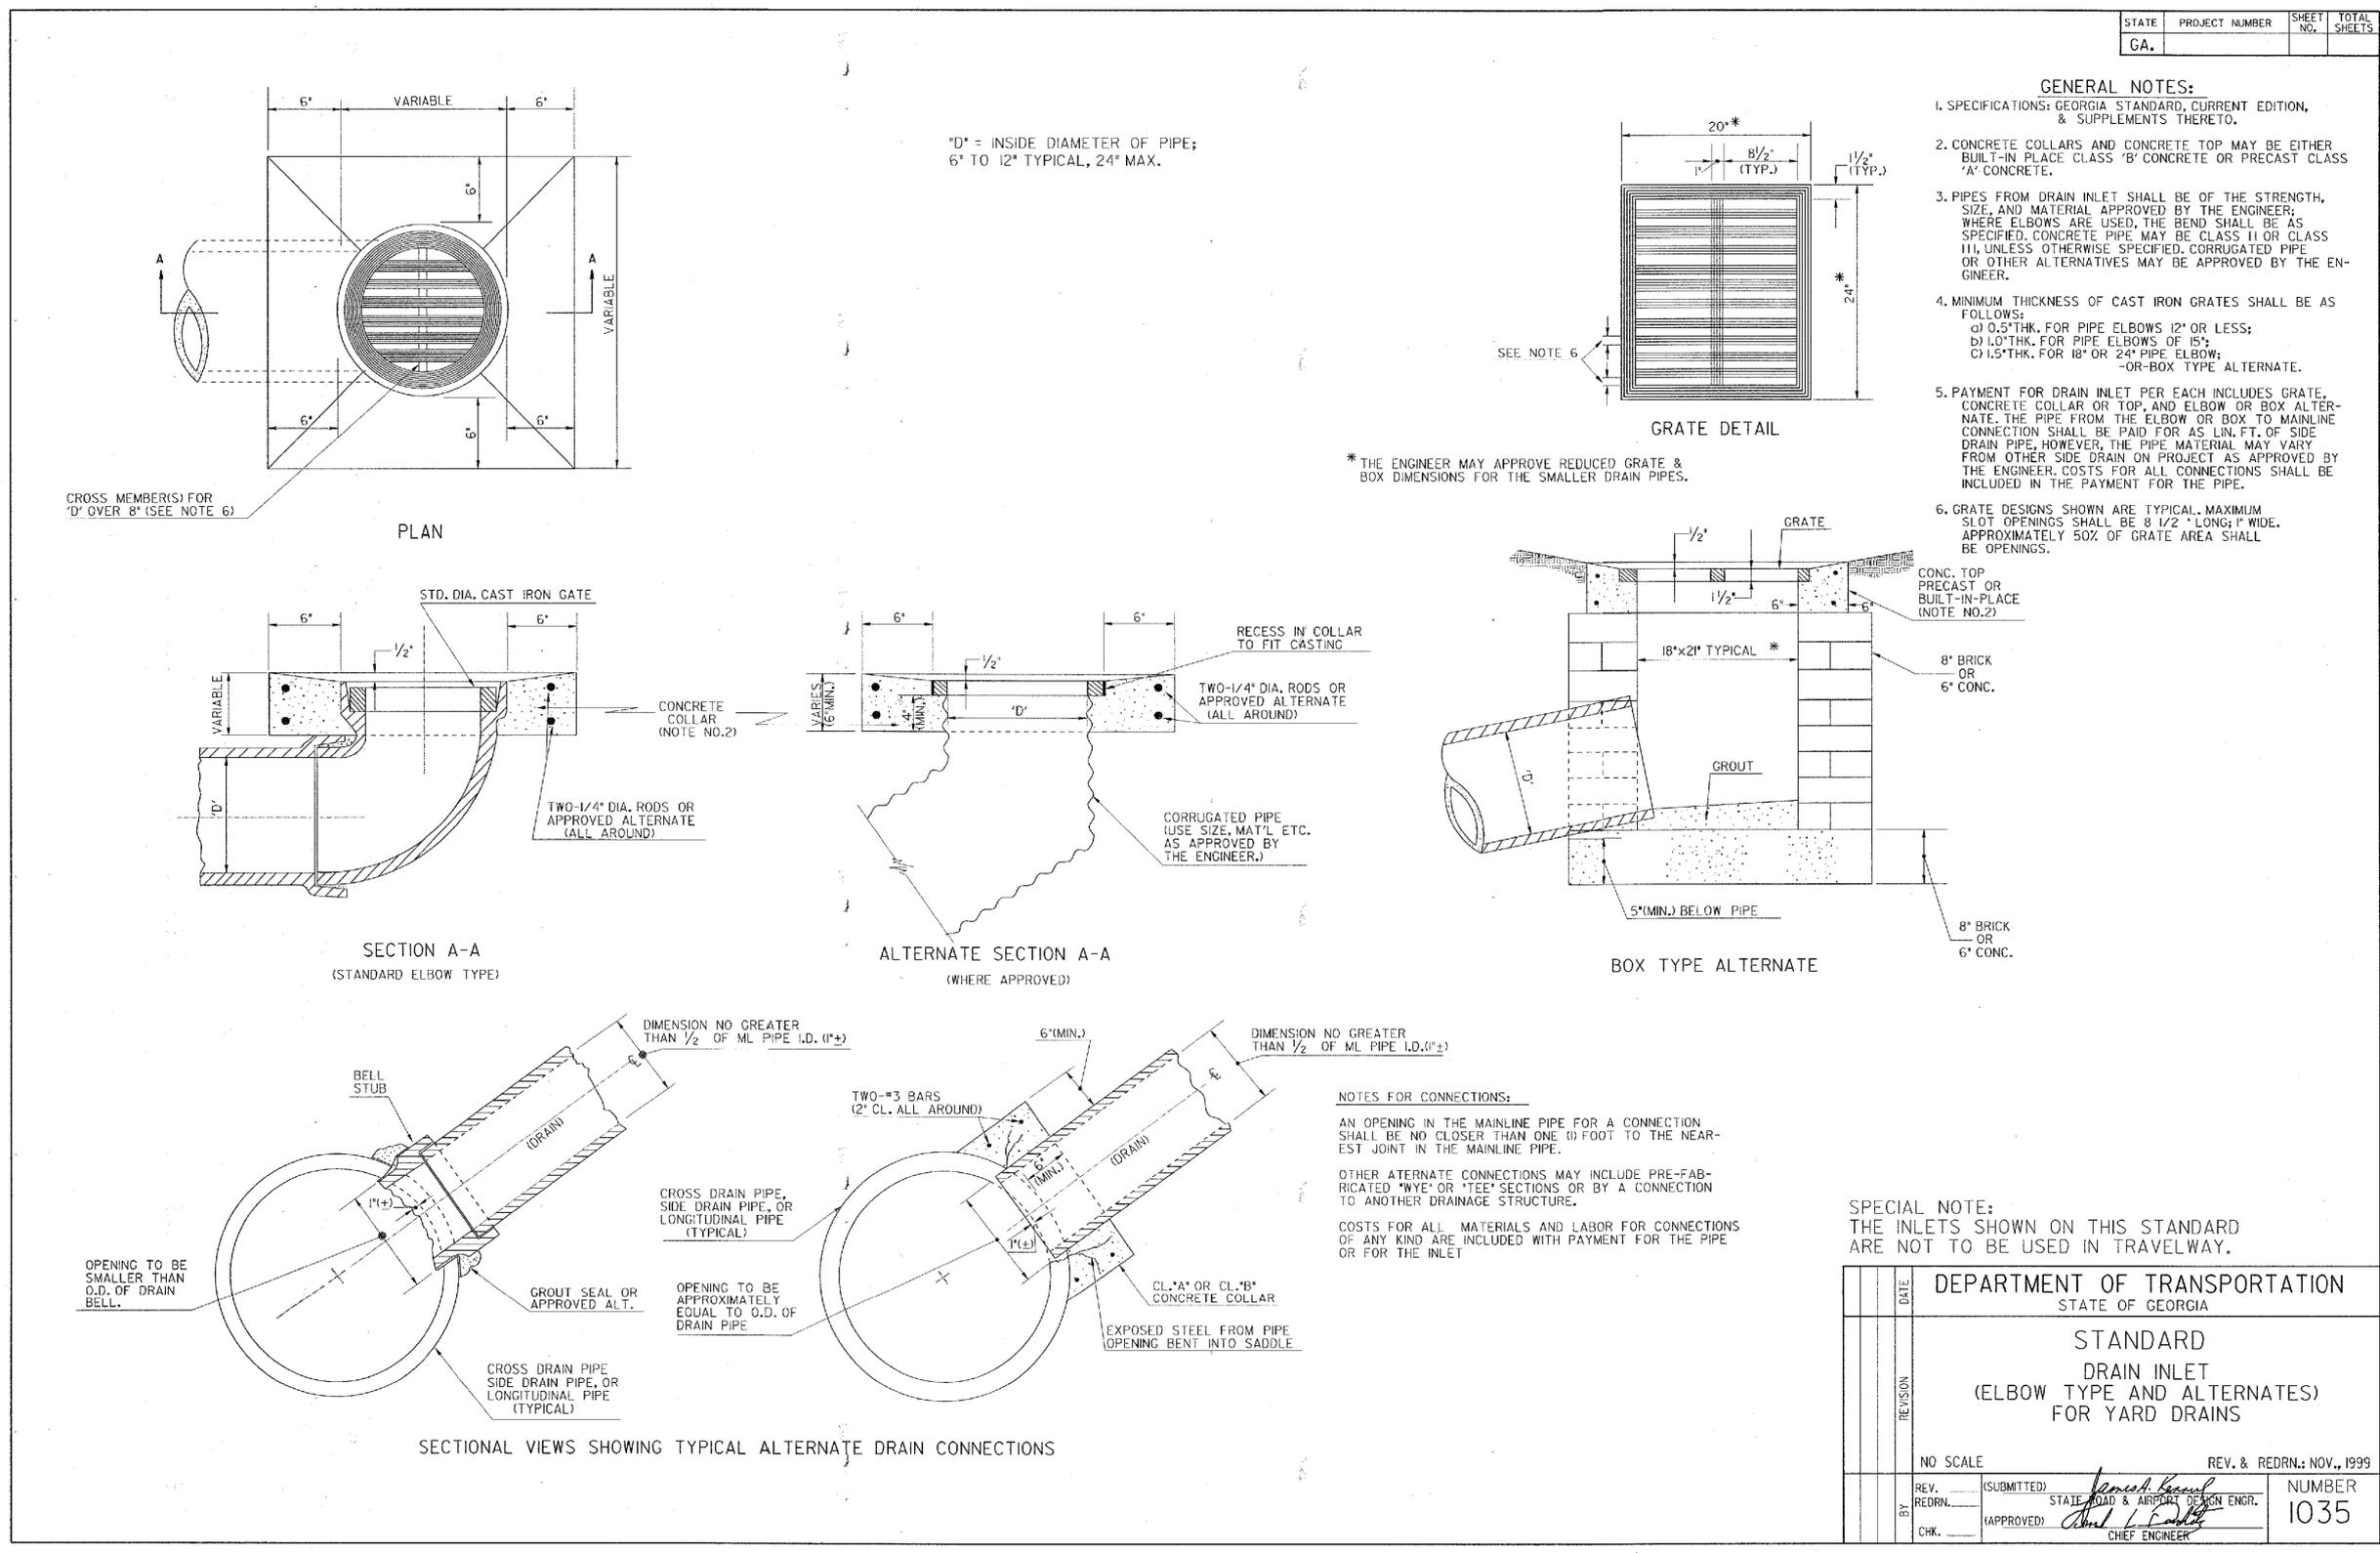

STATE	PROJECT NUMBER	SHEET NO.	TOTAL SHEETS
GA.			

DEPARTMENT OF TRANSPORTATION STATE OF GEORGIA	
STANDARD DRAIN INLET (ELBOW TYPE AND ALTERNATES) FOR YARD DRAINS	
NO SCALE	REV. & REDRN.: NOV., 1999
REV. (SUBMITTED)	NUMBER
REDRN. (APPROVED)	1035
CHK.	CHEF ENGINEER

**THE LPA GROUP**  
TRANSPORTATION CONSULTANTS  
A UNIT OF MICHAEL BAKER CORPORATION

3595 ENGINEERING DRIVE  
NORCROSS, GEORGIA 30092  
(770) 263-9118

REVISION DATES	

STATE OF GEORGIA DEPARTMENT OF TRANSPORTATION	
OFFICE: INNOVATIVE PROGRAM DELIVERY	
GEORGIA STANDARDS	

DRAWING No.	41-008
-------------	--------