
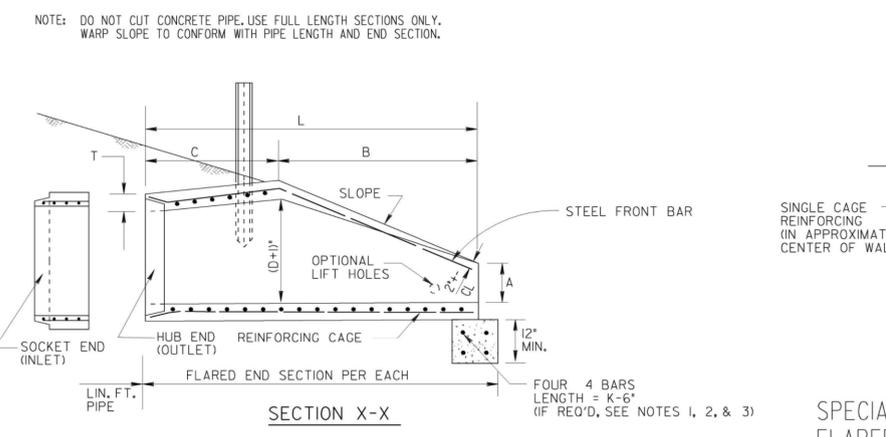


9/6/2006 9:44:21 AM \\GDOT-DSN\GDPLOT\GCF\qo-111f-output.qcf_gomans_M:\GARY\REVISED_1120\1120.dwg

AS-BUILT PLANS - 08/30/13

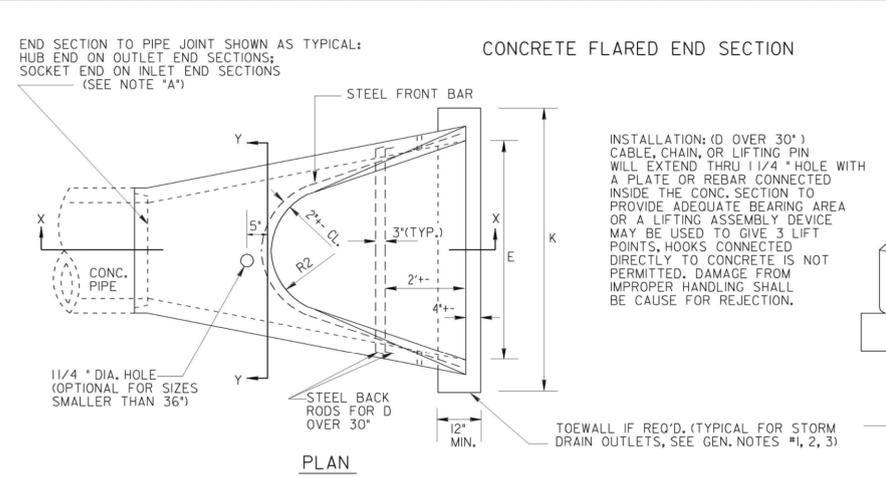

INSTALLATION: (D OVER 30") CABLE, CHAIN, OR LIFTING PIN WILL EXTEND THRU 1/4" HOLE WITH A PLATE OR REBAR CONNECTED INSIDE THE CONC. SECTION TO PROVIDE ADEQUATE BEARING AREA OR A LIFTING ASSEMBLY DEVICE MAY BE USED TO GIVE 3 LIFT POINTS. HOOKS CONNECTED DIRECTLY TO CONCRETE IS NOT PERMITTED. DAMAGE FROM IMPROPER HANDLING SHALL BE CAUSE FOR REJECTION.

NOTE: DO NOT CUT CONCRETE PIPE. USE FULL LENGTH SECTIONS ONLY. WARP SLOPE TO CONFORM WITH PIPE LENGTH AND END SECTION.

NOTE "A": CONTRACTOR WILL INFORM PRODUCER IF CONCRETE FLARED END SECTION IS FOR INLET OR FOR OUTLET END. SOCKET (TONGUE OR SPIGOT) END IS REQUIRED FOR INLETS. HUB (GROOVE OR BELL) END IS REQUIRED FOR OUTLETS. SOCKET TO SOCKET OR HUB TO HUB JOINT WILL NOT BE ACCEPTED UNLESS A REINFORCED CONCRETE COLLAR IS BUILT AROUND THE JOINT WITH NO PAYMENT BEING MADE FOR THE COLLAR. FLARED END SECTIONS SHALL BE JOINTED TO PIPE WITH ALL SPACE IN THE JOINT FILLED WITH EITHER BITUMINOUS PLASTIC CEMENT OR PREFORMED PLASTIC GASKET (SEC. 848).



WALL THICKNESS (T) IS SHOWN AS NOMINAL AND MAY BE INCREASED AT PRODUCER'S OPTION FOR DESIRED JOINT DESIGN OR TO ALLOW A FLAT OUTSIDE BOTTOM ON THE FLARE, WITH INSIDE DIMENSIONS OF FLARE RETAINED AS SHOWN.

T = PIPE WALL THICKNESS (0.0833D + 1"± TYPICAL)

DIMENSIONS AND REINFORCING FOR CONCRETE FLARED END SECTIONS (+/- 1" TOLERANCE)											OUTLET TOEWALL (IF REQ'D)		
PIPE DIA	FRONT BAR	BACK RODS	SLOPE +/-	A	B	C	L	E	P	R1	R2	K= E + 2'	CU.YDS. CONC.
12"	1-#3 x 5' 4"	NOT REQ'D.	2.2%	4'	2'0"	4' 1"	6' 1"	2'0"	1'8"	10"	9"	4'-0"	.148
15"	1-#3 x 6' 0"	NOT REQ'D.	2.2%	6'	2'3"	3'10"	6' 1"	2'6"	2'0"	10"	11"	4'-6"	.167
18"	1-#3 x 7' 2"	NOT REQ'D.	2.2%	9'	2'3"	3'10"	6' 1"	3'0"	2'5"	14"	10"	5'-0"	.185
24"	1-#3 x 9' 10"	NOT REQ'D.	2.4%	10'	3'8"	2'6"	6' 2"	4'0"	2'9"	15"	12"	6'-0"	.222
30"	1-#4 x 11' 8"	NOT REQ'D.	2.4%	12'	4'6"	1' 8"	6' 2"	5'0"	3'1"	16"	13"	7'-0"	.259
36"	1-#4 x 13' 10"	2-#4 x 6' 3"	2.4%	15'	5'3"	2'11"	8' 2"	6'0"	4'0"	2'0"	18"	8'-0"	.296
42"	1-#4 x 13' 10"	2-#4 x 7' 4"	2.4%	21'	5'3"	2'11"	8' 2"	6'6"	4'6"	2'4"	110"	8'-6"	.315

NOTE: SPECIFIED REINFORCING IS MINIMAL AND MAY BE INCREASED AT PRODUCERS OPTION TO AID CASTING & HANDLING. ALTERNATE REINFORCEMENT PERMITTED IF APPROVED.


*NOTE: "C" AND "L" DIMENSION MAY BE MEASURED TO EITHER END OF JOINT CONNECTION AT PIPE.

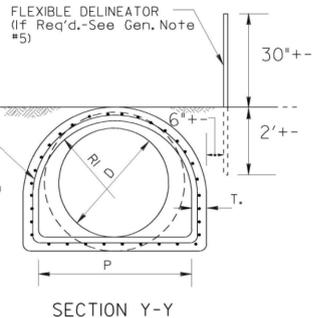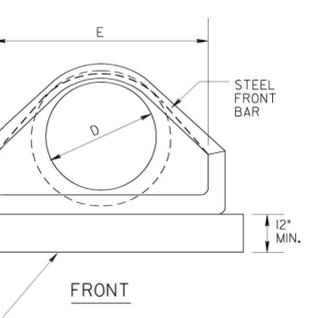

SPECIAL NOTE: FLARED END SECTIONS ARE NORMALLY LIMITED TO USE OUTSIDE THE CLEAR ZONE OR BEHIND BARRIER AND WHERE HYDRAULICS PERMIT. SEE OTHER STANDARDS OR DETAILS FOR TAPERED HEADWALLS, SAFETY SLOPE END SECTIONS OR OTHER PIPE END STRUCTURES.



GENERAL NOTES :

- TOEWALLS ARE REQ'D. FOR OUTLETS OF CONC. STORM DRAINS, EXCEPT WHERE DITCH PAVING OR OTHER EROSION PROTECTION IS PROVIDED OR WHERE THE OUTLET VELOCITY IS LESS THAN 8 FT/SEC. TOEWALLS ARE NOT REQUIRED FOR SIDE DRAINS, SLOPE DRAINS OR INLETS OF STORM DRAINS THIS CRITERIA MAY BE VARIED WHERE SPECIFIED BY THE DESIGNER OR THE ENGINEER.
- TOEWALLS WILL BE PAID FOR AS CU. YDS. OF CLASS "A" OR "B" CONCRETE. CONTRACTOR MAY ELECT TO CONSTRUCT TOE WALL WITH SAND CEMENT BAG RIPRAP OR STONE RIPRAP TO SAME MINIMUM DIMENSIONS WITH NO ADDITIONAL PAYMENT.
- PRECAST TOEWALLS SHALL BE CL. "A" CONCRETE; CAST-IN-PLACE TOEWALLS MAY BE CL. "A" OR "B" CONCRETE AND MAY BE TRENCH FORMED. WHERE PLANS ITEMIZE ONE CLASS OF CONCRETE AND CONTRACTOR ELECTS TO USE OTHER CLASS, NO ADDITIONAL PAYMENT IS MADE. NO PAYMENT IS MADE FOR STEEL IN TOEWALL.
- CENTERLINE OF FLARED END SECTION WILL ALIGN WITH CENTERLINE OF PIPE, IF PIPE IS SKEWED, THE EMBANKMENT SLOPE WILL BE WARPED TO CONFORM WITH END SECTION.
- FLEXIBLE DELINEATORS SHALL BE REQUIRED AT CROSS DRAIN FLARED END SECTIONS, BOTH INLET AND OUTLET. PAYMENT FOR FLARED END SECTION WILL INCLUDE DELINEATORS. SEE DETAIL AND NOTES BELOW. DELINEATORS NOT REQ'D. FOR SIDE DRAIN, SLOPE DRAIN, OR LONG PIPE.

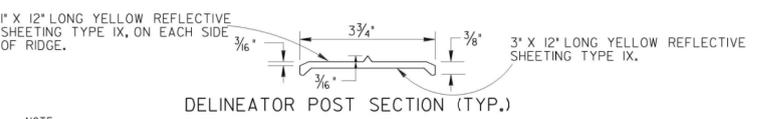

NOTE: DELINATOR POST SHALL CONFORM TO SEC. 911 FOR FLEXIBLE DELINATOR POST EXCEPT REFLECTIVE SHEETING IS NOT REQUIRED AND LENGTH IS 4'-6" FROM TOP TO BOTTOM POINT. ALTERNATES PERMITTED IF APPROVED BY D.O.T. LABORATORY.

SPECIAL NOTE : PIPE SIZES (D) ARE "NOMINAL-MINIMUM" INSIDE DIAMETERS IN ACCORDANCE WITH GEORGIA STANDARD FOR PIPE CULVERTS. "D" DIMENSION FOR FLARED END SECTION SHALL EQUAL THE "D" DIMENSION FOR CONNECTING PIPE CULVERT.

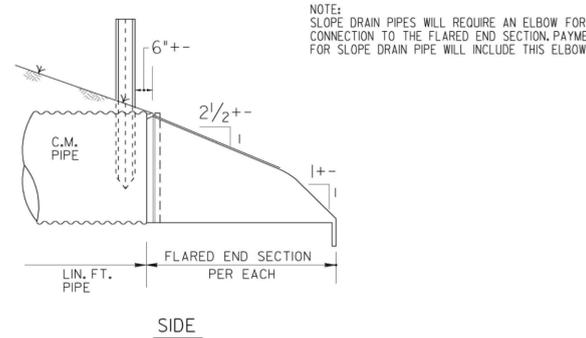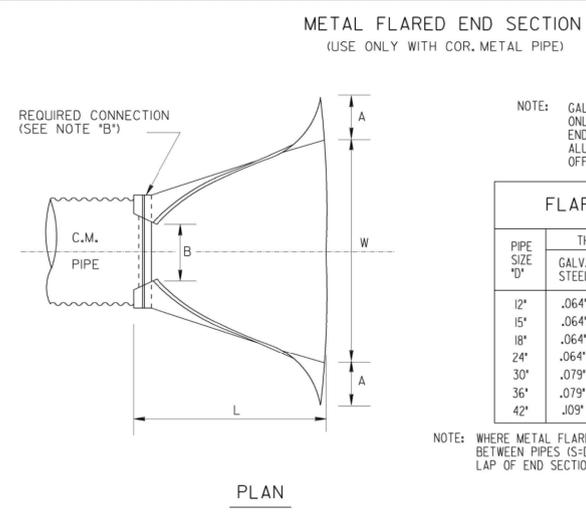

NOTE: GALVANIZED STEEL FLARED END SECTIONS ARE TO BE USED ONLY WITH CORRUGATED STEEL PIPE AND ALUMINUM FLARED END SECTIONS ARE TO BE USED ONLY WITH CORRUGATED ALUMINUM PIPE UNLESS OTHERWISE APPROVED BY D.O.T. OFFICE OF MATERIALS AND TESTS.

PIPE SIZE "D"	THICKNESS		A= 0.4D +/- 1"	B=0.5 D +/- 1"	H=0.25D +/- 1" (MIN. 6")	L=L/6TD +/- 1/2'	W=2.0D +/- 2'
	GALV. STEEL	ALUM.					
12"	.064"	.060"	5'	6'	6'	1'8"	2'0"
15"	.064"	.060"	6'	7'	6'	2'3"	2'6"
18"	.064"	.060"	7'	9'	6'	2'6"	3'0"
24"	.064"	.060"	9'	10'	6'	3'4"	4'0"
30"	.079"	.05"	10'	13'	7'	4'2"	5'0"
36"	.079"	.05"	12'	16'	9'	5'0"	6'0"
42"	.09"	.064"	15'	19'	10'	5'10"	7'0"

NOTE: WHERE METAL FLARED END SECTIONS ARE USED WITH MULTIPLE PIPE LINES, THE STANDARD SPACING BETWEEN PIPES (S=D OR 3 FT.) MAY HAVE TO BE INCREASED (S=1.75 D TYPICAL), TO PREVENT OVERLAP OF END SECTION WINGTIPS. SEE ALSO STD. 10300.

- NOTE "B": THE CONNECTION BETWEEN METAL FLARED END SECTION AND C.M. PIPE WILL BE ONE OF THE FOLLOWING:
- A STRAP BAND OR THREADED ROD PROVIDED BY THE MANUFACTURER WILL LOCK END SECTION ONTO PIPE. A CORRUGATION AT THE PIPE AND WILL BE NON-SPIRALED (PERPENDICULAR TO CL. OF PIPE.)
 - A DIMPLE BAND COLLAR WILL BE SHOP BOLTED TO END SECTION. PIPE WILL BE INSERTED INTO BAND COLLAR TO MEET THE END SECTION.
 - A STUB PIPE WILL BE RIVITED TO THE END SECTION AND THE MAIN PIPE CONNECTED TO THE STUB WITH A NORMAL CONNECTING BAND.
 - OTHER TYPE CONNECTION IF RECOMMENDED BY MANUFACTURER AND APPROVED BY THE D.O.T.

6-9-06		DATE		DEPARTMENT OF TRANSPORTATION STATE OF GEORGIA			
REV. REFLECTIVE SHEETING		REVISION		STANDARD FLARED END SECTIONS FOR PIPES			
NO SCALE		REV. & REDR. SEPT., 1999		NUMBER 1120			
DES. (SUBMITTED) <i>B. H. St.</i>		REV. STATE ROAD & AIRPORT DESIGN ENGINEER		GLO. BY			
RETR. (APPROVED) <i>O. S. Kelly</i>		CHK. CHIEF ENGINEER					

9/6/2006 9:44:21 AM \\GDOT-DSN\GDPLOT\GCF\qo-111f-output.qcf_gomans_M:\GARY\REVISED_1120\1120.dwg

THE LPA GROUP
TRANSPORTATION CONSULTANTS
A UNIT OF MICHAEL BAKER CORPORATION

3595 ENGINEERING DRIVE
NORCROSS, GEORGIA 30092
(770) 263-9118

REVISION DATES	

STATE OF GEORGIA
DEPARTMENT OF TRANSPORTATION
OFFICE: INNOVATIVE PROGRAM DELIVERY
GEORGIA STANDARDS