


8/26/2005 2:56:36 PM \\GDOT-DSN\GDPLOT\DCFC\g0_1111_output.cpl.gawens M:\GARY\Revised 4012C\4012C.plt 60-B06

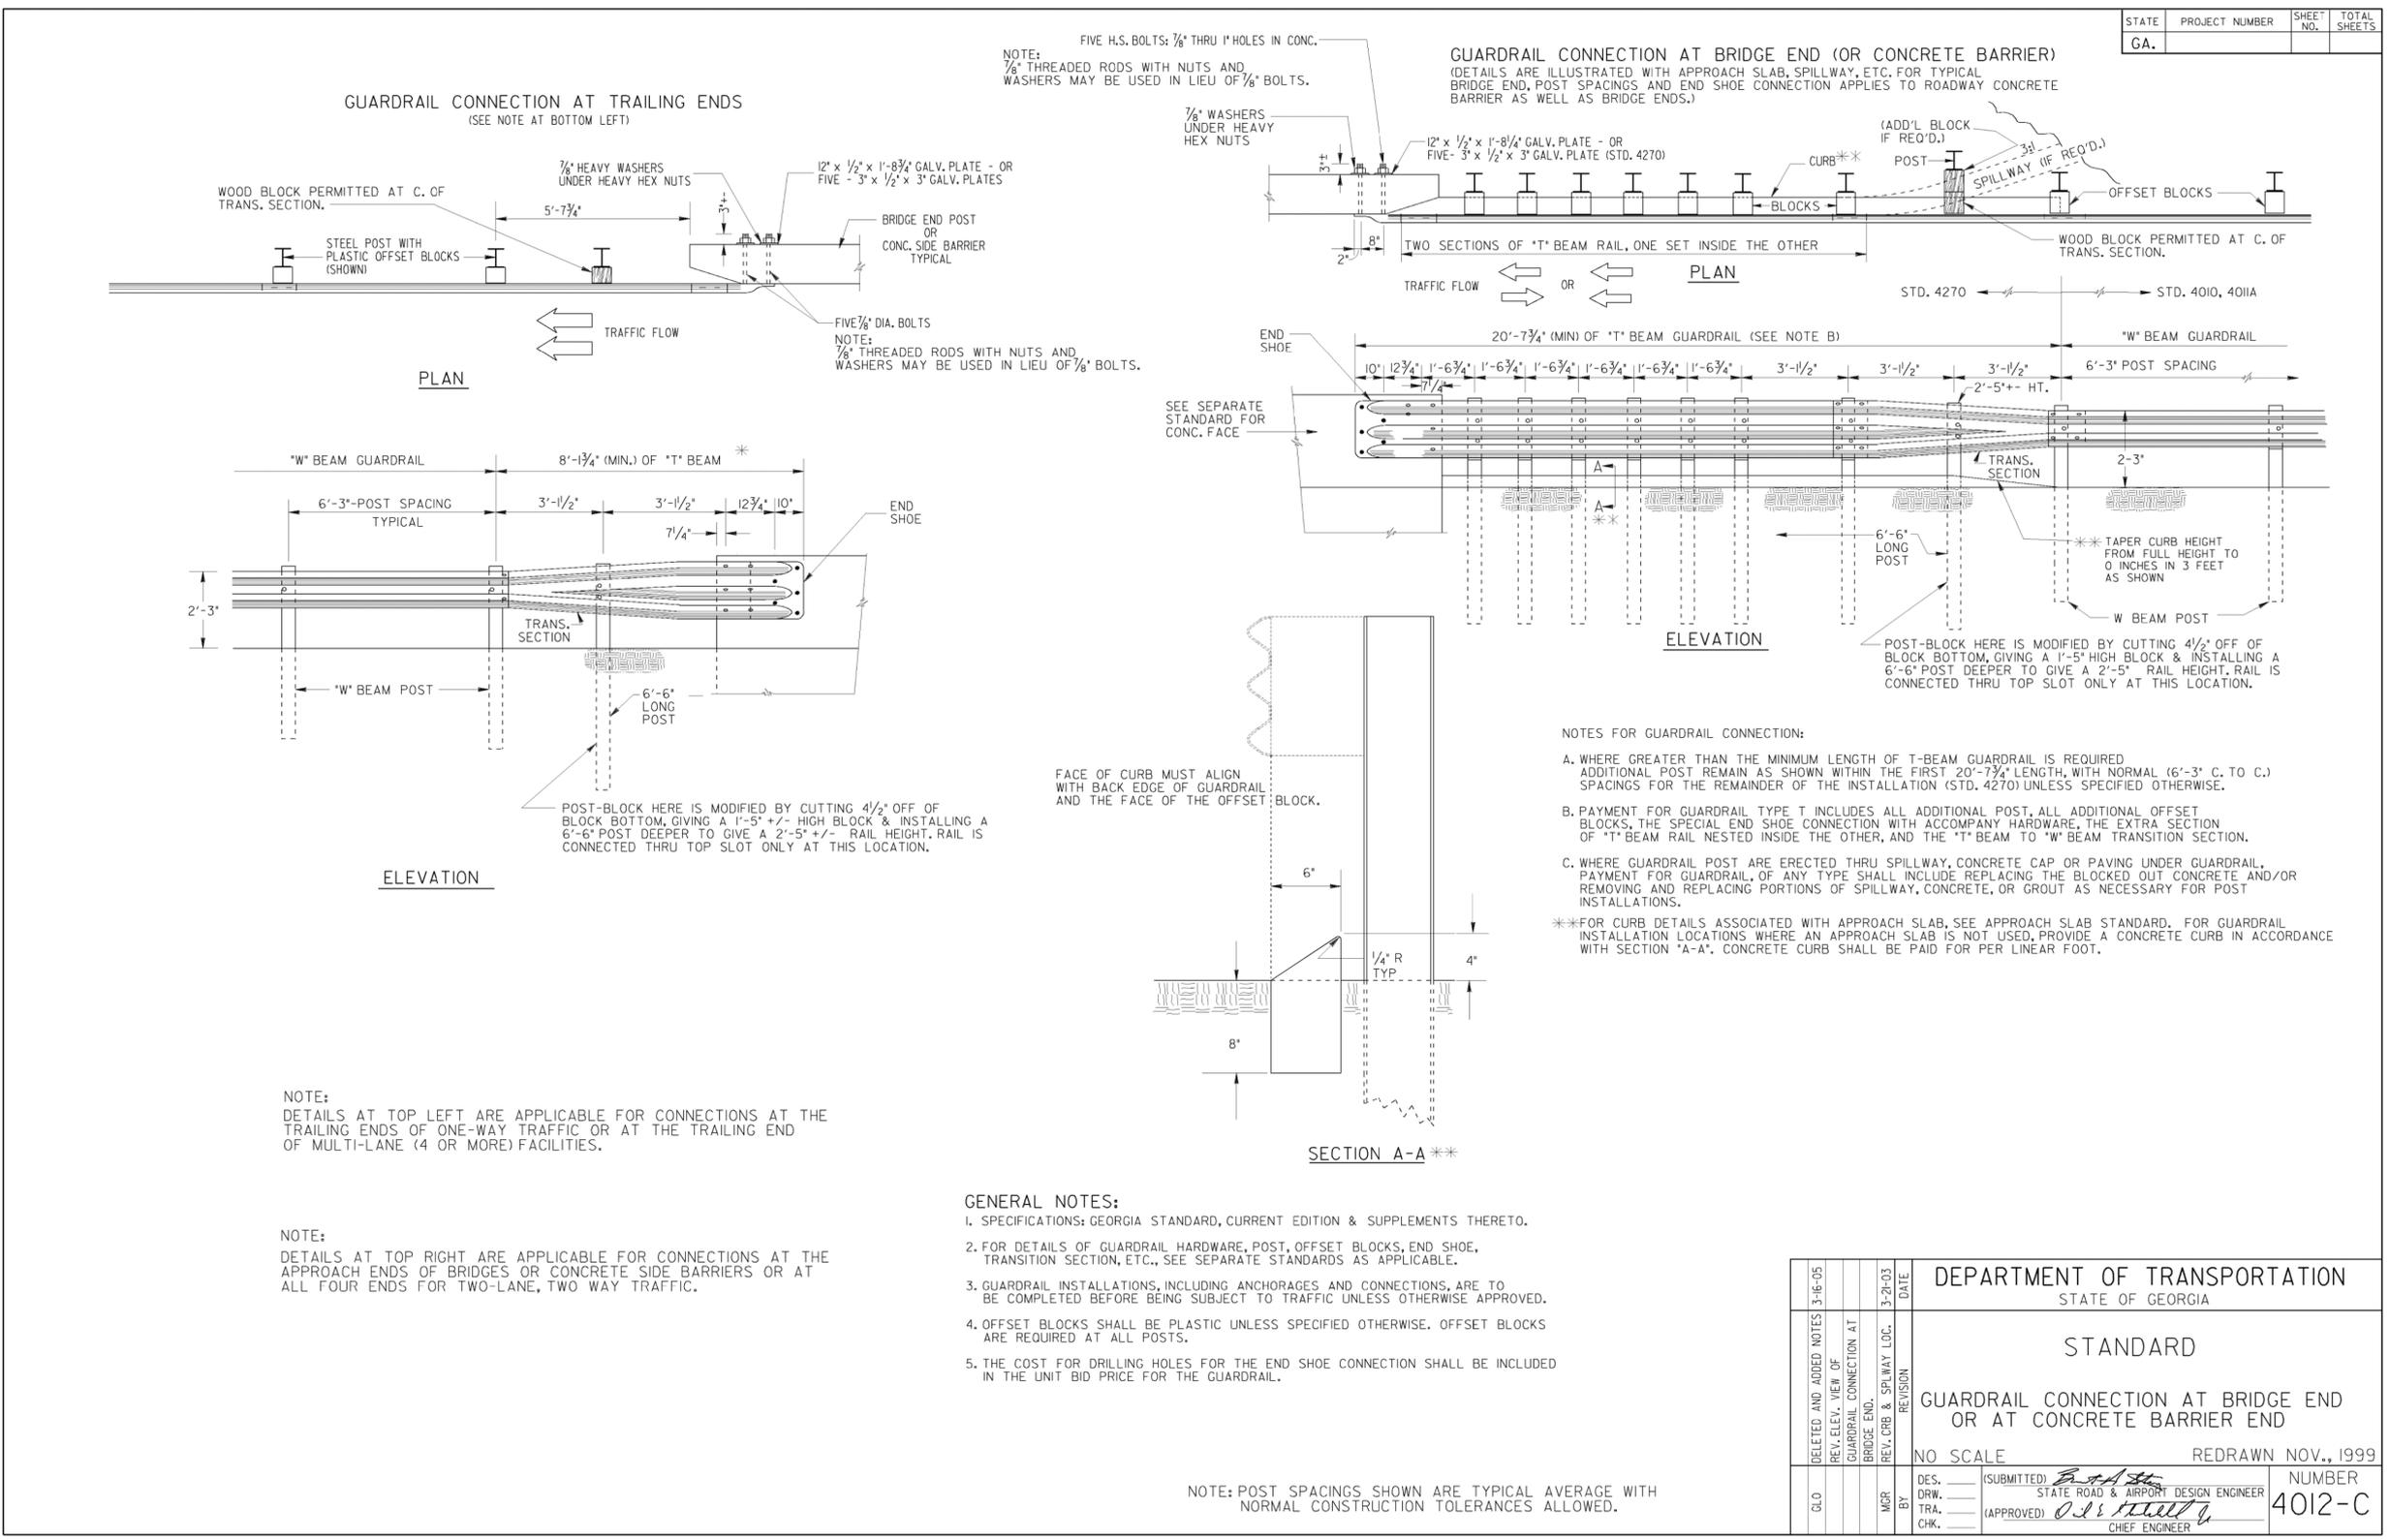

8/26/2005 2:56:36 PM \\GDOT-DSN\GDPLOT\DCFC\g0_1111_output.cpl.gawens M:\GARY\Revised 4012C\4012C.plt 60-B06

AS-BUILT PLANS - 08/30/13

DELETED AND ADDED NOTES	3-16-05	DEPARTMENT OF TRANSPORTATION STATE OF GEORGIA
REV. ELEV. VIEW OF GUARDRAIL CONNECTION AT BRIDGE END.	3-21-03	
REV. CURB & SPLWAY LOC.	DATE	STANDARD
NO SCALE	REDRAWN NOV., 1999	GUARDRAIL CONNECTION AT BRIDGE END OR AT CONCRETE BARRIER END
DES. (SUBMITTED) <i>B.H.H.</i>	NUMBER	4012-C
DRW. STATE ROAD & AIRPORT DESIGN ENGINEER		
TR. (APPROVED) <i>O.S. Smith</i>		
CHK. CHIEF ENGINEER		

THE LPA GROUP
TRANSPORTATION CONSULTANTS
A UNIT OF MICHAEL BAKER CORPORATION
3595 ENGINEERING DRIVE
NORCROSS, GEORGIA 30092
(770) 263-9118

REVISION DATES

STATE OF GEORGIA
DEPARTMENT OF TRANSPORTATION
OFFICE: INNOVATIVE PROGRAM DELIVERY
GEORGIA STANDARDS

DRAWING No. 41-017