



AS-BUILT PLANS - 08/30/13

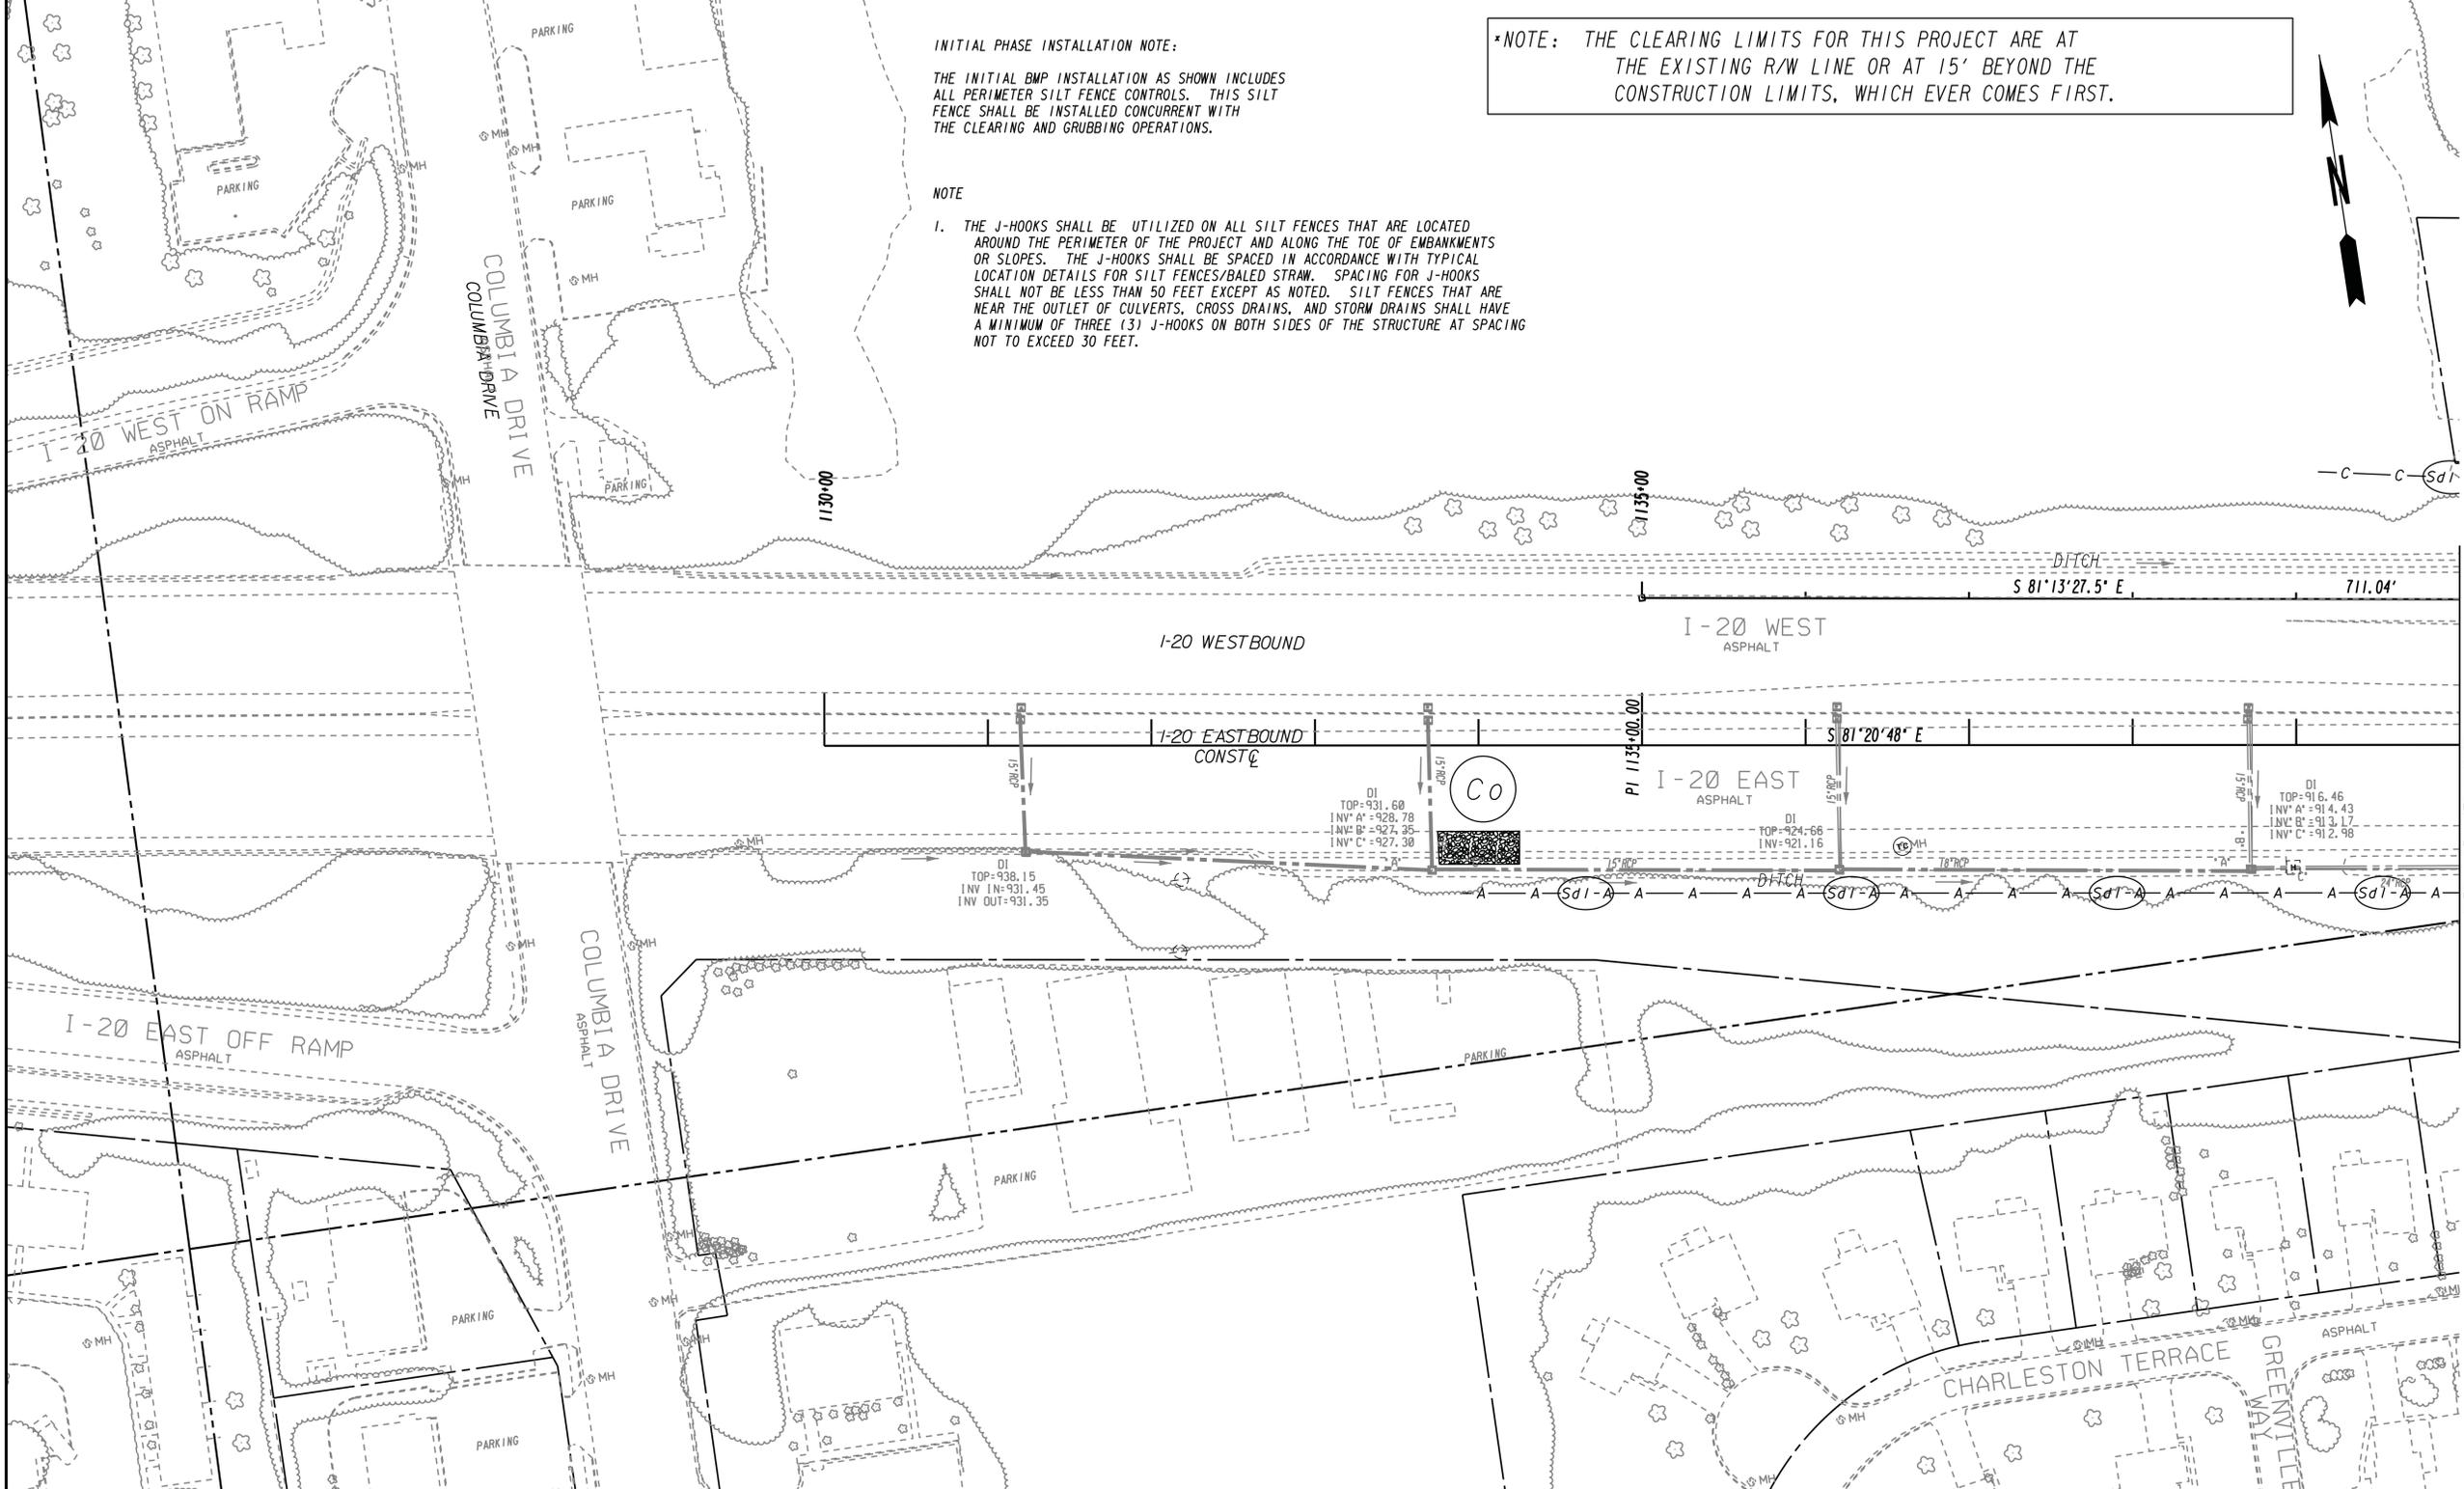

LEGEND

PAVEMENT REMOVAL	
TEMPORARY CONSTRUCTION PAVEMENT	
PERMANENT CONSTRUCTION	
CONCRETE MEDIUM CONSTRUCTION	
MILL & OVERLAY CONSTRUCTION	
OPEN LANES OF TRAFFIC	

THE LPA GROUP
 TRANSPORTATION CONSULTANTS
 A UNIT OF CHARLACK BAKER CORPORATION
 3595 ENGINEERING DRIVE
 NORCROSS, GEORGIA 30092
 (770) 263-9118

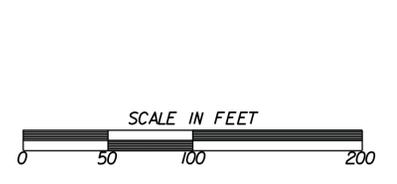

REVISION DATES

STATE OF GEORGIA
 DEPARTMENT OF TRANSPORTATION
 OFFICE: INNOVATIVE PROGRAM DELIVERY
BMP LOCATION DETAILS
 INITIAL PHASE
 I-20 EASTBOUND CD LANES
 I-285 TO PANOLA ROAD

DRAWING No. **54-001**