


**AS-BUILT PLANS - 08/30/13**

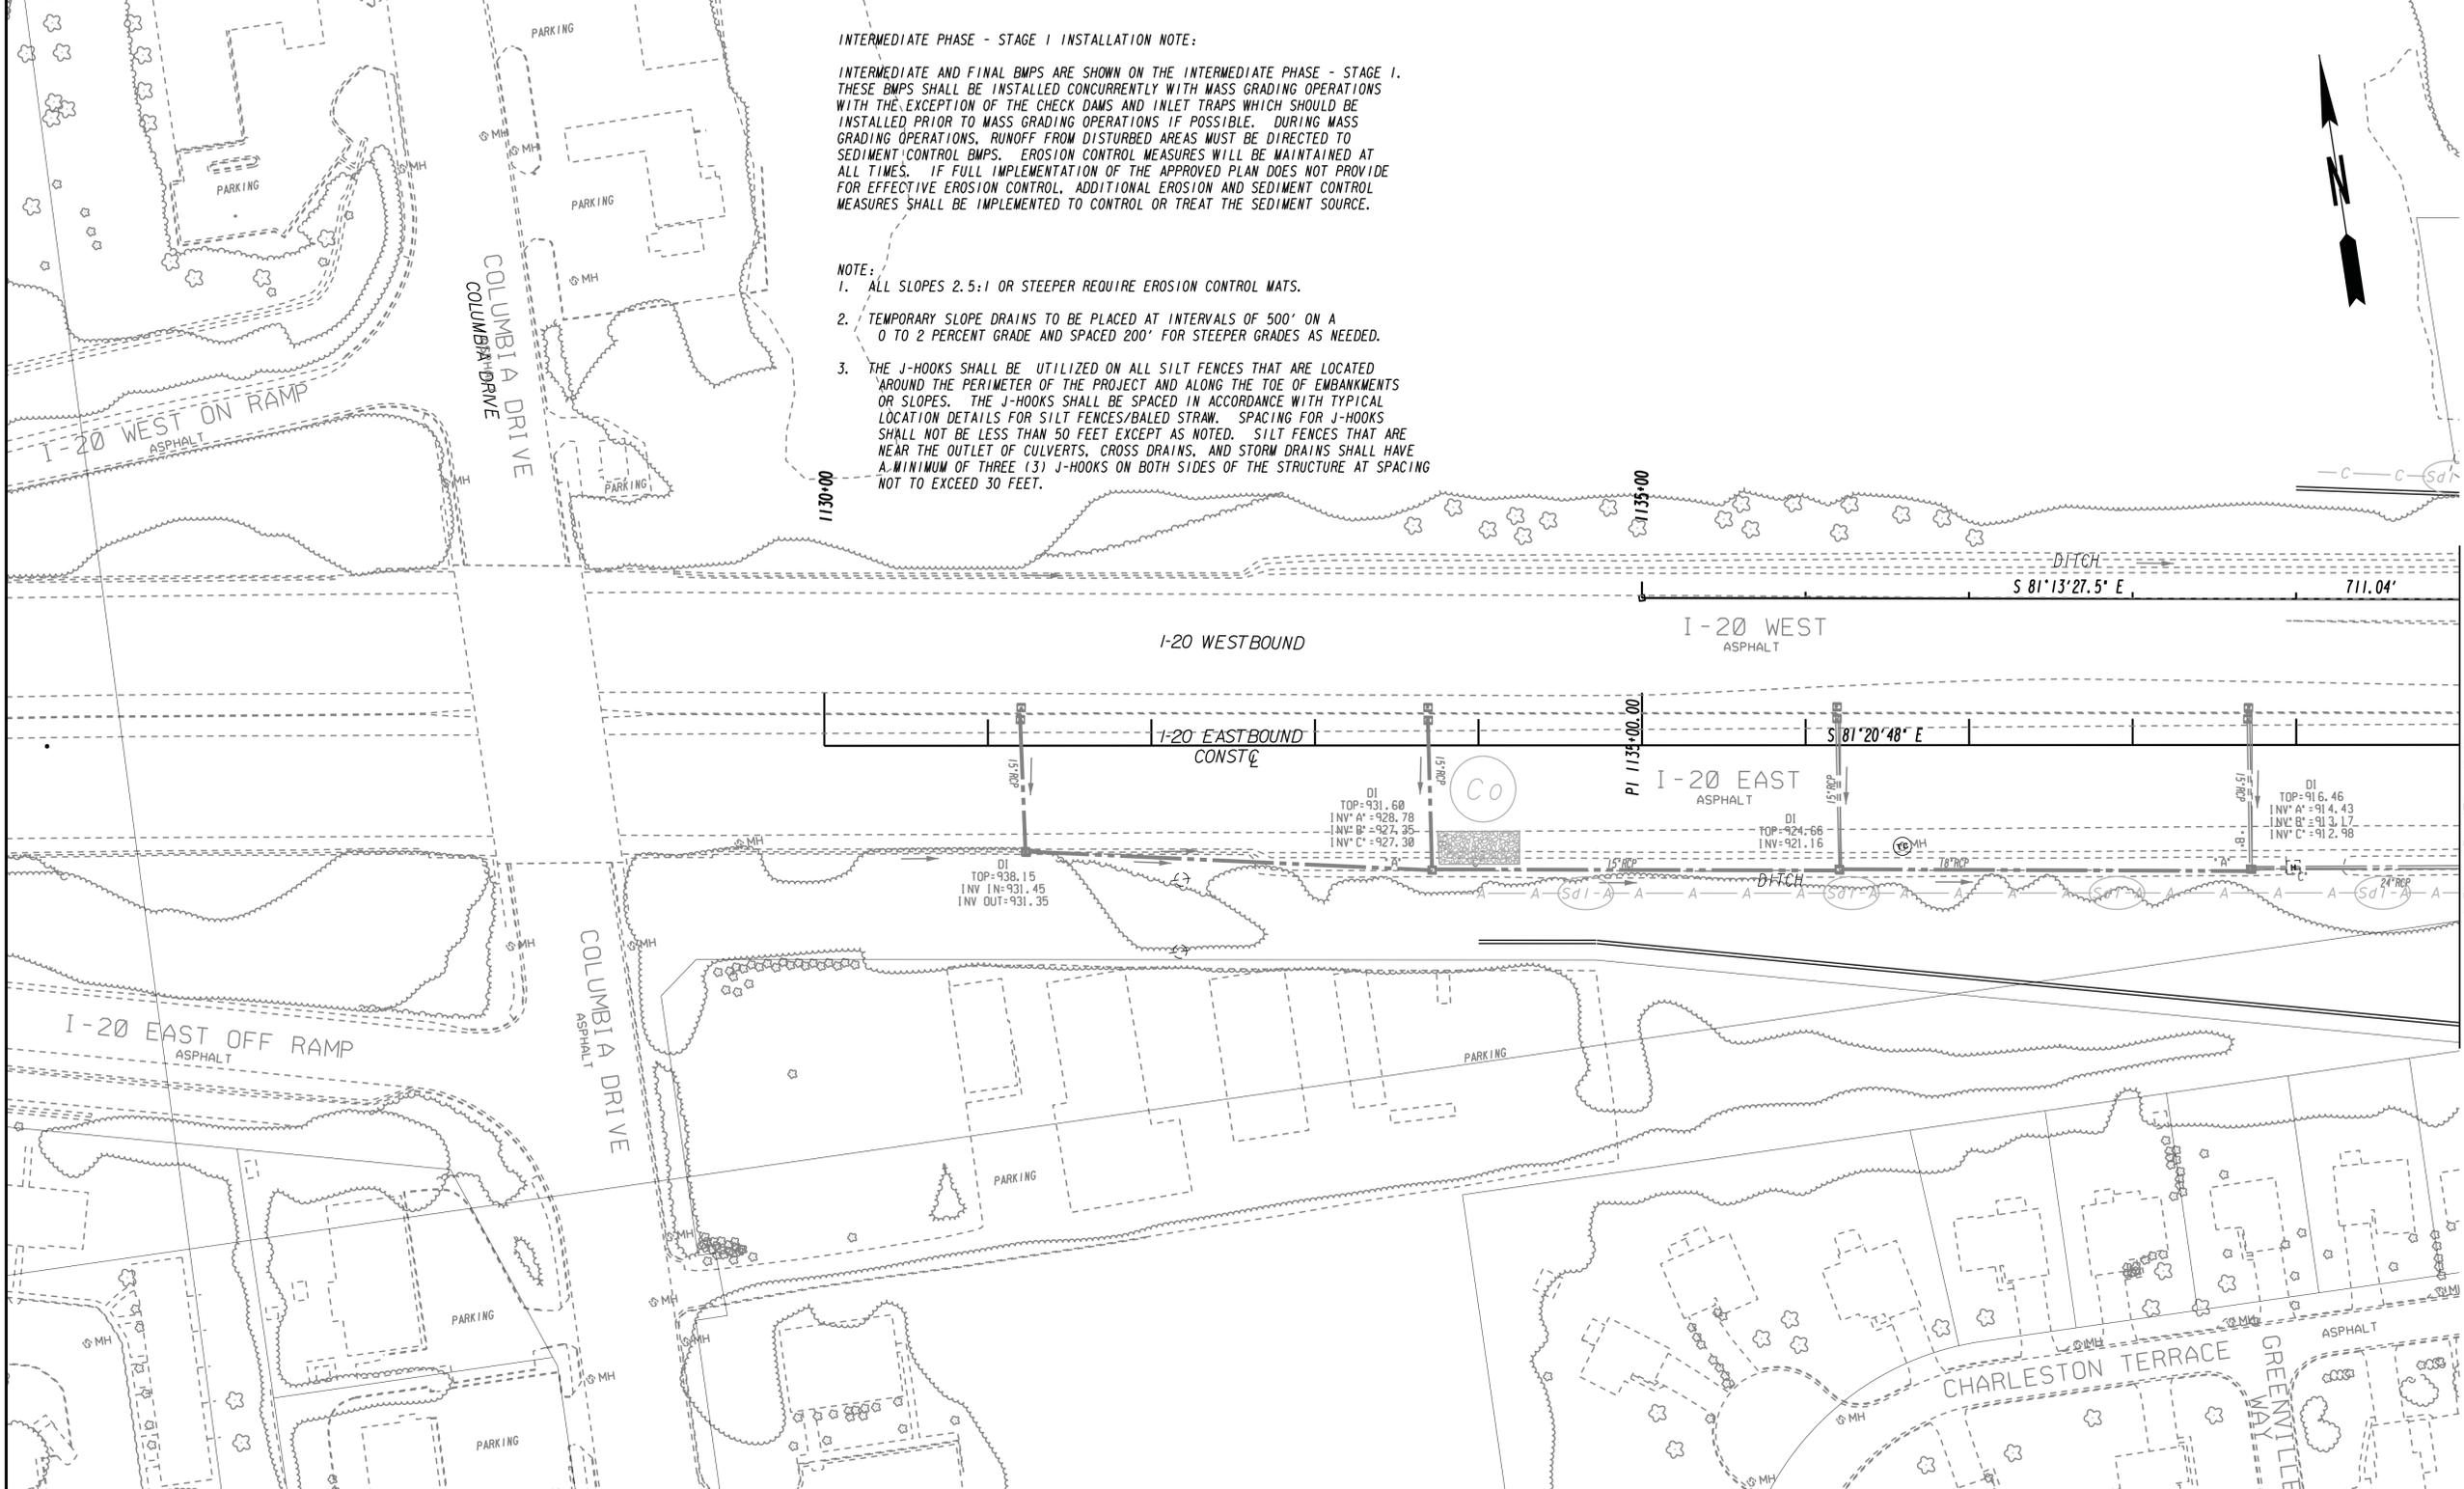

	<p>SCALE IN FEET</p>	<p>REVISION DATES</p> <table border="1"> <tr><td> </td><td> </td><td> </td></tr> <tr><td> </td><td> </td><td> </td></tr> <tr><td> </td><td> </td><td> </td></tr> </table>										<p>STATE OF GEORGIA                  DEPARTMENT OF TRANSPORTATION                  OFFICE: INNOVATIVE PROGRAM DELIVERY  <b>BMP LOCATION DETAILS</b>                  INTERMEDIATE PHASE - STAGE 1                  I-20 EASTBOUND CD LANES                  I-285 TO PANOLA ROAD</p>
<p>DRAWING No.  <b>54-021</b></p>												