


DEPARTMENT OF TRANSPORTATION STATE OF GEORGIA

PLAN AND PROFILE OF PROPOSED SR 400 FROM MCGINNIS FERRY RD TO BIG CREEK GREENWAY - NB LANE EXTENSION

FORSYTH AND FULTON COUNTIES

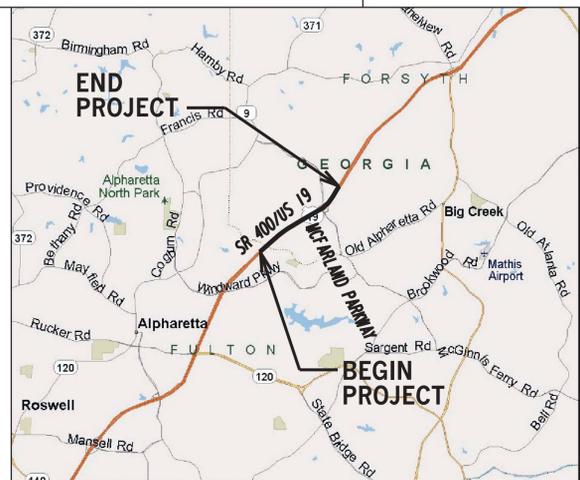

LOCATION SKETCH

DESIGN DATA:
 TRAFFIC A.D.T.: 48,000 (2012)
 TRAFFIC A.D.T.: 65,625 (2032)
 TRAFFIC D.H.V.: 5,350 (2032)
 DIRECTIONAL DIST: N/A
 % TRUCKS: 3.5%
 24 HR. TRUCKS %: 6.0%
 SPEED DESIGN: 65 MPH

LOCATION & DESIGN APPROVAL DATE:
 FUNCTIONAL CLASS:
 URBAN FREEWAY AND EXPRESSWAY
 THIS PROJECT IS 94% IN FORSYTH COUNTY AND 94% IN CONG. DIST. NO. 9, AND IS 6% IN FULTON COUNTY AND 6% IN CONG. DIST. NO. 6.
 PROJECT DESIGNATION:
 DESIGNED IN ENGLISH UNITS.

THIS PROJECT HAS BEEN PREPARED USING THE HORIZONTAL GEORGIA COORDINATE SYSTEM OF 1984 (NAD 1983/94 WEST ZONE, AND THE NORTH AMERICAN VERTICAL DATUM (NAVD) OF 1988.

QC/QA Tracking Stamp		
	Initials	Date
Design	Designer: JP	6/01/2012
	Checker: TM	6/04/2012
	Backchecked: BG	6/07/2012
	Drafted: JP	6/13/2012
	Verified: TM	6/13/2012
RFC	Drafted: JP	6/26/2012
	Verified: TM	6/26/2012

THE DATA, TOGETHER WITH ALL OTHER INFORMATION SHOWN ON THESE PLANS OR IN ANYWAY INDICATED THEREBY, WHETHER BY DRAWINGS OR NOTES, OR IN ANY OTHER MANNER, ARE BASED UPON FIELD INVESTIGATIONS AND ARE BELIEVED TO BE INDICATIVE OF ACTUAL CONDITIONS. HOWEVER, THE SAME ARE SHOWN AS INFORMATION ONLY, ARE NOT GUARANTEED, AND DO NOT BIND THE DEPARTMENT OF TRANSPORTATION IN ANY WAY. THE ATTENTION OF BIDDER IS SPECIFICALLY DIRECTED TO SUBSECTIONS 102.04, 102.05, AND 104.03 OF THE SPECIFICATIONS.

AS-BUILT PLANS 01/18/2013

FEDERAL ROUTE * US 19
 STATE ROUTE * SR 400
 P.J. NO. 0010290

NOTE:
 ALL REFERENCES IN THIS DOCUMENT, WHICH INCLUDES ALL PAPERS, WRITINGS, DOCUMENTS, DRAWINGS, OR PHOTOGRAPHS USED, OR TO BE USED IN CONNECTION WITH THIS DOCUMENT, TO "STATE HIGHWAY DEPARTMENT OF GEORGIA," "STATE HIGHWAY DEPARTMENT," "GEORGIA STATE HIGHWAY DEPARTMENT," "HIGHWAY DEPARTMENT," OR "DEPARTMENT" WHEN THE CONTEXT THEREOF MEANS THE STATE HIGHWAY DEPARTMENT OF GEORGIA, AND SHALL BE DEEMED TO MEAN THE DEPARTMENT OF TRANSPORTATION.

THIS PLAN SET IS SEALED ONLY FOR THE AS-BUILT CONDITIONS DOCUMENTED THROUGH THE R.F.J. AND RED LINE PROCESS BY THE CONTRACTOR. THIS DOCUMENT WAS ORIGINALLY SEALED BY DONALD TYLER MCINTOSH, LICENSE NO. PE035090 ON JUNE 29, 2012.


THIS MEDIA SHALL NOT BE CONSIDERED A CERTIFIED DOCUMENT AS TO THE ORIGINAL DOCUMENT BUT CERTIFIED ONLY AS TO THE REVISIONS.



PREPARED BY: THE LPA GROUP, INC.
DESIGN

RECOMMENDED FOR SUBMISSION BY: DESIGN

SUBMITTED BY: INNOVATIVE PROGRAM DELIVERY ENGINEER

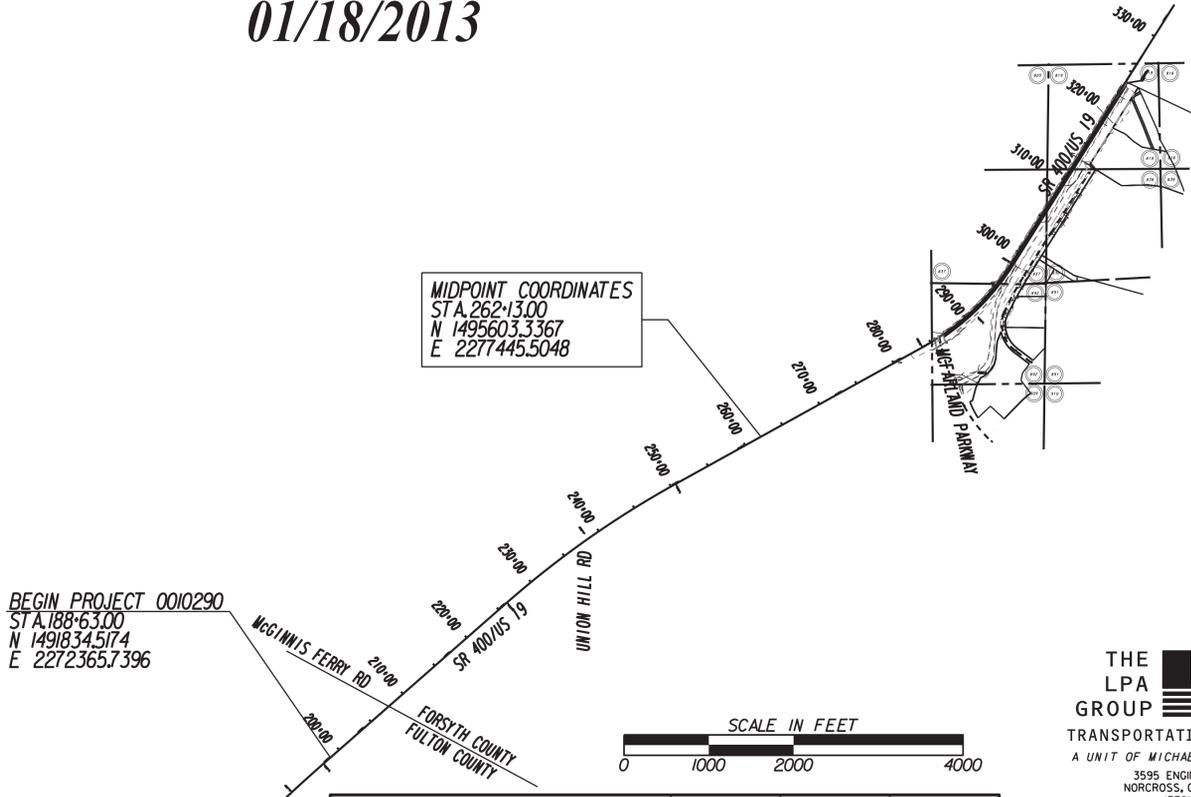

END PROJECT 0010290
 STA. 323+68.00
 N 1499772.4951
 E 2281749.9369



LENGTH OF PROJECT	FULTON COUNTY No. 121	FORSYTH COUNTY No. 117	Project No. 0010290 TOTAL
	MILES	MILES	MILES
NET LENGTH OF ROADWAY	2.3845	0.1733	2.5578
NET LENGTH OF BRIDGES	0.0000	0.0000	0.0000
NET LENGTH OF PROJECT	2.3845	0.1733	2.5578
NET LENGTH OF EXCEPTIONS	0.0000	0.0000	0.0000
GROSS LENGTH OF PROJECT	2.3845	0.1733	2.5578

THE LPA GROUP
 TRANSPORTATION CONSULTANTS
 A UNIT OF MICHAEL BAKER CORPORATION
 3595 ENGINEERING DRIVE
 NORCROSS, GEORGIA 30092
 (770) 263-9118

GEORGIA
DEPARTMENT
OF
TRANSPORTATION

DRAWING No. 1-01

7/2/2012	QaOMR
DATE	CHIEF ENGINEER
PLANS COMPLETED	06-29-2012
REVISIONS	01-18-2013
SHEETS:	1, 2, 3, 8A, 19