


# DEPARTMENT OF TRANSPORTATION STATE OF GEORGIA

## AS-BUILT PLANS SAFE ROUTES TO SCHOOLS DESIGN-BUILD PROJECT DEKALB COUNTY FEDERAL AID PROJECT

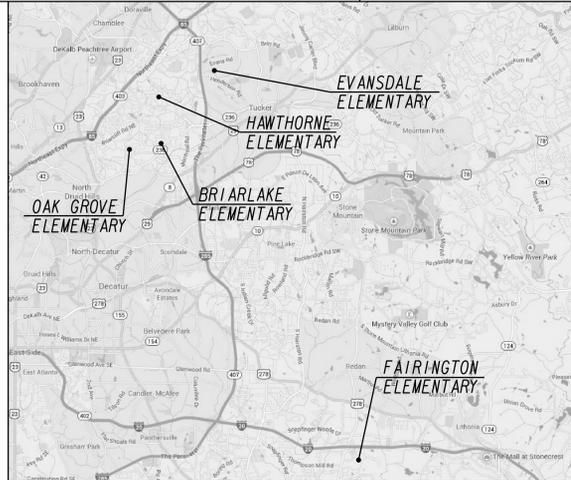

LOCATION SKETCH

NOTE :  
ALL REFERENCES IN THIS DOCUMENT, WHICH INCLUDES ALL PAPERS, WRITINGS, DOCUMENTS, DRAWINGS, OR PHOTOGRAPHS USED, OR TO BE USED IN CONNECTION WITH THIS DOCUMENT, TO "STATE HIGHWAY DEPARTMENT OF GEORGIA," "STATE HIGHWAY DEPARTMENT," "GEORGIA STATE HIGHWAY DEPARTMENT," "HIGHWAY DEPARTMENT," OR "DEPARTMENT" WHEN THE CONTEXT THEREOF MEANS THE STATE HIGHWAY DEPARTMENT OF GEORGIA, AND SHALL BE DEEMED TO MEAN THE DEPARTMENT OF TRANSPORTATION.

FEDERAL ROUTE \* N/A  
STATE ROUTE \* 236  
P.J. NO. 0010394

PLANS PREPARED BY  
**MULKEY**  
ENGINEERS & CONSULTANTS  
1255 CANTON STREET, SUITE G  
ROSWELL, GEORGIA 30075  
(678) 461-3511



PREPARED BY:

DESIGN

LOCATION & DESIGN  
APPROVAL DATE: N/A

FUNCTIONAL CLASS: N/A


THIS PROJECT IS 100% IN  
DEKALB COUNTY AND IS  
80% IN CONG. DIST. NO. 6,  
20% IN CONG. DIST. NO. 4.

PROJECT DESIGNATION: EXEMPT  
DESIGNED IN ENGLISH UNITS.


THIS PROJECT HAS BEEN PREPARED  
USING THE HORIZONTAL GEORGIA  
COORDINATE SYSTEM OF 1984 (NAD  
1983/94 WEST ZONE, AND THE NORTH  
AMERICAN VERTICAL DATUM (NAVD)  
OF 1988.

AS-BUILT


THE DATA TOGETHER WITH ALL OTHER INFORMATION SHOWN ON THESE PLANS OR IN ANYWAY INDICATED THEREBY, WHETHER BY DRAWINGS OR NOTES, OR IN ANY OTHER MANNER, ARE BASED UPON FIELD INVESTIGATIONS AND ARE BELIEVED TO BE INDICATIVE OF ACTUAL CONDITIONS. HOWEVER, THE SAME ARE SHOWN AS INFORMATION ONLY, ARE NOT GUARANTEED, AND DO NOT BIND THE DEPARTMENT OF TRANSPORTATION IN ANY WAY. THE ATTENTION OF BIDDER IS SPECIFICALLY DIRECTED TO SUBSECTIONS 102.04, 102.05, AND 104.03 OF THE SPECIFICATIONS.

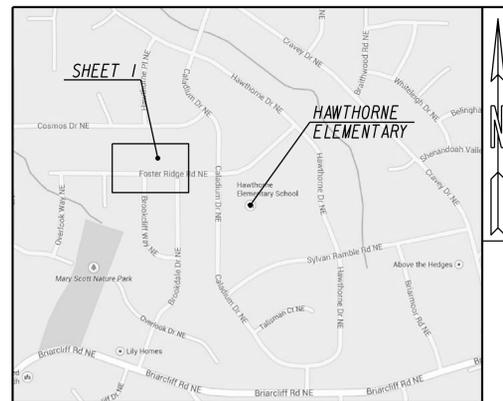


HAWTHORNE ELEMENTARY

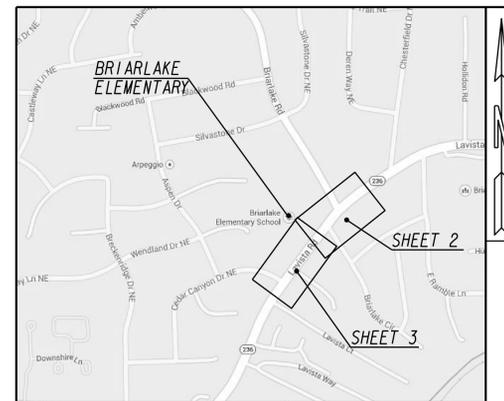


BRIARLAKE ELEMENTARY

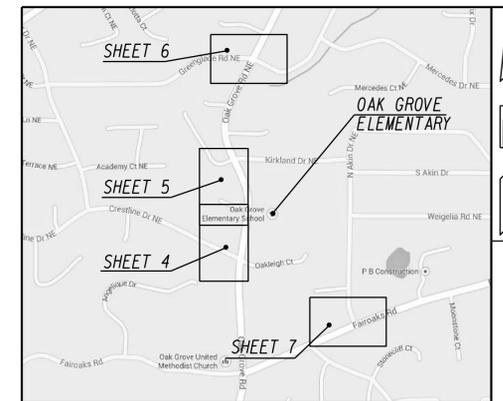

OAK GROVE ELEMENTARY

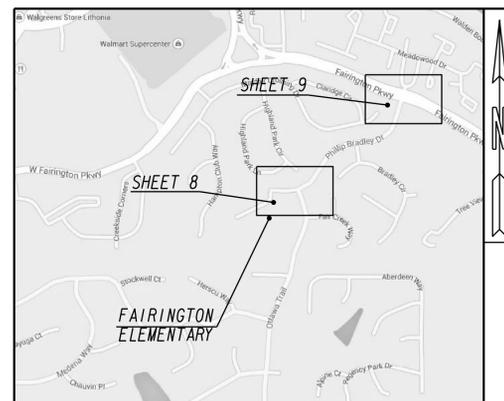

FAIRINGTON ELEMENTARY

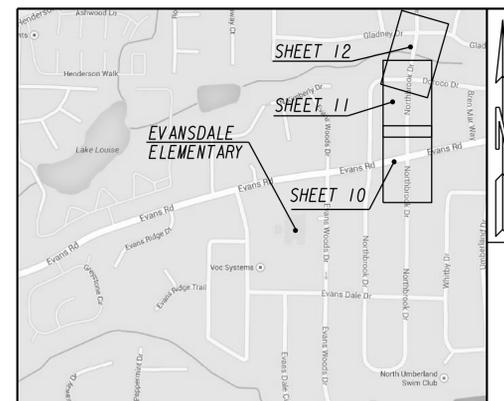

EVANSDALE ELEMENTARY

DATE	CHIEF ENGINEER
AS-BUILT PLANS COMPLETED 02-19-2016	
REVISIONS	