


DEPARTMENT OF TRANSPORTATION STATE OF GEORGIA

AS-BUILT PLANS SAFE ROUTES TO SCHOOLS DESIGN BUILD BETHUNE ELEMENTARY SCHOOL FULTON COUNTY FEDERAL AID PROJECT

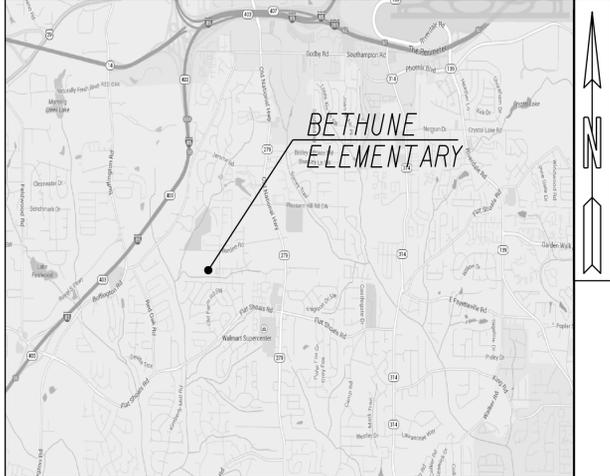

LOCATION SKETCH

NOTE :
ALL REFERENCES IN THIS DOCUMENT, WHICH INCLUDES ALL PAPERS, WRITINGS, DOCUMENTS, DRAWINGS, OR PHOTOGRAPHS USED, OR TO BE USED IN CONNECTION WITH THIS DOCUMENT, TO "STATE HIGHWAY DEPARTMENT OF GEORGIA," "STATE HIGHWAY DEPARTMENT," "GEORGIA STATE HIGHWAY DEPARTMENT," "HIGHWAY DEPARTMENT," OR "DEPARTMENT" WHEN THE CONTEXT THEREOF MEANS THE STATE HIGHWAY DEPARTMENT OF GEORGIA, AND SHALL BE DEEMED TO MEAN THE DEPARTMENT OF TRANSPORTATION.



FEDERAL ROUTE * N/A
STATE ROUTE * N/A
P.J. NO. 0010403


PLANS PREPARED BY
MULKEY
ENGINEERS & CONSULTANTS
1255 CANTON STREET, SUITE G
ROSWELL, GEORGIA 30075
(678) 461-3511



PREPARED BY: _____
DESIGN

LOCATION & DESIGN APPROVAL DATE: N/A
FUNCTIONAL CLASS: N/A
THIS PROJECT IS 100% IN FULTON COUNTY AND IS 100% IN CONG. DIST. NO. 13.
PROJECT DESIGNATION: EXEMPT DESIGNED IN ENGLISH UNITS.

THIS PROJECT HAS BEEN PREPARED USING THE HORIZONTAL GEORGIA COORDINATE SYSTEM OF 1984 (NAD 1983/94 WEST ZONE, AND THE NORTH AMERICAN VERTICAL DATUM (NAVD) OF 1988.

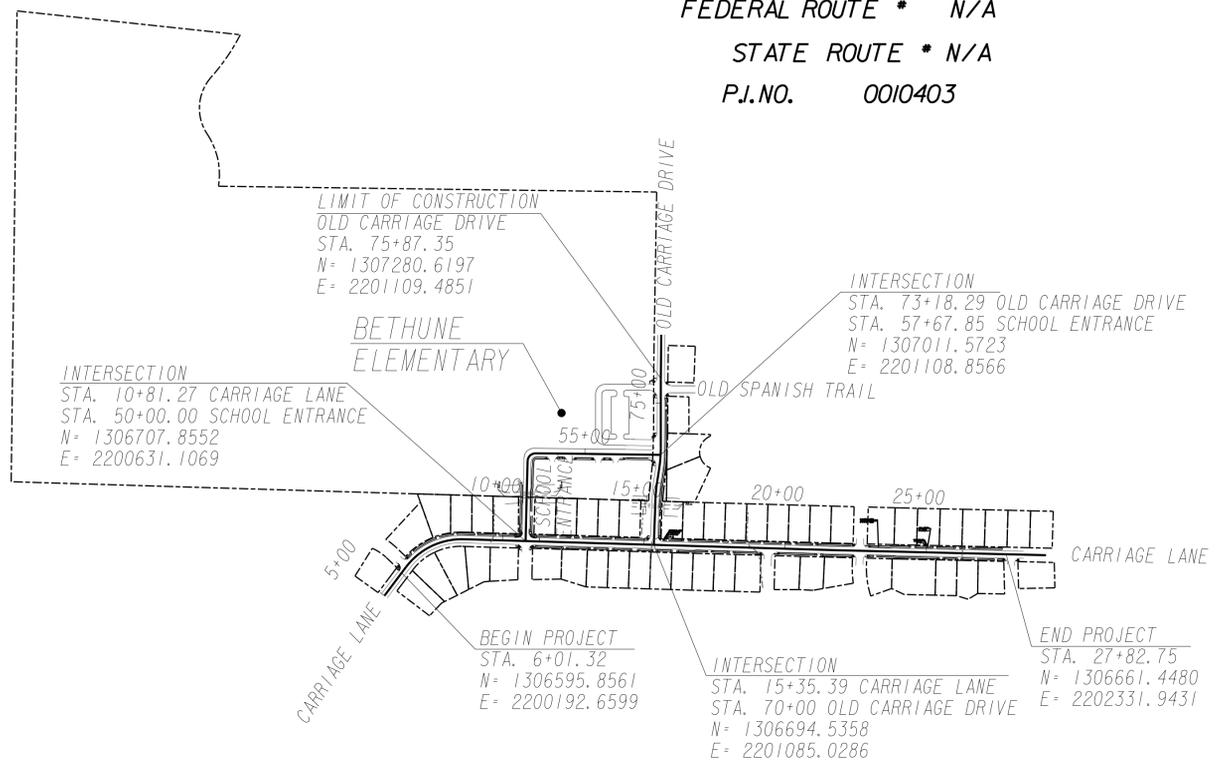

AS-BUILT

THE DATA, TOGETHER WITH ALL OTHER INFORMATION SHOWN ON THESE PLANS OR IN ANYWAY INDICATED THEREBY, WHETHER BY DRAWINGS OR NOTES, OR IN ANY OTHER MANNER, ARE BASED UPON FIELD INVESTIGATIONS AND ARE BELIEVED TO BE INDICATIVE OF ACTUAL CONDITIONS. HOWEVER, THE SAME ARE SHOWN AS INFORMATION ONLY, ARE NOT GUARANTEED, AND DO NOT BIND THE DEPARTMENT OF TRANSPORTATION IN ANY WAY. THE ATTENTION OF BIDDER IS SPECIFICALLY DIRECTED TO SUBSECTIONS 102.04, 102.05, AND 104.03 OF THE SPECIFICATIONS.

LENGTH OF PROJECT COUNTY: FULTON	COUNTY No. 121 Project No. 0010403
	MILES
NET LENGTH OF ROADWAY	0.00
NET LENGTH OF BRIDGES	0.00
NET LENGTH OF PROJECT	0.67
NET LENGTH OF EXCEPTIONS	0.00
GROSS LENGTH OF PROJECT	0.67

DATE	CHIEF ENGINEER
AS-BUILT PLANS COMPLETED	02-19-2016
REVISIONS	

DRAWING No.
01-001