

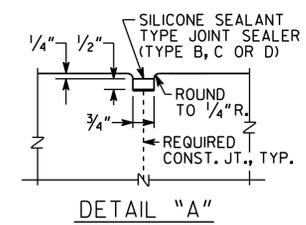
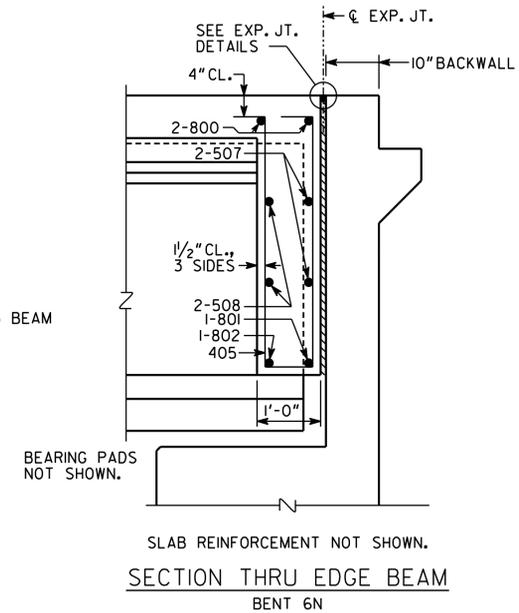
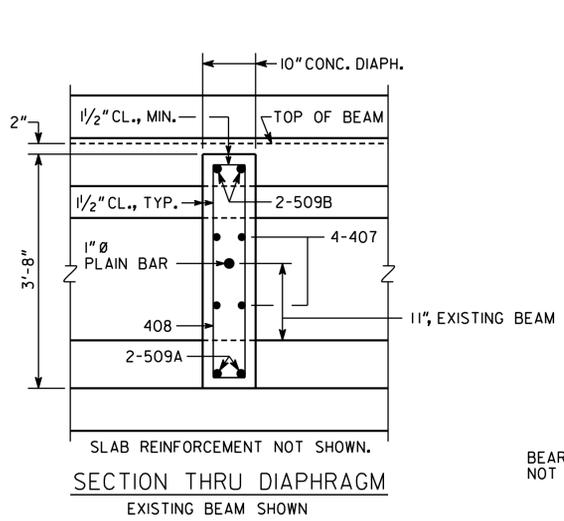
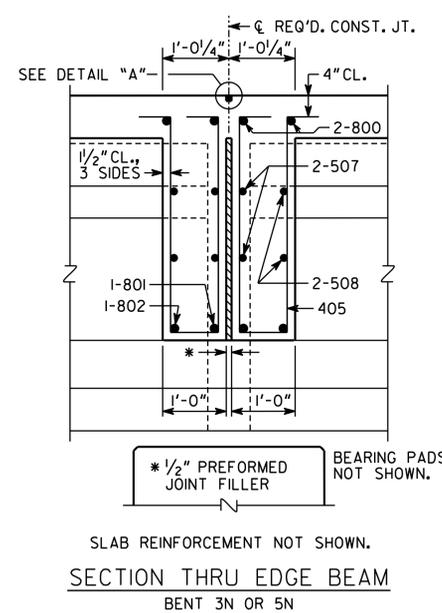
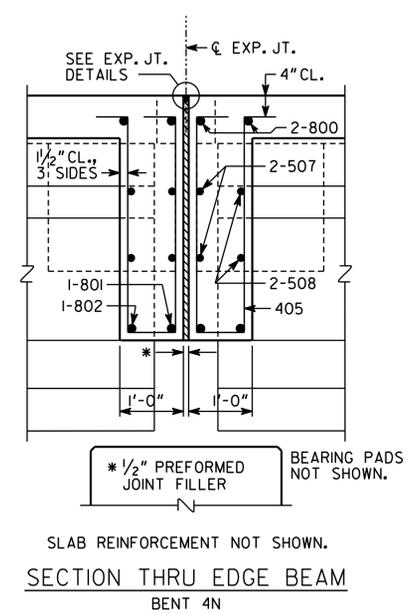
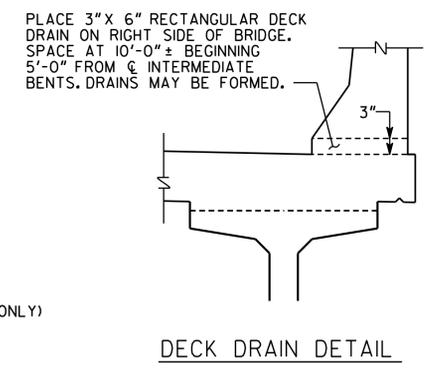
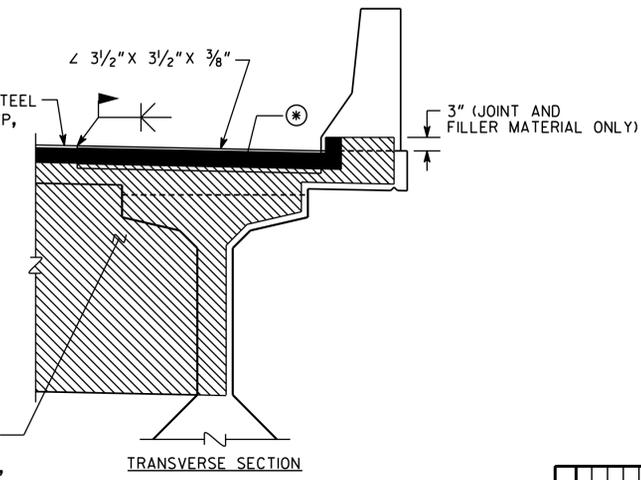


STATE	PROJECT NUMBER	SHEET NO.	TOTAL SHEETS
GA.	NH000-0085-02(153)	178	480

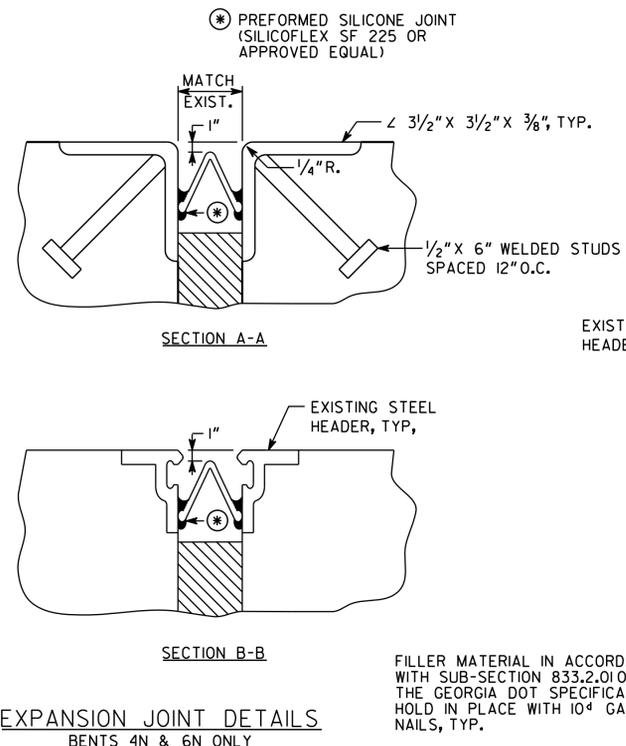

SEE BRIDGE SHEET 15A FOR NEW DOWEL PIN LOCATION AND REMEDIAL EDGE BEAM DETAILS.

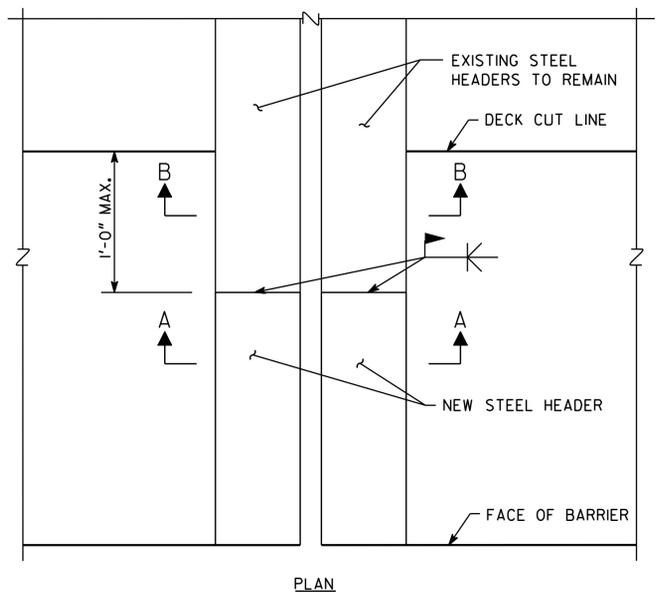

- NOTES:
- DO NOT CUT EXISTING STEEL EXPANSION JOINT HEADERS AT DECK CUT LINE AT BENTS 4N AND 6N. CHIP CONCRETE AWAY FROM EXISTING HEADERS IN PORTIONS OF DECK TO BE REMOVED. EXTEND EXISTING STEEL HEADERS AT BENTS 4N AND 6N WITH THE DETAIL SHOWN ABOVE. CONNECT THE TOP FLANGES OF EXISTING AND NEW STEEL HEADERS PRIOR TO CASTING DECK WITH A FULL PENETRATION BEVEL WELD. GRIND ALL WELDS, BURRS AND DEFECTS AT ALL STEEL EXPANSION JOINT HEADERS TO PROVIDE A SMOOTH RIDING SURFACE.
  - SEE SPECIAL PROVISION - SECTION 449 "BRIDGE DECK JOINT SEALS" FOR FURTHER REQUIREMENTS.
  - INCLUDE ALL COSTS ASSOCIATED WITH FURNISHING LABOR, MATERIALS, FABRICATION AND INSTALLATION OF PREFORMED SILICONE SEALS COMPLETE AND IN PLACE IN THE UNIT PRICE BID FOR PAY ITEM 449-I350.
  - STEEL EXPANSION JOINT HEADERS SHALL BE ASTM A709, GRADE 50W STEEL.

FILLER MATERIAL IN ACCORDANCE WITH SUB-SECTION 833.2.01 OF THE GEORGIA DOT SPECIFICATIONS, HOLD IN PLACE WITH 10<sup>4</sup> GALV. NAILS, TYP.

**AS-BUILT**

DRAWING NO.	35.1 - 8
BRIDGE SHEET	8 OF 20

DATE	REVISIONS	BY	DESIGNED	BKA	CHECKED	GBL	REVIEWED	
			DRAWN	BRW	DESIGN GROUP		APPROVED	

BRIDGE NO. 1

**GA** **HL**

GEORGIA  
DEPARTMENT OF TRANSPORTATION  
ENGINEERING DIVISION-OFFICE OF BRIDGES AND STRUCTURES

MISCELLANEOUS DETAILS  
I-85 SOUTHBOUND TO SR 400 NORTHBOUND  
SR 400/I-85 CONNECTOR RAMPS OVER LENOX  
ROAD AND NORTH FORK PEACHTREE CREEK  
FULTON COUNTY NH000-0085-02(153)

SCALE: NONE FEBRUARY 2012