



AS-BUILT FOUNDATION INFORMATION			
BENT	PILE LOCATION	PILE TIP ELEVATION	BOTTOM OF FOOTING ELEVATION
3N	FOOTING 1		819.12
	PILE 1	816.63	
	PILE 2	816.64	
	PILE 3	816.63	
	PILE 4	816.60	
4N	FOOTING 1		829.01
	PILE 1	826.48	
	PILE 2	826.47	
	PILE 3	826.51	
	PILE 4	826.48	
5N	FOOTING 1		834.13
	PILE 1	831.48	
	PILE 2	831.50	
	PILE 3	831.51	
	PILE 4	831.46	
6N	BEAM 1		
	RT WINGWALL	858.49	

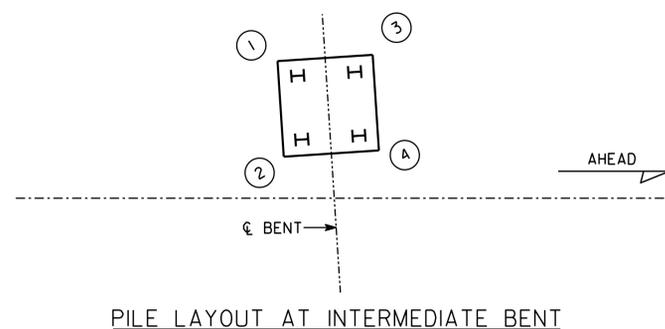

PILE LAYOUT AT INTERMEDIATE BENT

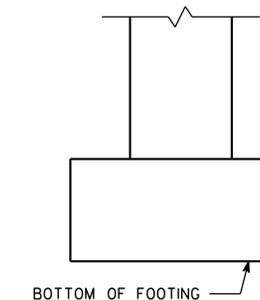

FOOTING ELEVATION AT INTERMEDIATE BENT

NOTE:  
THIS "AS-BUILT FOUNDATION INFORMATION" SHEET IS TO BE FILLED IN BY THE PROJECT ENGINEER AND THE ENTIRE SHEET FORWARDED TO THE OFFICE OF BRIDGE DESIGN UPON COMPLETION OF PILE DRIVING AND FOOTING CONSTRUCTION FOR POSTING TO THE PLANS AS A PERMANENT RECORD OF THE BRIDGE CONSTRUCTION.

PROJECT ENGINEER \_\_\_\_\_ DATE \_\_\_\_\_  
( )  
(AREA CODE) TELEPHONE NUMBER \_\_\_\_\_

<b>AS-BUILT</b> DRAWING NO. 35.1 - 18 BRIDGE SHEET 18 OF 20		REVISIONS DATE	BRIDGE NO. 1  GEORGIA <b>DEPARTMENT OF TRANSPORTATION</b> ENGINEERING DIVISION-OFFICE OF BRIDGES AND STRUCTURES		
			AS-BUILT FOUNDATION INFORMATION I-85 SOUTHBOUND TO SR 400 NORTHBOUND SR 400/I-85 CONNECTOR RAMPS OVER LENOX ROAD AND NORTH FORK PEACHTREE CREEK FULTON COUNTY NH000-0085-02(153)		
SCALE: NONE FEBRUARY 2012		DESIGNED: BKA CHECKED: GBL DRAWN: BRW DESIGN GROUP:			