


NOTES:

1. DECK DRAINS SHALL BE INSTALLED IN ACCORDANCE WITH GEORGIA DOT SPECIFICATIONS.
2. ALL MATERIALS AND WORK TO INSTALL DECK DRAIN SYSTEM TO BE INCLUDED IN PRICE BID FOR "DECK DRAIN SYSTEM".
3. CONTRACTOR SHALL FURNISH SHOP DRAWINGS OF COMPLETE DECK DRAIN SYSTEM FOR APPROVAL BY THE ENGINEER.
4. ALL DECK DRAIN PIPES SHALL BE PVC SCH. 80.
5. CUT OR SLIGHTLY ADJUST TYPICAL BARS ONLY AS NECESSARY TO PLACE DRAIN.
6. VACUUM HOSE SHALL BE HEAVY DUTY RUBBER HOSE AS MANUFACTURED BY CAPITAL RUBBER CORPORATION OR APPROVED EQUAL. DIAMETER SHALL BE SIZED TO HANDLE SCUPPER DRAIN SPOUT.
7. VACUUM HOSES SHALL BE CLAMPED WITH 3/4" WIDE STAINLESS STEEL BANDS.
8. ALL DECK DRAIN COMPONENTS SHALL BE GALVANIZED.

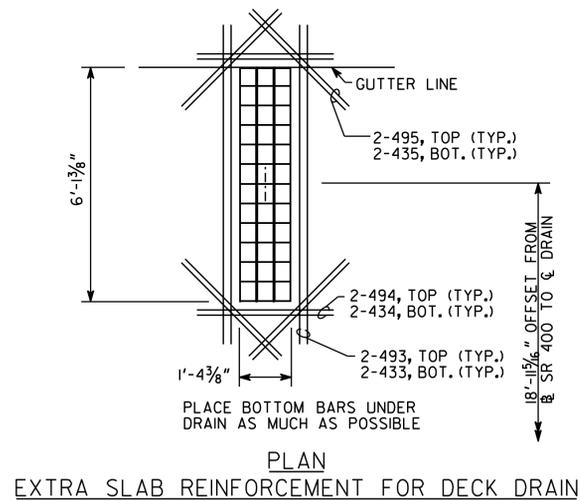

* NEENAH R-3945 BRIDGE DRAIN OR EQUAL.

AS-BUILT

DRAWING NO.
35.4 - 18
BRIDGE SHEET
18 OF 50

DATE	REVISIONS	BY

BRIDGE NO. 4

GEORGIA
DEPARTMENT OF TRANSPORTATION
ENGINEERING DIVISION-OFFICE OF BRIDGES AND STRUCTURES

DRAINAGE DETAILS
SR 400 SOUTHBOUND TO I-85 NORTHBOUND FLYOVER
SR 400/I-85 CONNECTOR RAMPS
FULTON COUNTY NH000-0085-02(153)

NO SCALE MARCH 2012

DESIGNED	BCB/GBL	CHECKED	MS/KAK	REVIEWED	
DRAWN	DB/BCB	DESIGN GROUP		APPROVED	