
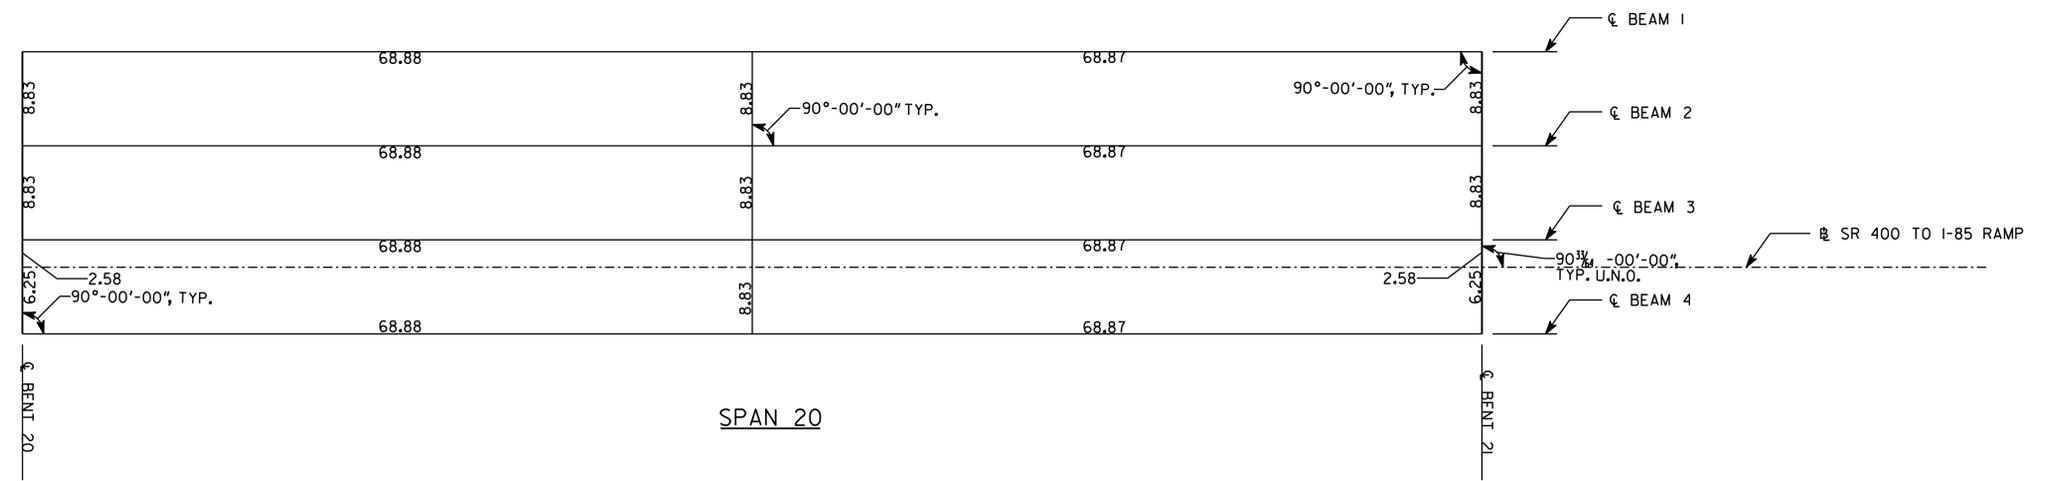


STATE	PROJECT NUMBER	SHEET NO.	TOTAL SHEETS
GA.	NH000-0085-02(153)	257	480

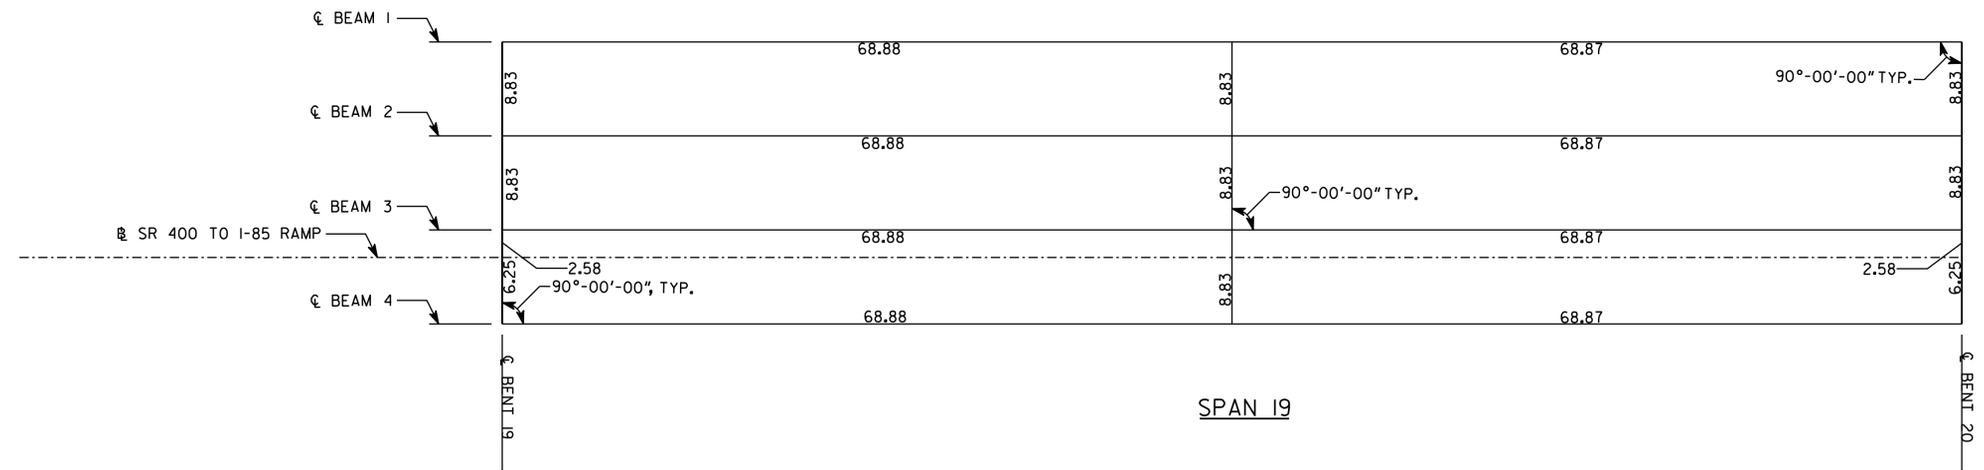

- NOTES:
1. ALL DIMENSIONS ARE SHOWN IN FEET.
 2. ALL BEAMS IN EACH SPAN ARE PARALLEL.
 3. ALL DIMENSIONS ALONG BEAMS ARE FROM B.F.P.R. TO ϕ DIAPHRAGM OR ϕ BENT TO ϕ DIAPHRAGM.
 4. ALL DIMENSIONS ALONG B.F.P.R., ϕ BENT AND ϕ DIAPHRAGMS ARE FROM ϕ BEAM TO ϕ BEAM.
 5. ALL DIAPHRAGMS ARE PERPENDICULAR TO BEAMS.

AS-BUILT

DRAWING NO.
35.4 - 26
BRIDGE SHEET
26 OF 50

DATE	REVISIONS	BY

BRIDGE NO. 4

GEORGIA
DEPARTMENT OF TRANSPORTATION
ENGINEERING DIVISION-OFFICE OF BRIDGES AND STRUCTURES

FRAMING PLAN SPANS 19-20
SR 400 SOUTHBOUND TO I-85 NORTHBOUND
FLYOVER
SR 400/I-85 CONNECTOR RAMPS
FULTON COUNTY NH000-0085-02(153)

SCALE: 1/8" = 1'-0" MARCH 2012

DESIGNED	BCB/GBL	CHECKED	MS/KAK	REVIEWED	
DRAWN	DB/BCB	DESIGN GROUP		APPROVED	