


STATE	PROJECT NUMBER	SHEET NO.	TOTAL SHEETS
GA.			

ALTERNATE 1

AS BUILT FOUNDATION INFORMATION				
BENT	FOOTING/PILE LOCATION	PILE TIP ELEVATION	BOTTOM OF FOOTING ELEVATION	BOTTOM OF SEAL ELEVATION
1	BEAM 1		X	X
	BEAM 2			
	BEAM 3			
	BEAM 4			
	BEAM 5			
	BEAM 6			
	BEAM 7			
2	COLUMN 1		X	X
	COLUMN 2			
3	COLUMN 1		X	X
	COLUMN 2			
4	BEAM 1		X	X
	BEAM 2			
	BEAM 3			
	BEAM 4			
	BEAM 5			
	BEAM 6			
	BEAM 7			

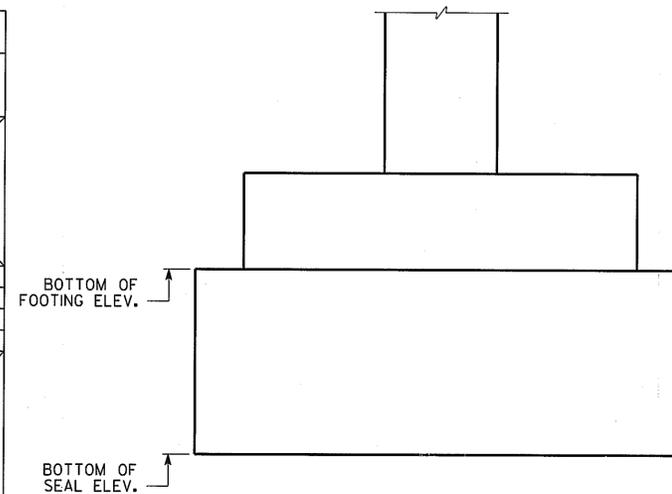


TYPICAL FOOTING ELEVATION

NOTE: THIS "AS BUILT FOUNDATION INFORMATION" SHEET SHALL BE FILLED IN BY THE PROJECT ENGINEER AND FORWARDED TO THE BRIDGE OFFICE AFTER INSTALLATION OF ALL PILES AND FOOTINGS FOR POSTING TO THE PLANS AS A PERMANENT RECORD OF THE BRIDGE CONSTRUCTION.

PROJECT ENGINEER _____ DATE _____
 (AREA CODE) TELEPHONE NUMBER _____

ALTERNATE 2

AS BUILT FOUNDATION INFORMATION				
BENT	FOOTING/PILE LOCATION	PILE TIP ELEVATION	TOP OF DRILLED CAISSON ELEVATION	BOTTOM OF DRILLED CAISSON ELEVATION
1	BEAM 1	948.43	X	X
	BEAM 2	950.03		
	BEAM 3	948.97		
	BEAM 4	949.36		
	BEAM 5	952.32		
	BEAM 6	947.38		
	BEAM 7	946.10		
2	COLUMN 1		969.22	947.26
	COLUMN 2		968.74	945.58
3	COLUMN 1		971.57	949.52
	COLUMN 2		970.85	949.66
4	BEAM 1	958.96	X	X
	BEAM 2	959.89		
	BEAM 3	958.42		
	BEAM 4	959.64		
	BEAM 5	957.51		
	BEAM 6	959.36		
	BEAM 7	959.38		

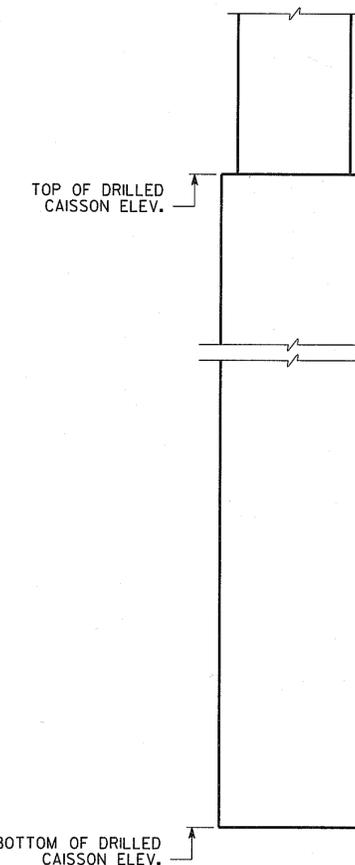

TYPICAL DRILLED CAISSON ELEVATION

NOTE: THIS "AS BUILT FOUNDATION INFORMATION" SHEET SHALL BE FILLED IN BY THE PROJECT ENGINEER AND FORWARDED TO THE BRIDGE OFFICE AFTER INSTALLATION OF ALL PILES AND DRILLED CAISSON FOR POSTING TO THE PLANS AS A PERMANENT RECORD OF THE BRIDGE CONSTRUCTION.

MOHAMMAD A. JAVANMARD 06-03-11
 PROJECT ENGINEER DATE
 (404) 326-5227
 (AREA CODE) TELEPHONE NUMBER

BRIDGE NO. 1 - ALTERNATE 1 OR 2

GEORGIA
 DEPARTMENT OF TRANSPORTATION
 PRECONSTRUCTION DIVISION-OFFICE OF BRIDGE DESIGN

AS BUILT FOUNDATION SHEET
 CR 85 (KIMBALL BRIDGE ROAD)
 OVER BIG CREEK
 FULTON COUNTY BRZLB-0121-00(017)

NO SCALE FEBRUARY 2008

BRIDGE SHEET 19 OF 21	BY DLC	DESIGNED LEL	CHECKED DLC	DESIGN GROUP SWW	REVIEWED WMD	APPROVED PVL
--------------------------	-----------	-----------------	----------------	---------------------	-----------------	-----------------