

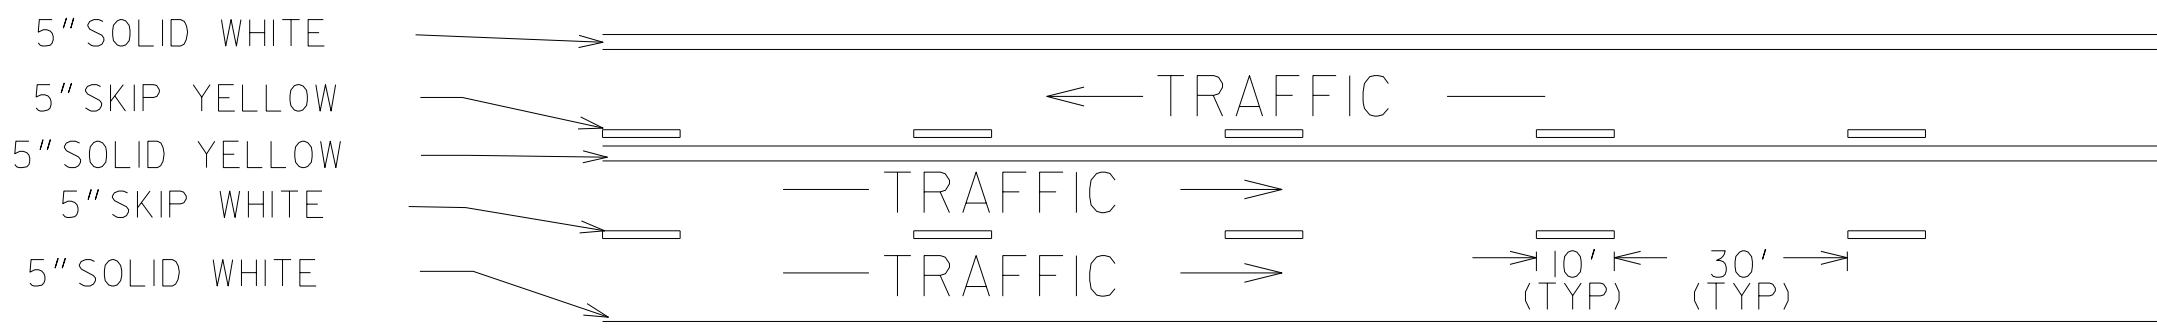



STATE	PROJECT NUMBER	SHEET NO.	TOTAL SHEETS
GA.	0011682		

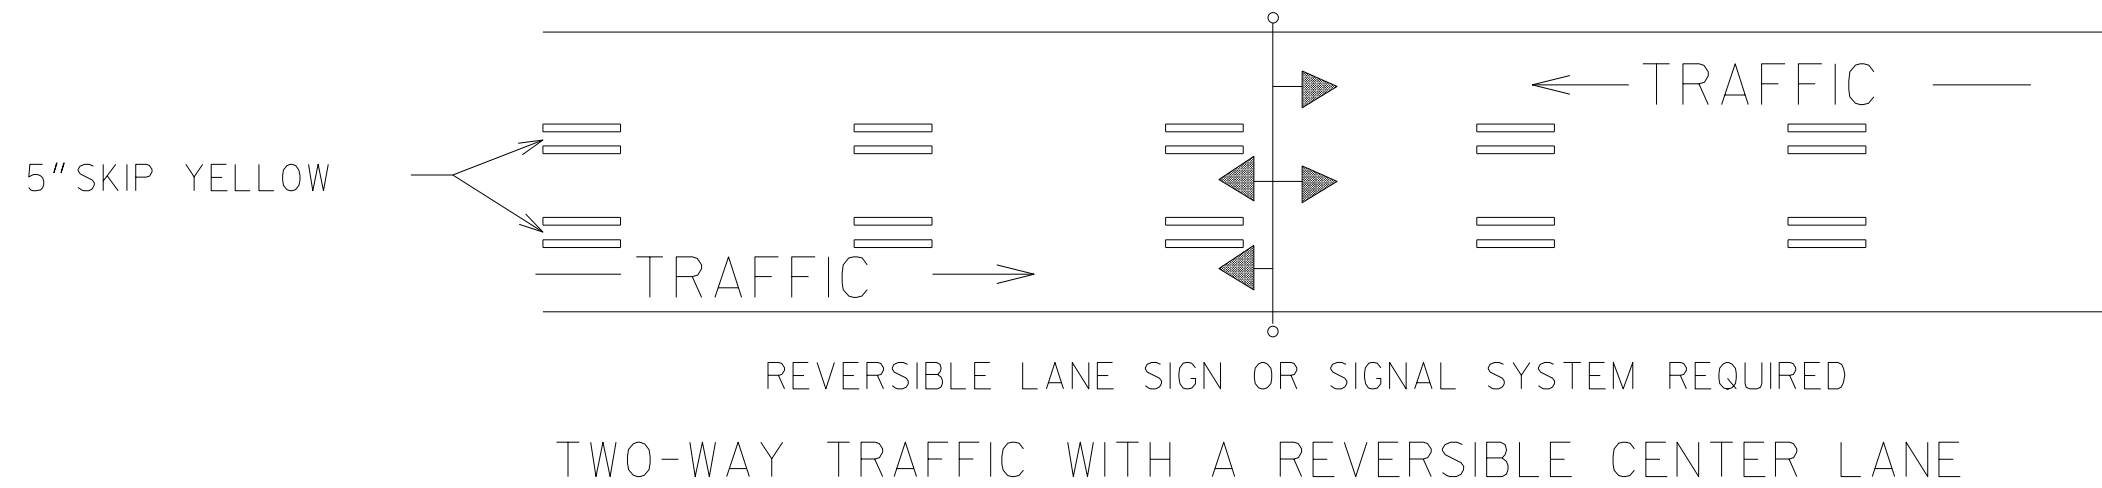


TWO-WAY TRAFFIC WHERE MOTORISTS IN A SINGLE LANE ARE PERMITTED TO PASS

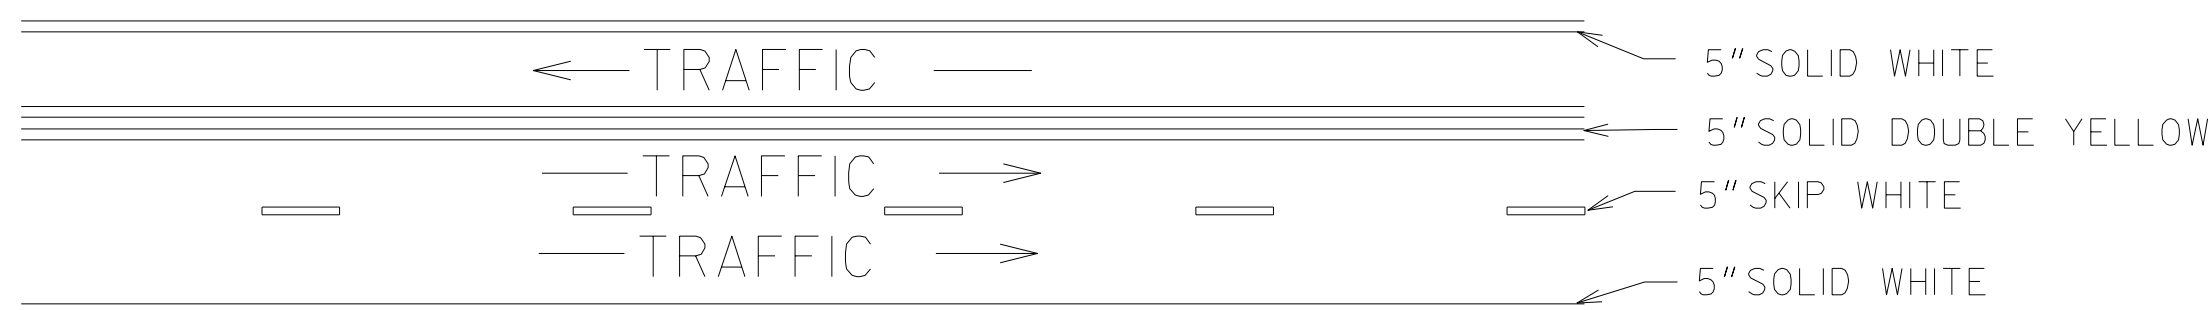


TWO-WAY TRAFFIC WHERE MOTORISTS IN A SINGLE LANE ARE NOT PERMITTED TO PASS

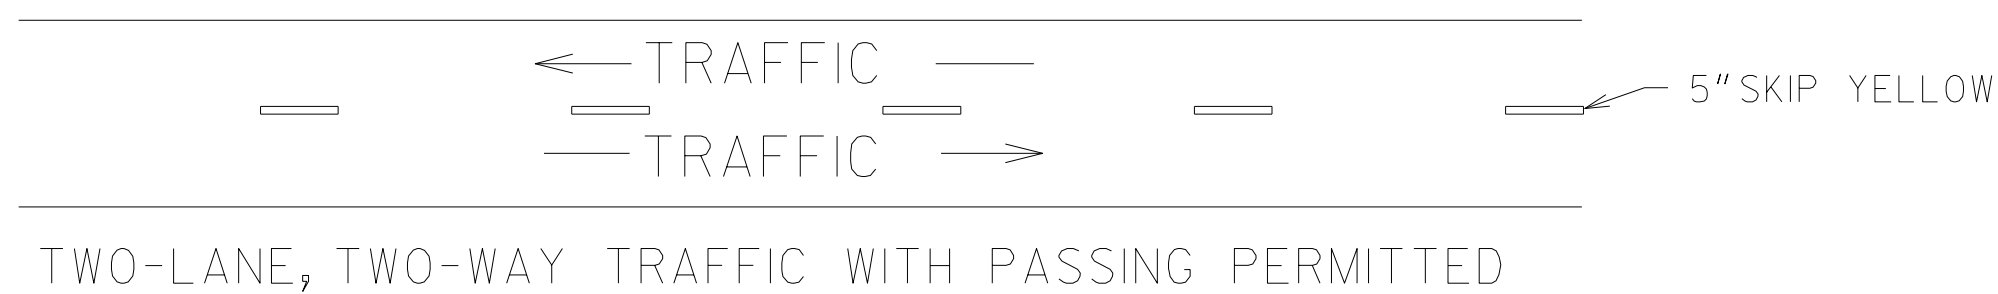


TWO-LANE, TWO-WAY TRAFFIC WITH PASSING PERMITTED

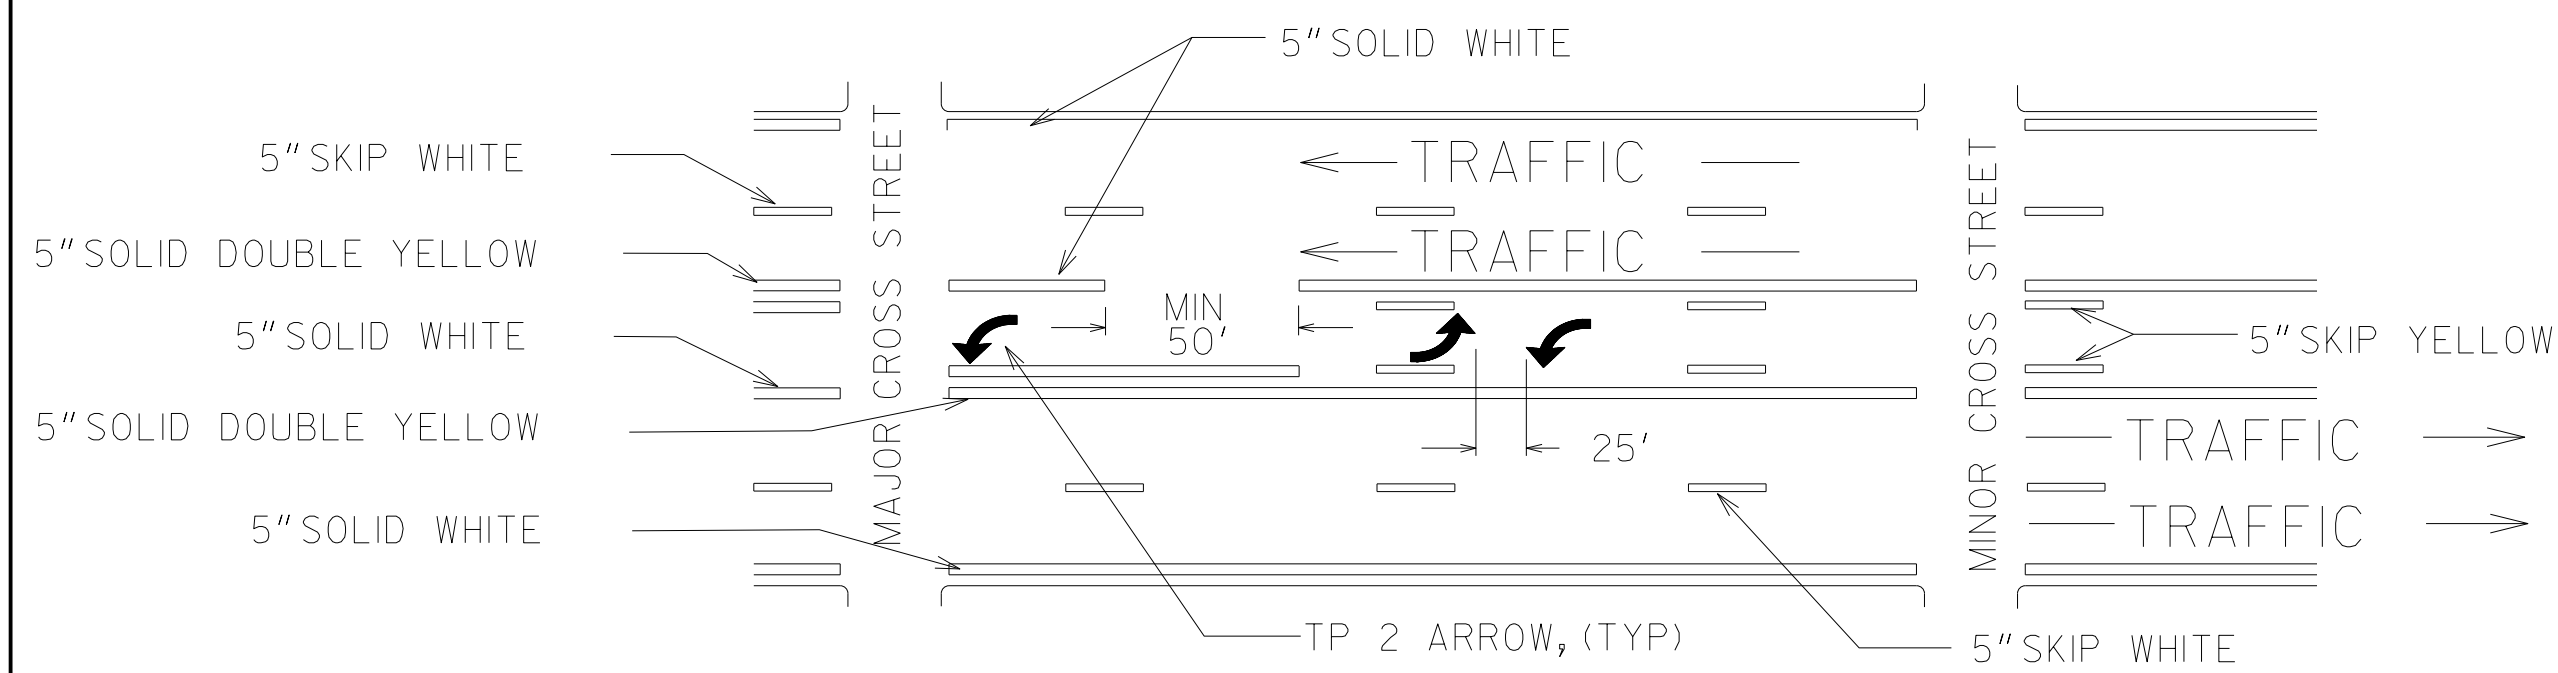


MULTI-LANE, TWO-WAY TRAFFIC WITH SINGLE LANE, TWO-WAY LEFT TURN CHANNELIZATION

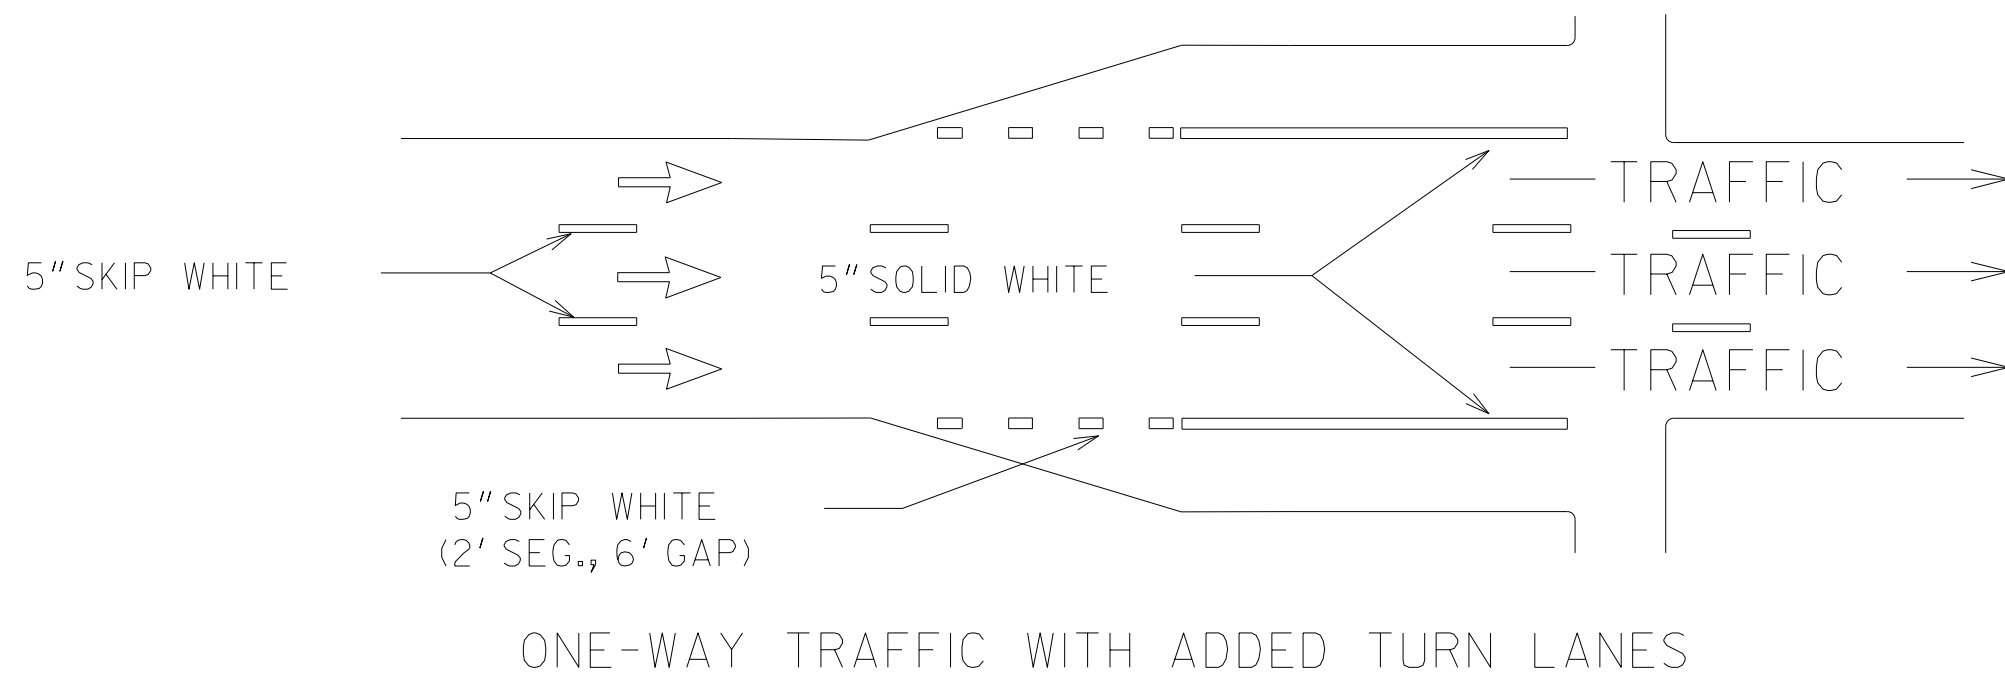


ONE-WAY TRAFFIC WITH ADDED TURN LANES

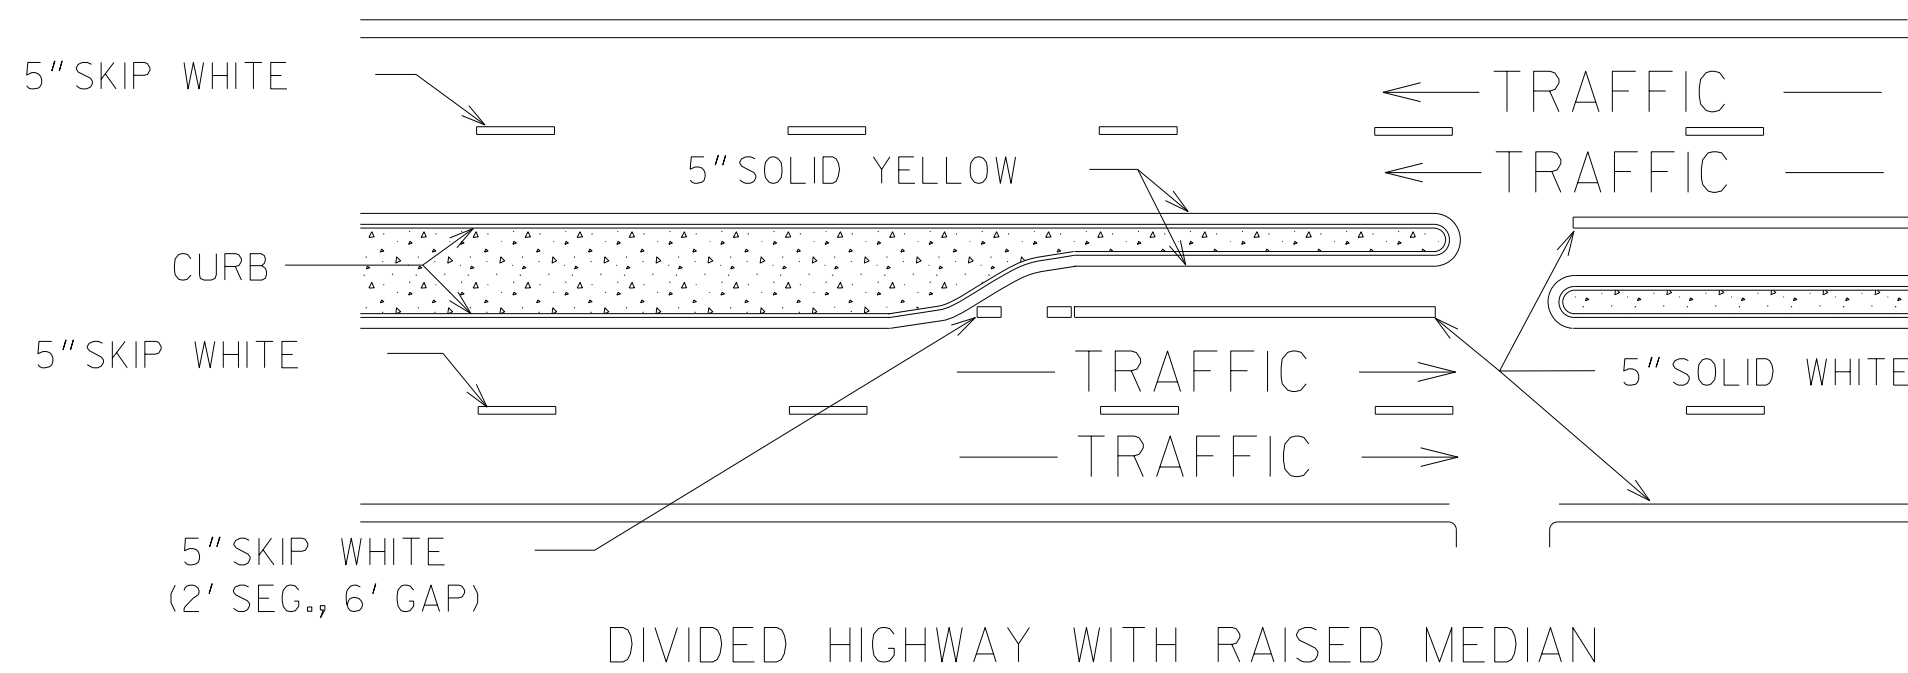

DIVIDED HIGHWAY WITH RAISED MEDIAN

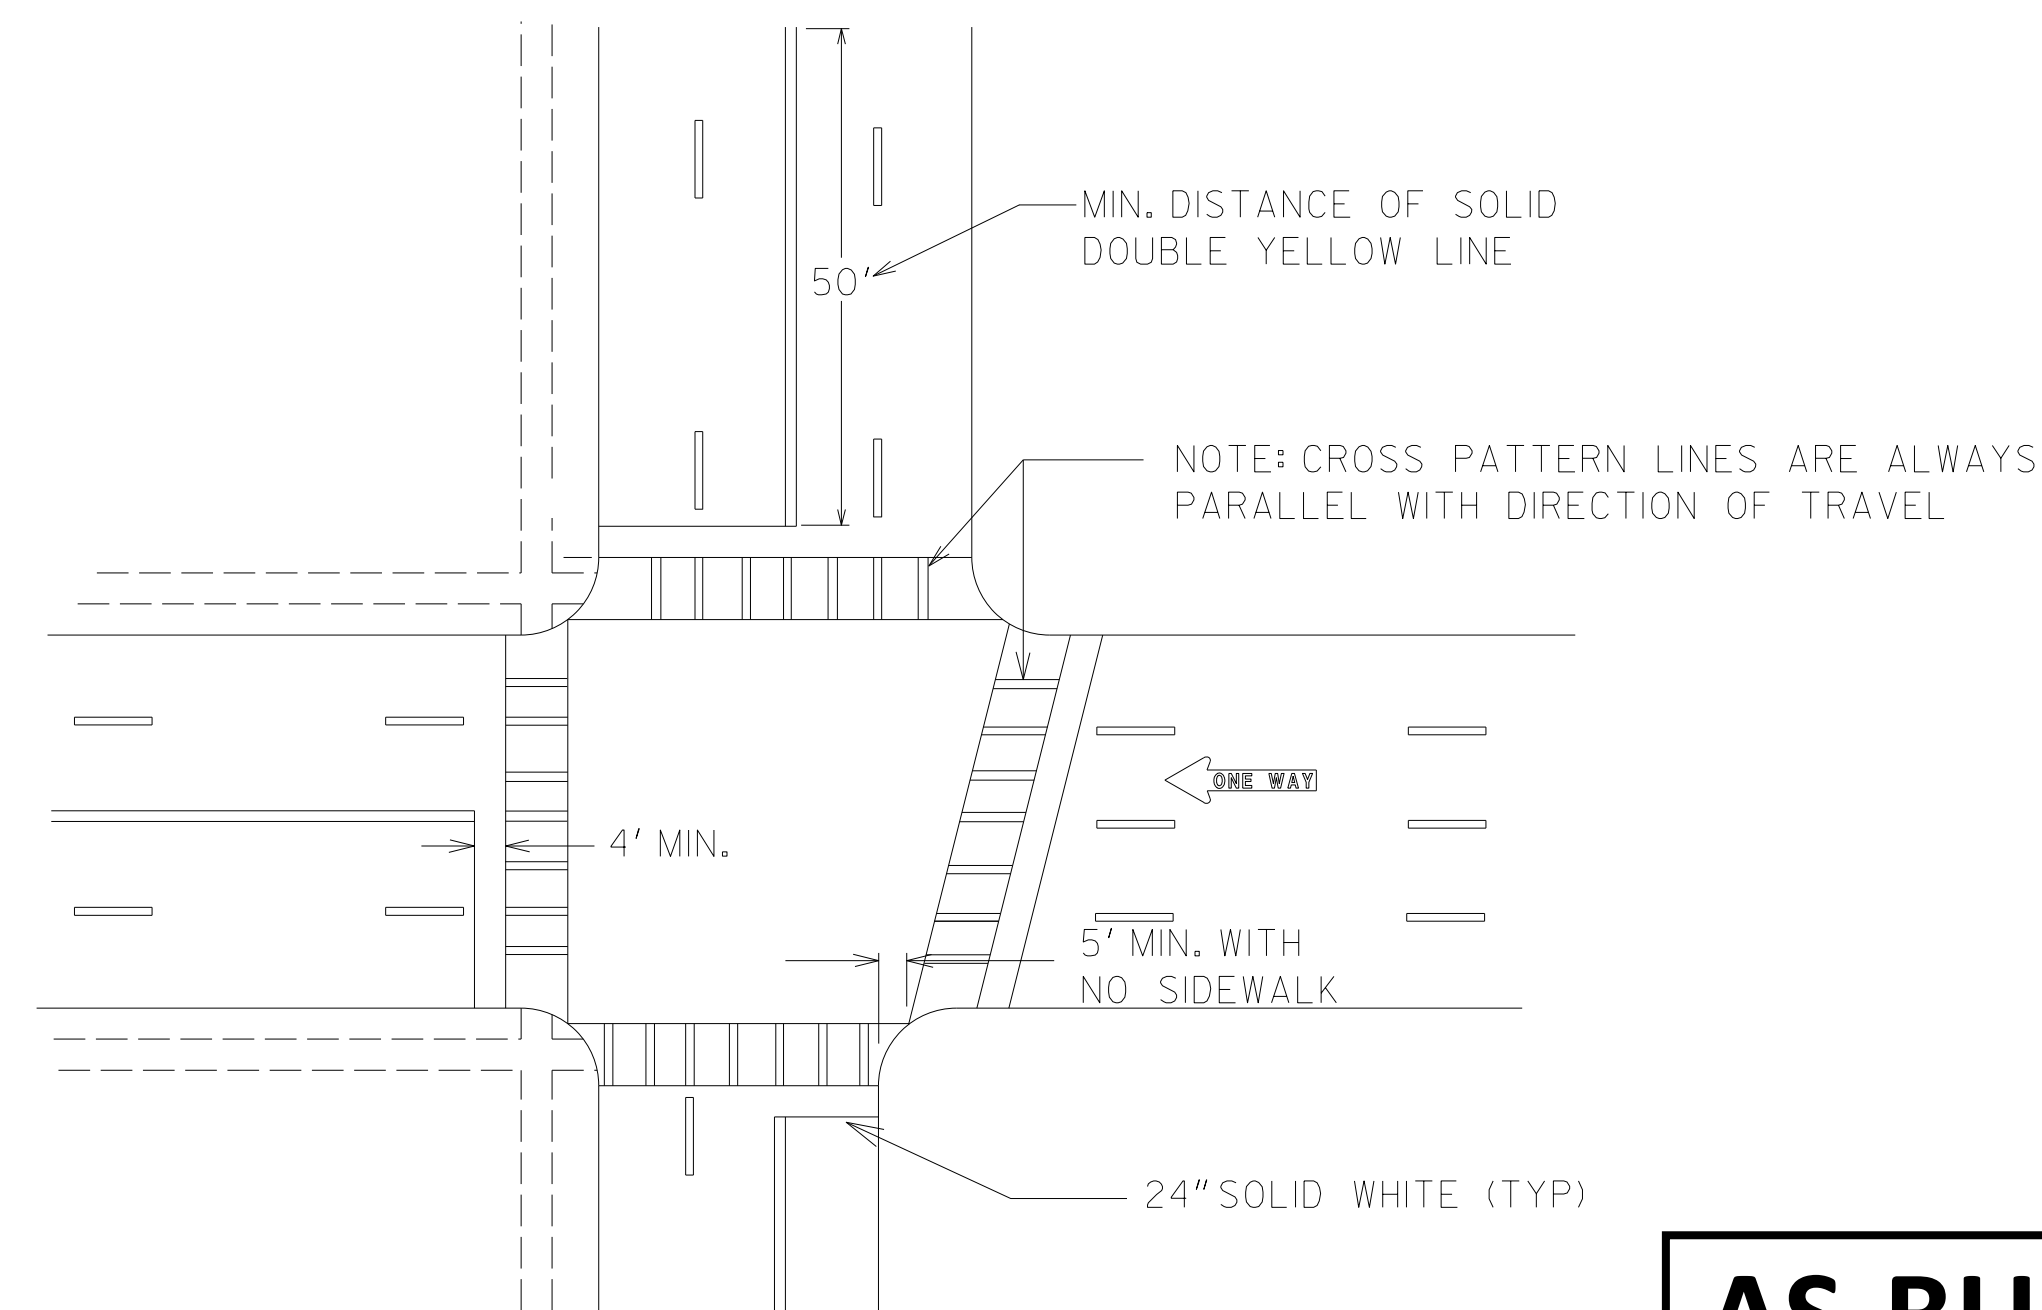

TYPICAL LOCATION OF CROSSWALKS AND STOP BARS

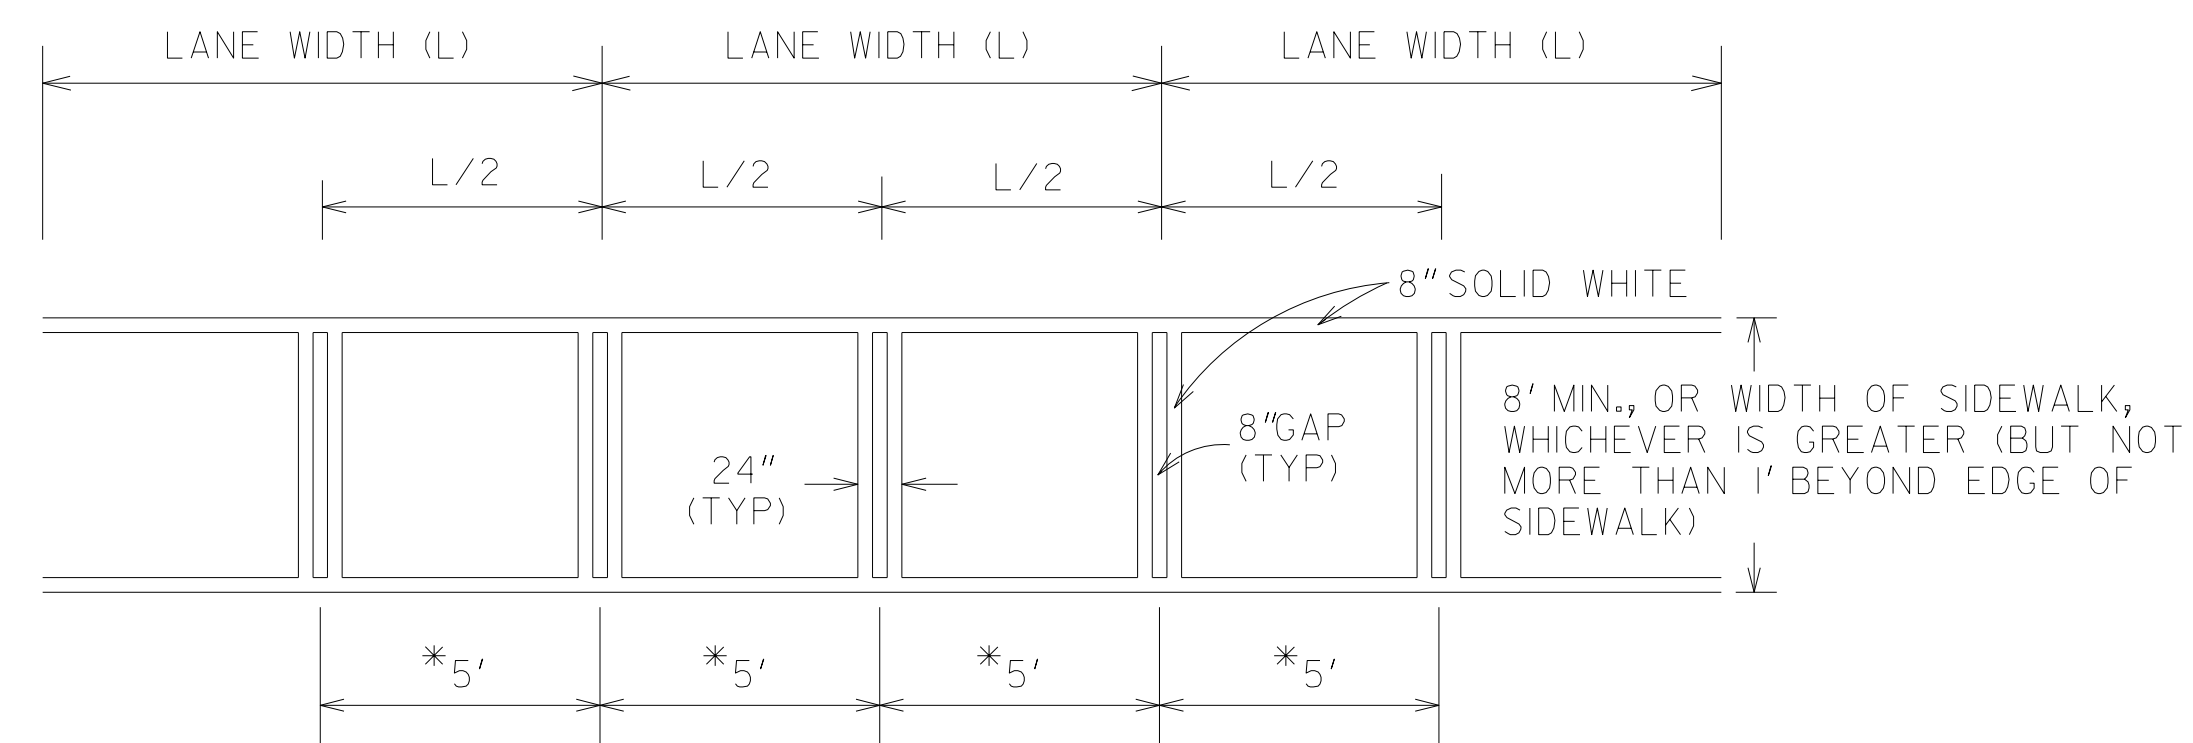

*USE WHERE THE LANE WIDTH EXCEEDS 12'
OR WHERE LANE LINES HAVE BEEN OMITTED

CROSSWALK DETAIL

GENERAL NOTES:

1. SPACING BETWEEN DOUBLE LINES SHALL BE EQUAL TO THE LINE WIDTH.
2. EDGE LINES SHALL BE PLACED A MINIMUM OF 4 INCHES FROM THE NORMAL EDGE OF PAVEMENT.
3. CONTRAST MARKINGS FOR SKIP STRIPING SHALL BE AS SHOWN IN DETAIL T-IIB.

AS-BUILT DRAWINGS

		9-15-16	DATE	DEPARTMENT OF TRANSPORTATION STATE OF GEORGIA	
		ADDED GENERAL NOTE 3	REVISION	CONSTRUCTION DETAILS PAVEMENT MARKING PLACEMENT NON-LIMITED ACCESS ROADWAY	
				NO SCALE	JANUARY 2000
		CDR	BY	DESIGNED _____ DRAWN _____ TRACED _____ CHECKED _____	NUMBER T-IIA