Tue Mar 05 16:06:50 2013	Tue Mar 05 16:06:50 2013	C:\0002_Active Projects\0000759\Dgn\0000759ER14.dgn	COUNTY	PROJECT NUMBER	SHEET NO.	TOTAL SHEETS
mjordan	\\gdot-dsn1\gocfg\resources\Gdot2007_Klp.tbl		LINCOLN	STP00-0000-00(759)	197	123

VOID

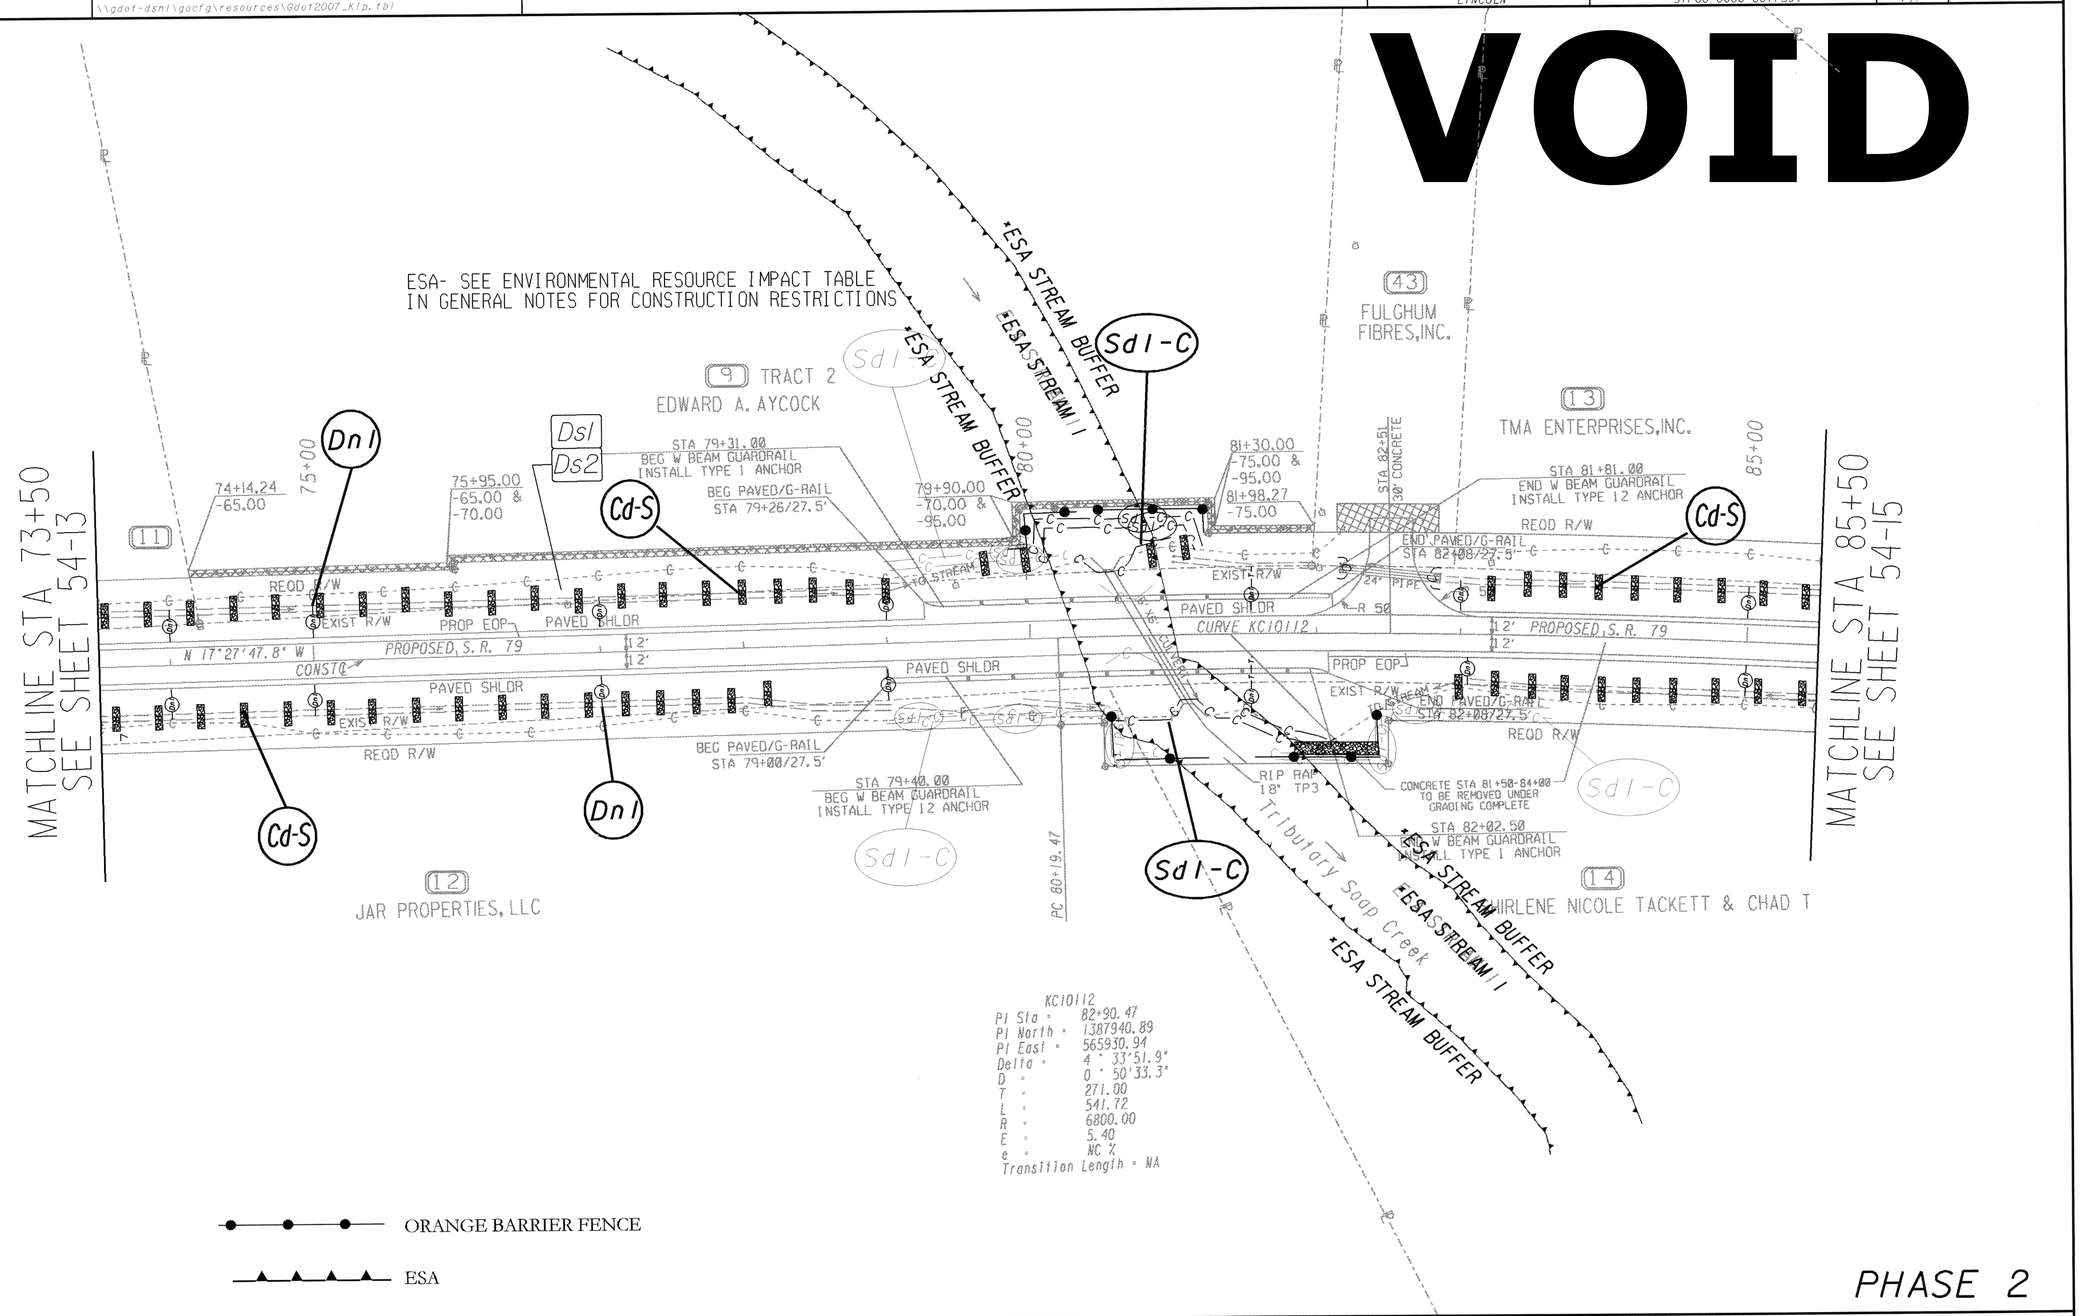

PHASE 2

PROPERTY AND EXISTING R/W LINE	BEGIN LIMIT OF ACCESS ..... BLA
REQUIRED R/W LINE	END LIMIT OF ACCESS ..... ELA
CONSTRUCTION LIMITS	LIMIT OF ACCESS
EASEMENT FOR CONSTR & MAINTENANCE OF SLOPES	REQUIRED R/W AND LIMIT OF ACCESS
EASEMENT FOR CONSTR OF SLOPES	
EASEMENT FOR CONSTR OF DRIVES	

GEORGIA
DEPARTMENT OF TRANSPORTATION

SCALE IN FEET
0 50 100 200

REVISION DATES

STATE OF GEORGIA
DEPARTMENT OF TRANSPORTATION
OFFICE: DISTRICT 2 - TENNILLE

BMP LOCATION DETAILS

STP00-0000-00(759)
PI NO: 0000759

DRAWING No. 54-014