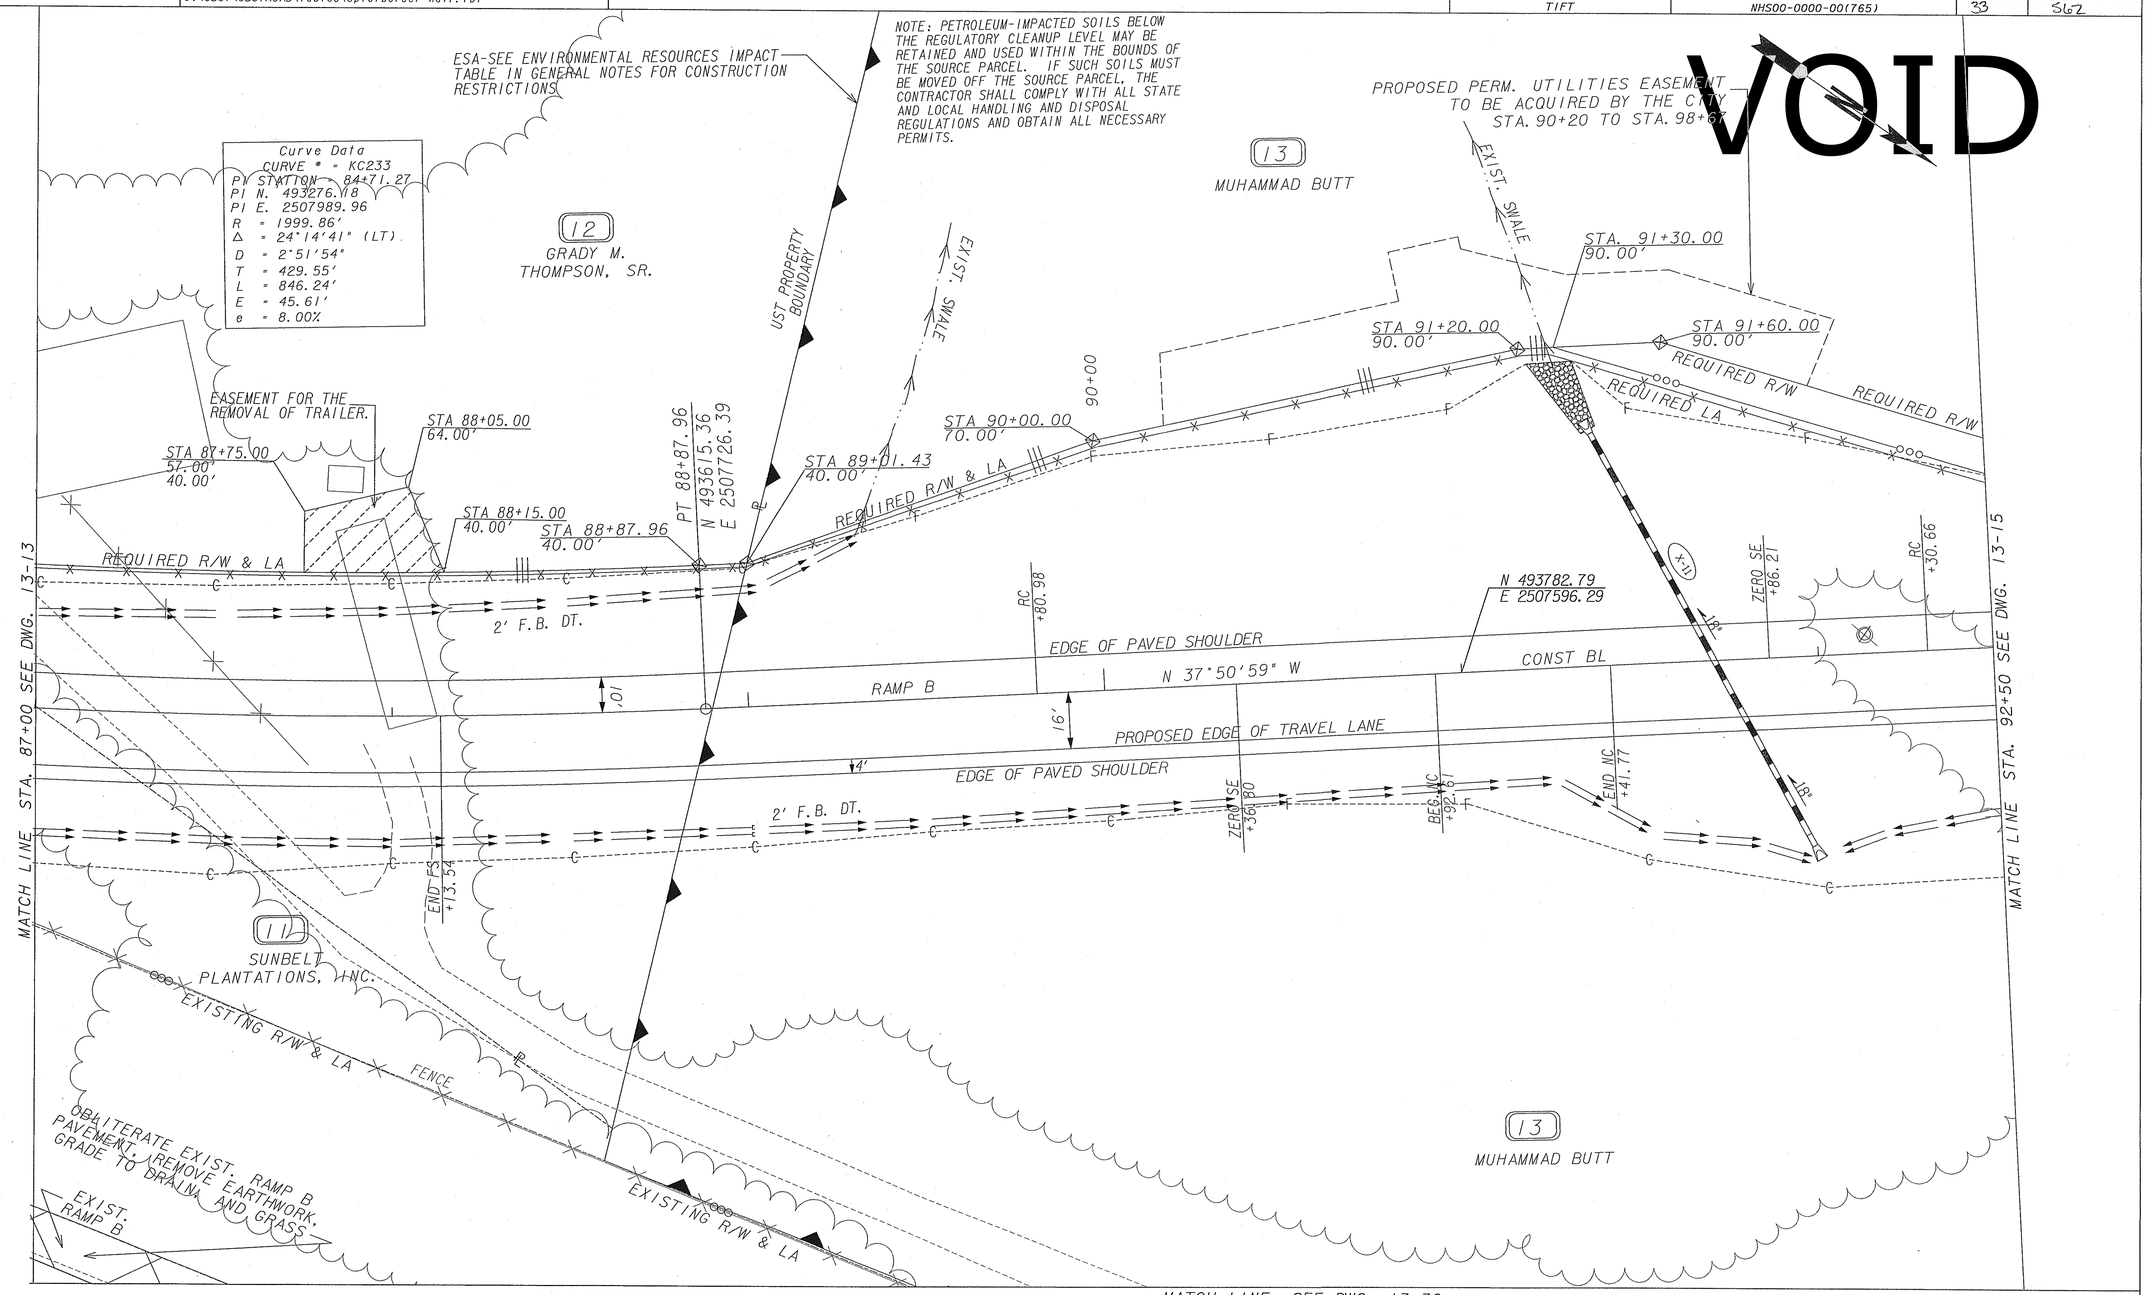

PROPERTY AND EXISTING R/W LINE
REQUIRED R/W LINE
CONSTRUCTION LIMITS
EASEMENT FOR CONSTRUCTION & MAINTENANCE OF SLOPES
EASEMENT FOR CONSTR OF SLOPES
EASEMENT FOR CONSTR OF DRIVES

BEGIN LIMIT OF ACCESS.....BLA
END LIMIT OF ACCESS.....ELA
LIMIT OF ACCESS
R/W AND LIMIT OF ACCESS
EXISTING R/W LINE

PLANS PREPARED AND SUBMITTED BY:
AEI
Branch Offices
65 Aberdeen Drive, Glasgow, KY 42141, (270) 651-7220
1834 White Circle, Suite 101, Marietta, GA 30066, (770) 421-8422
2500 Nelson Miller Parkway, Louisville, KY 40223, (502) 245-3813
AMERICAN ENGINEERS, INC.
www.aei.co
PROFESSIONAL ENGINEERING
DESIGN CONSULTANT

SCALE IN FEET
0 20 40 80

REVISION DATES

STATE OF GEORGIA
DEPARTMENT OF TRANSPORTATION
OFFICE: PROGRAM DELIVERY

MAINLINE PLAN RAMP B

NHS00-0000-00(765)
P. I. 0000765

DRAWING No. 13-14