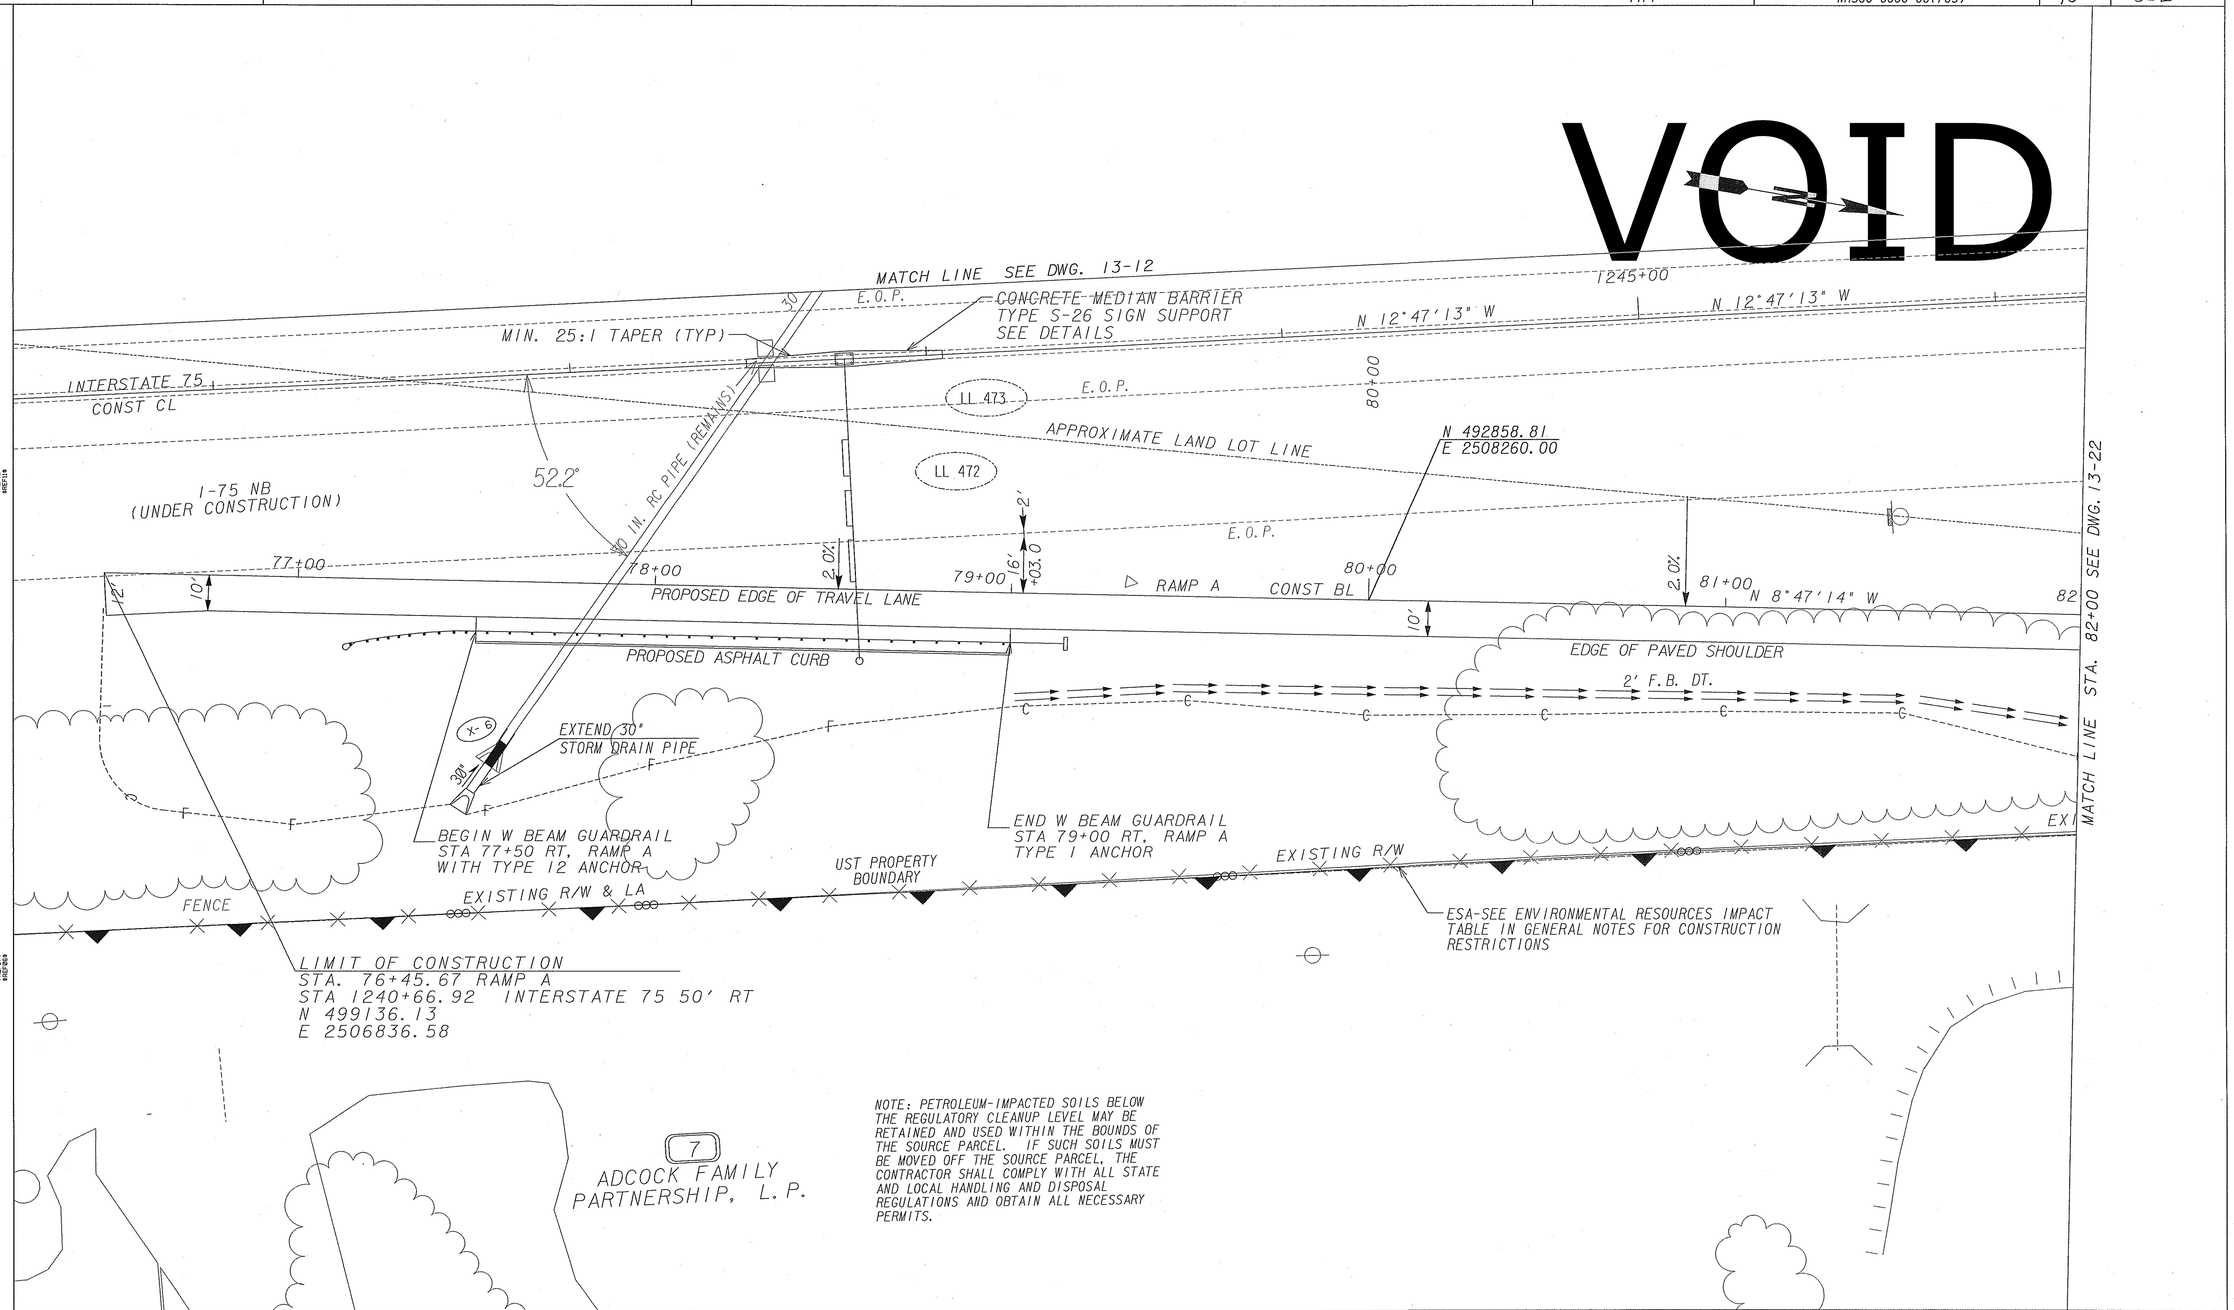

NOTE: PETROLEUM-IMPACTED SOILS BELOW THE REGULATORY CLEANUP LEVEL MAY BE RETAINED AND USED WITHIN THE BOUNDS OF THE SOURCE PARCEL. IF SUCH SOILS MUST BE MOVED OFF THE SOURCE PARCEL, THE CONTRACTOR SHALL COMPLY WITH ALL STATE AND LOCAL HANDLING AND DISPOSAL REGULATIONS AND OBTAIN ALL NECESSARY PERMITS.

PROPERTY AND EXISTING R/W LINE
REQUIRED R/W LINE
CONSTRUCTION LIMITS
EASEMENT FOR CONSTRUCTION & MAINTENANCE OF SLOPES
EASEMENT FOR CONSTR OF SLOPES
EASEMENT FOR CONSTR OF DRIVES

BEGIN LIMIT OF ACCESS.....BLA
END LIMIT OF ACCESS.....ELA
LIMIT OF ACCESS
R/W AND LIMIT OF ACCESS
EXISTING R/W LINE

PLANS PREPARED AND SUBMITTED BY:
AEI
Branch Offices
65 Aberdeen Drive, Glasgow, KY 42141, (270) 651-7220
1834 White Circle, Suite 101, Marietta, GA 30066, (770) 421-8422
2500 Nelson Miller Parkway, Louisville, KY 40223, (502) 245-3813
AMERICAN ENGINEERS, INC.
www.aei.co
PROFESSIONAL ENGINEERING
DESIGN CONSULTANT

SCALE IN FEET
0 20 40 80

REVISION DATES

STATE OF GEORGIA
DEPARTMENT OF TRANSPORTATION
OFFICE: PROGRAM DELIVERY

MAINLINE PLAN
RAMP A

NHS00-0000-00(765)
P.I. 0000765

DRAWING No.
13-21

GPLN