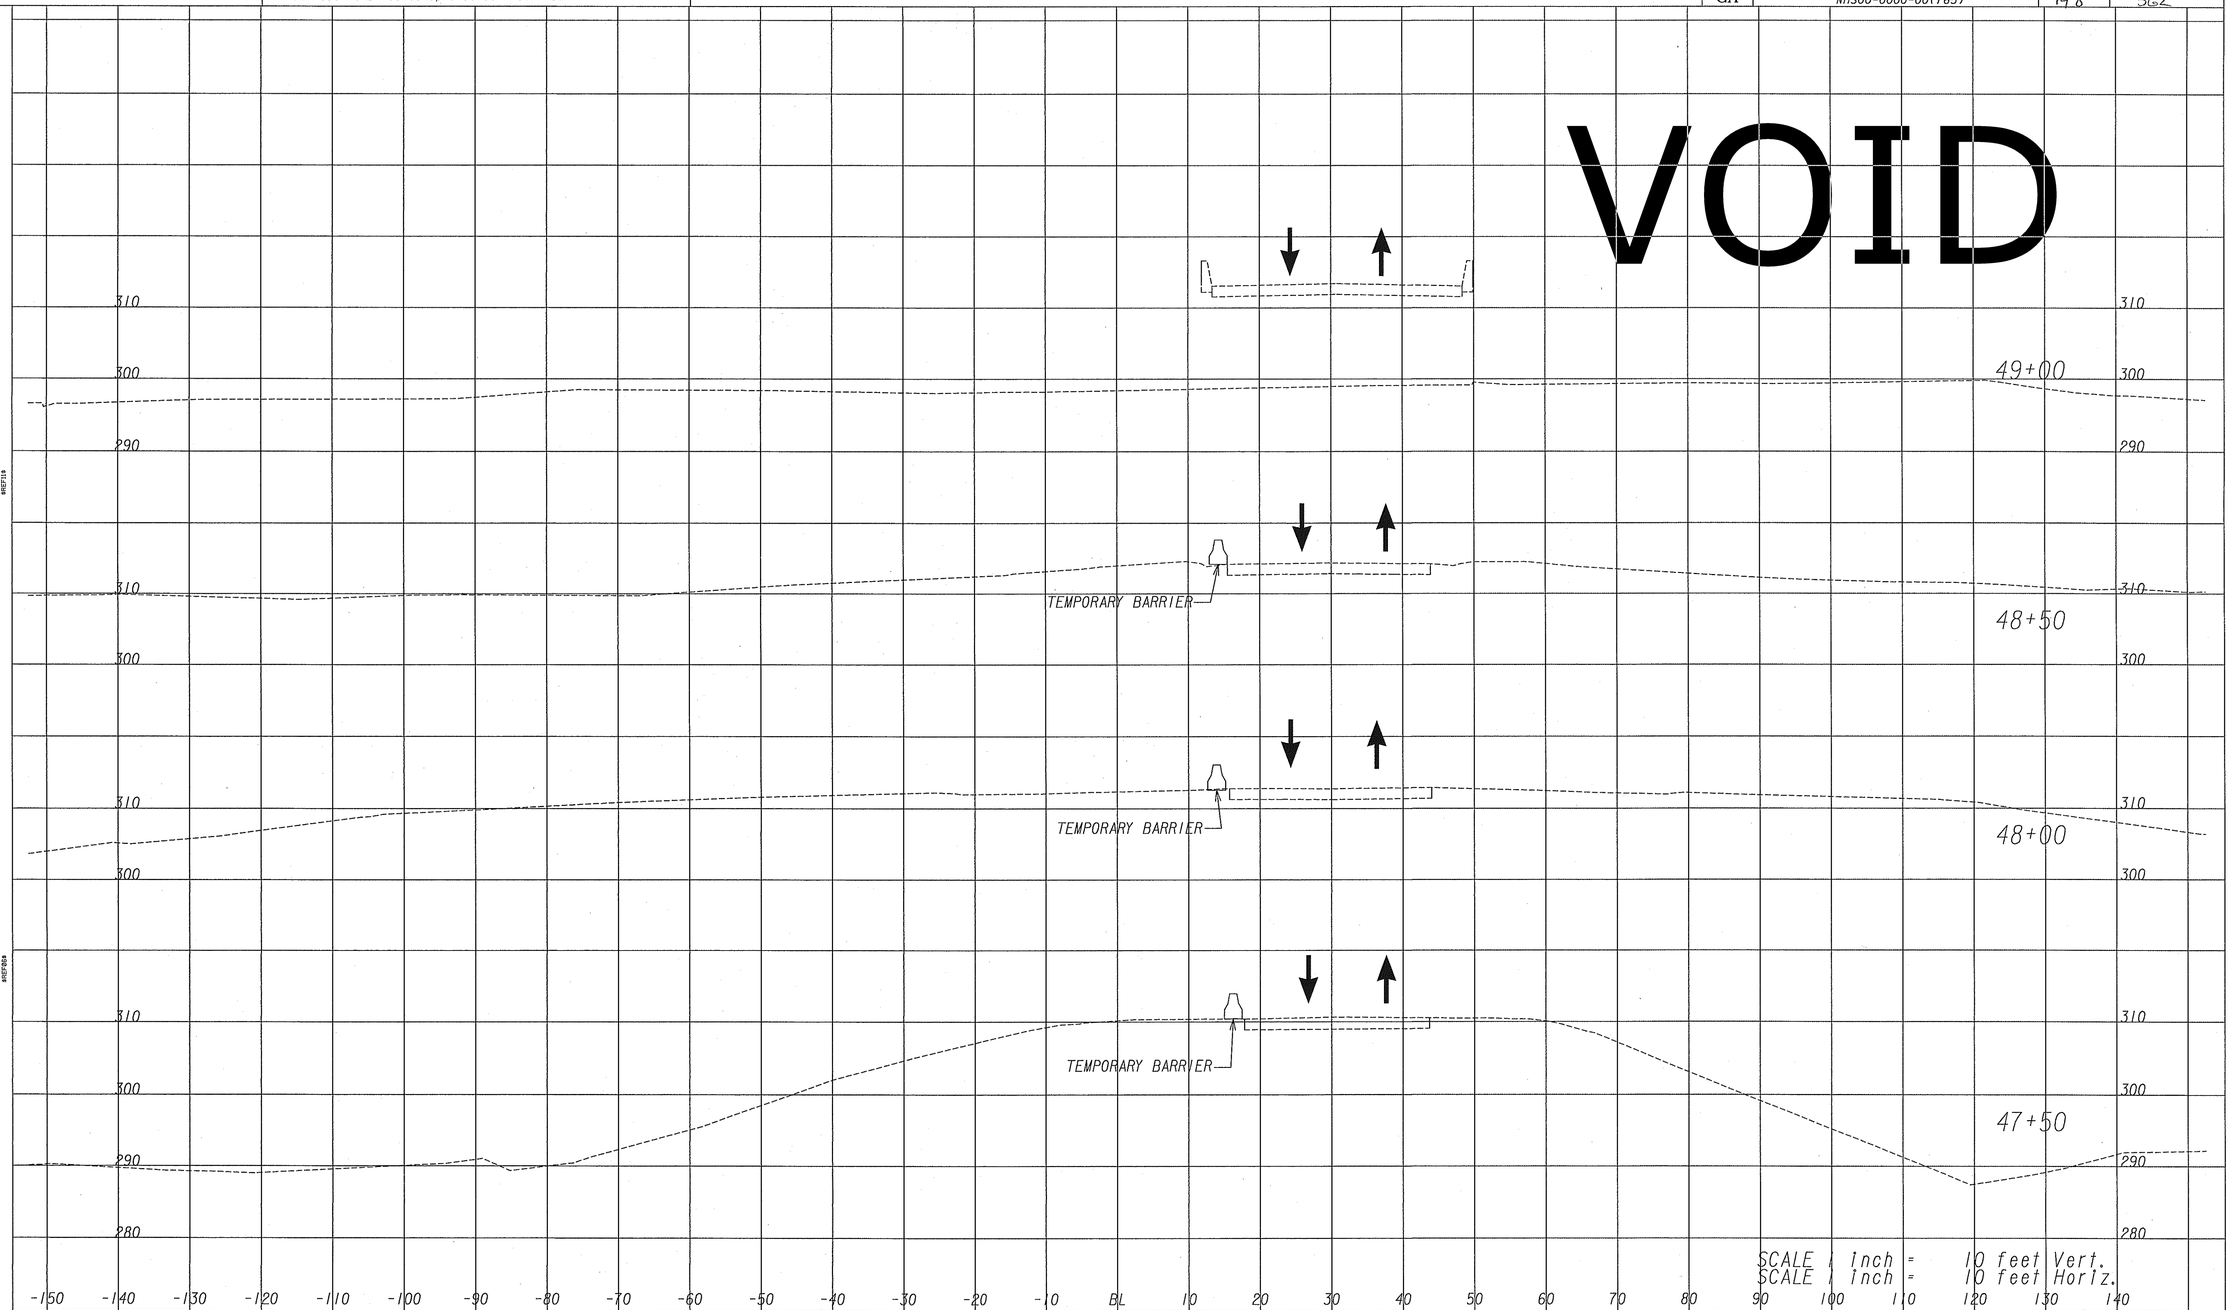

STAGE 1A

PLANS PREPARED AND SUBMITTED BY:

AEI

1634 White Circle, Suite 101
Marietta, GA 30066
(770) 421-8422

AMERICAN ENGINEERS, INC.
www.aei.cc
PROFESSIONAL ENGINEERING

REVISION DATES

STATE OF GEORGIA
DEPARTMENT OF TRANSPORTATION
OFFICE: PROGRAM DELIVERY

CROSS SECTIONS
CONSTRUCTION STAGING
CR 418/OMEGA-ELDORADO ROAD

DRAWING No. 19-70

3/1/2007 SUXSEW