DATE$$$	TIME$$$	PRF	DGN	STATE	PROJECT NUMBER	SHEET NO.	TOTAL SHEETS
$USER$		$$PENTABLE$$		GA	NHS00-0000-00(931)	778	831

VOID

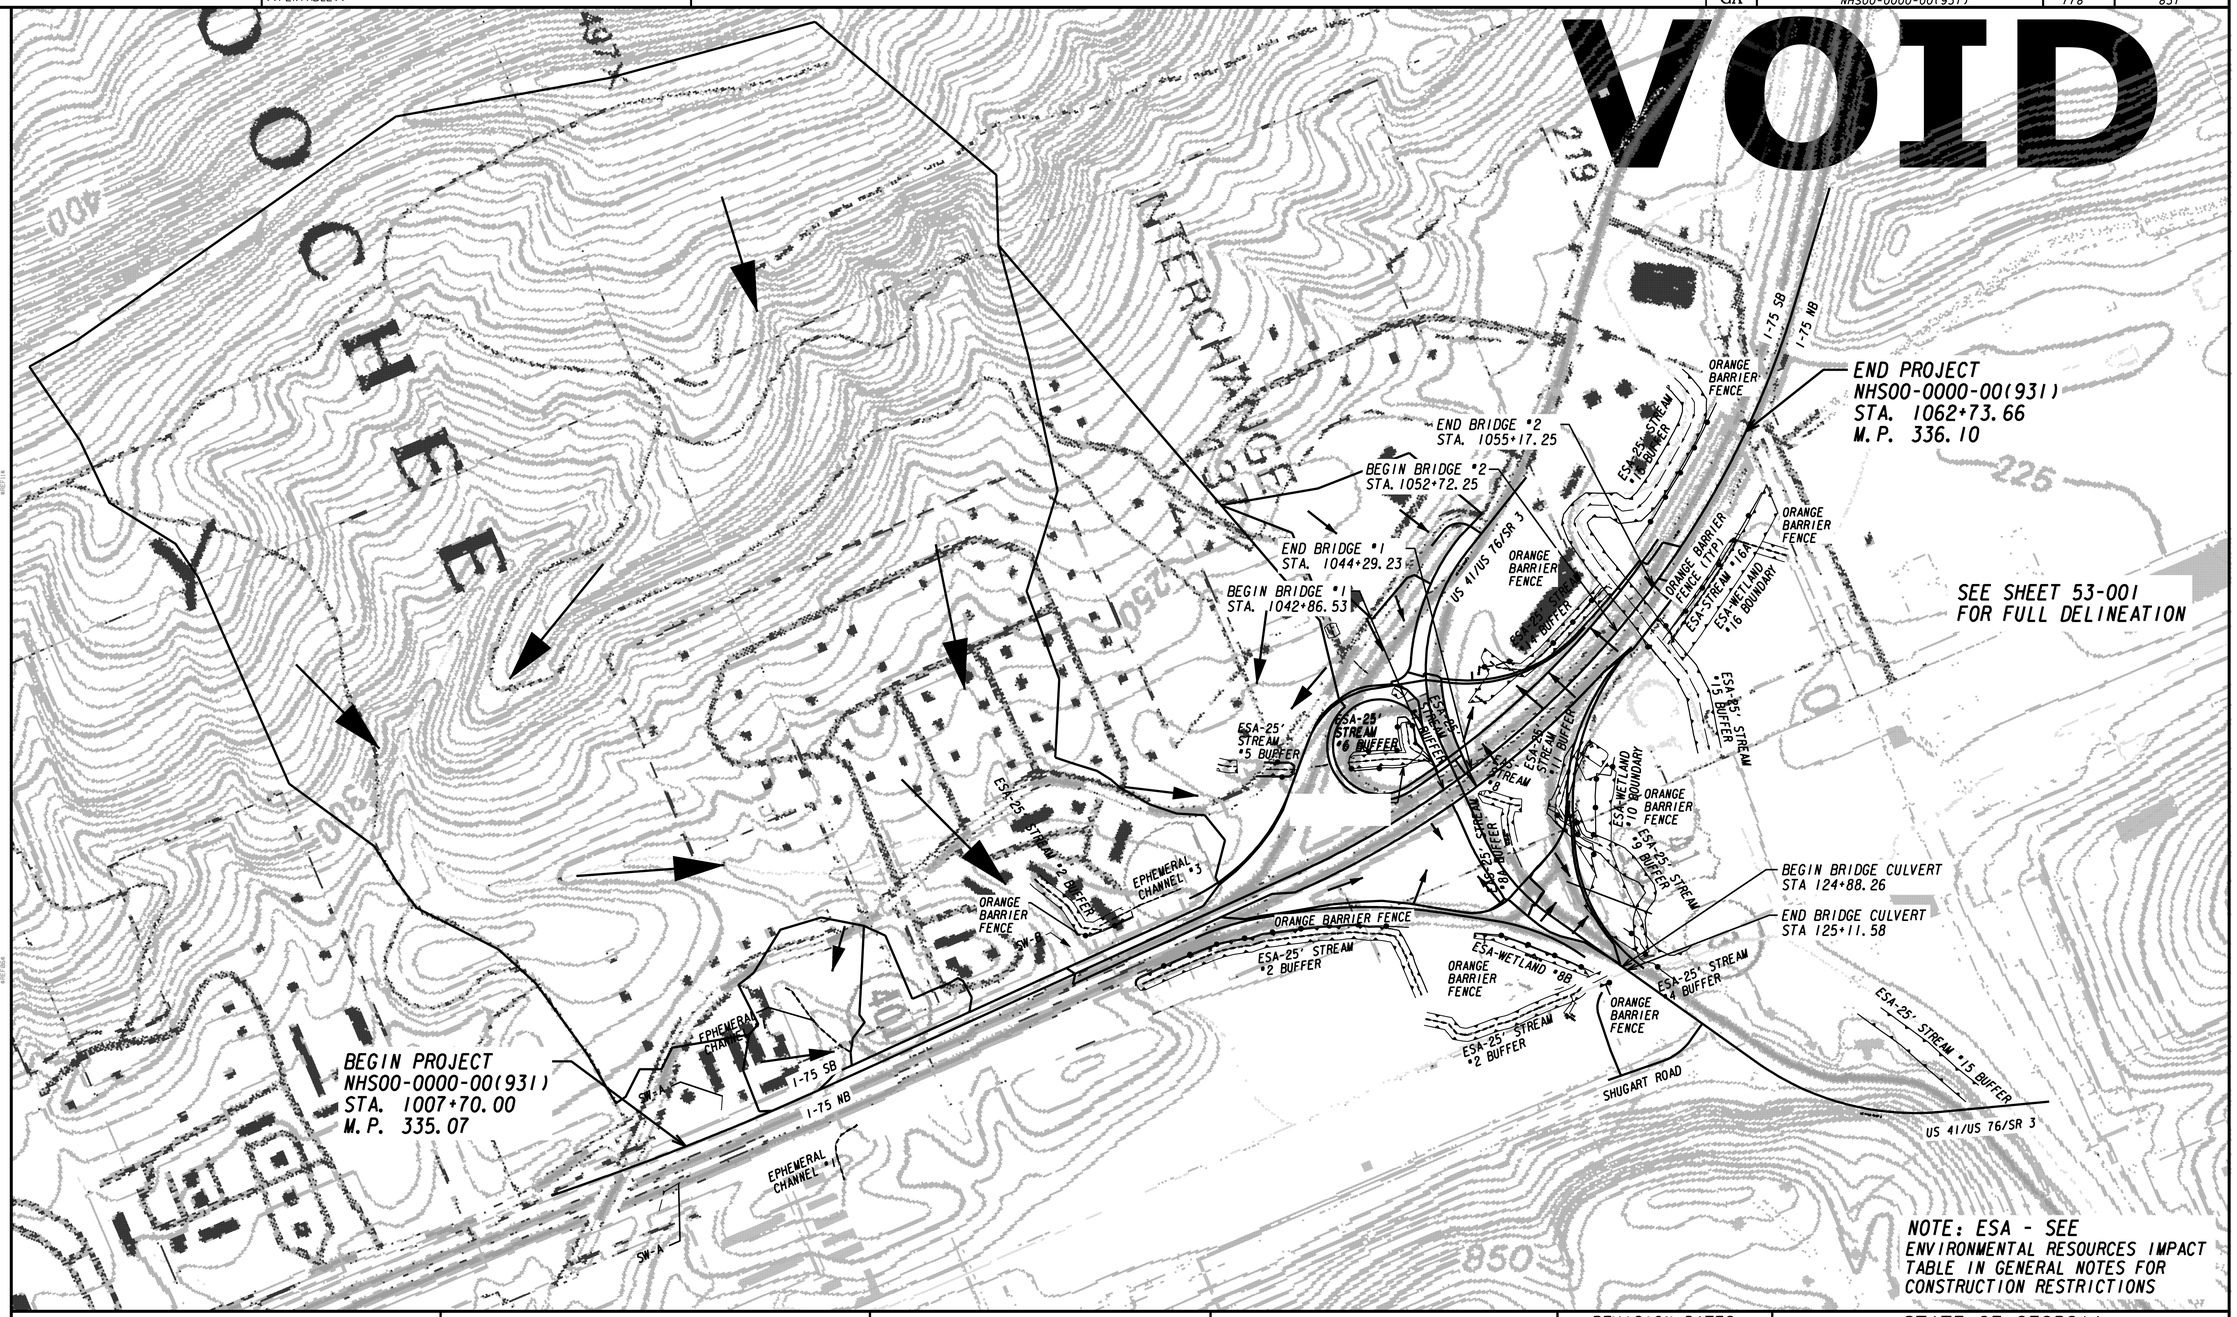

NOTE: ESA - SEE ENVIRONMENTAL RESOURCES IMPACT TABLE IN GENERAL NOTES FOR CONSTRUCTION RESTRICTIONS

Kimley-Horn and Associates, Inc.
Engineering, Planning, and Environmental Consultants
Suite 220, 2 Sun Court
Norcross, Georgia 30092

SCALE IN FEET
0 300 600 1200

REVISION DATES		
12/03/12		

STATE OF GEORGIA
DEPARTMENT OF TRANSPORTATION
OFFICE: PROGRAM DELIVERY

BMP LOCATION DETAILS
I-75 @ US 41 ROCKY FACE

DRAWING No. 53-002

GPLN

...\cadd\000931ED02.dgn 12/3/2012 8:19:26 AM