State	Project Number	Sheet No.	Total Sheets
GA	NHS00-0000-00(931)	—	—

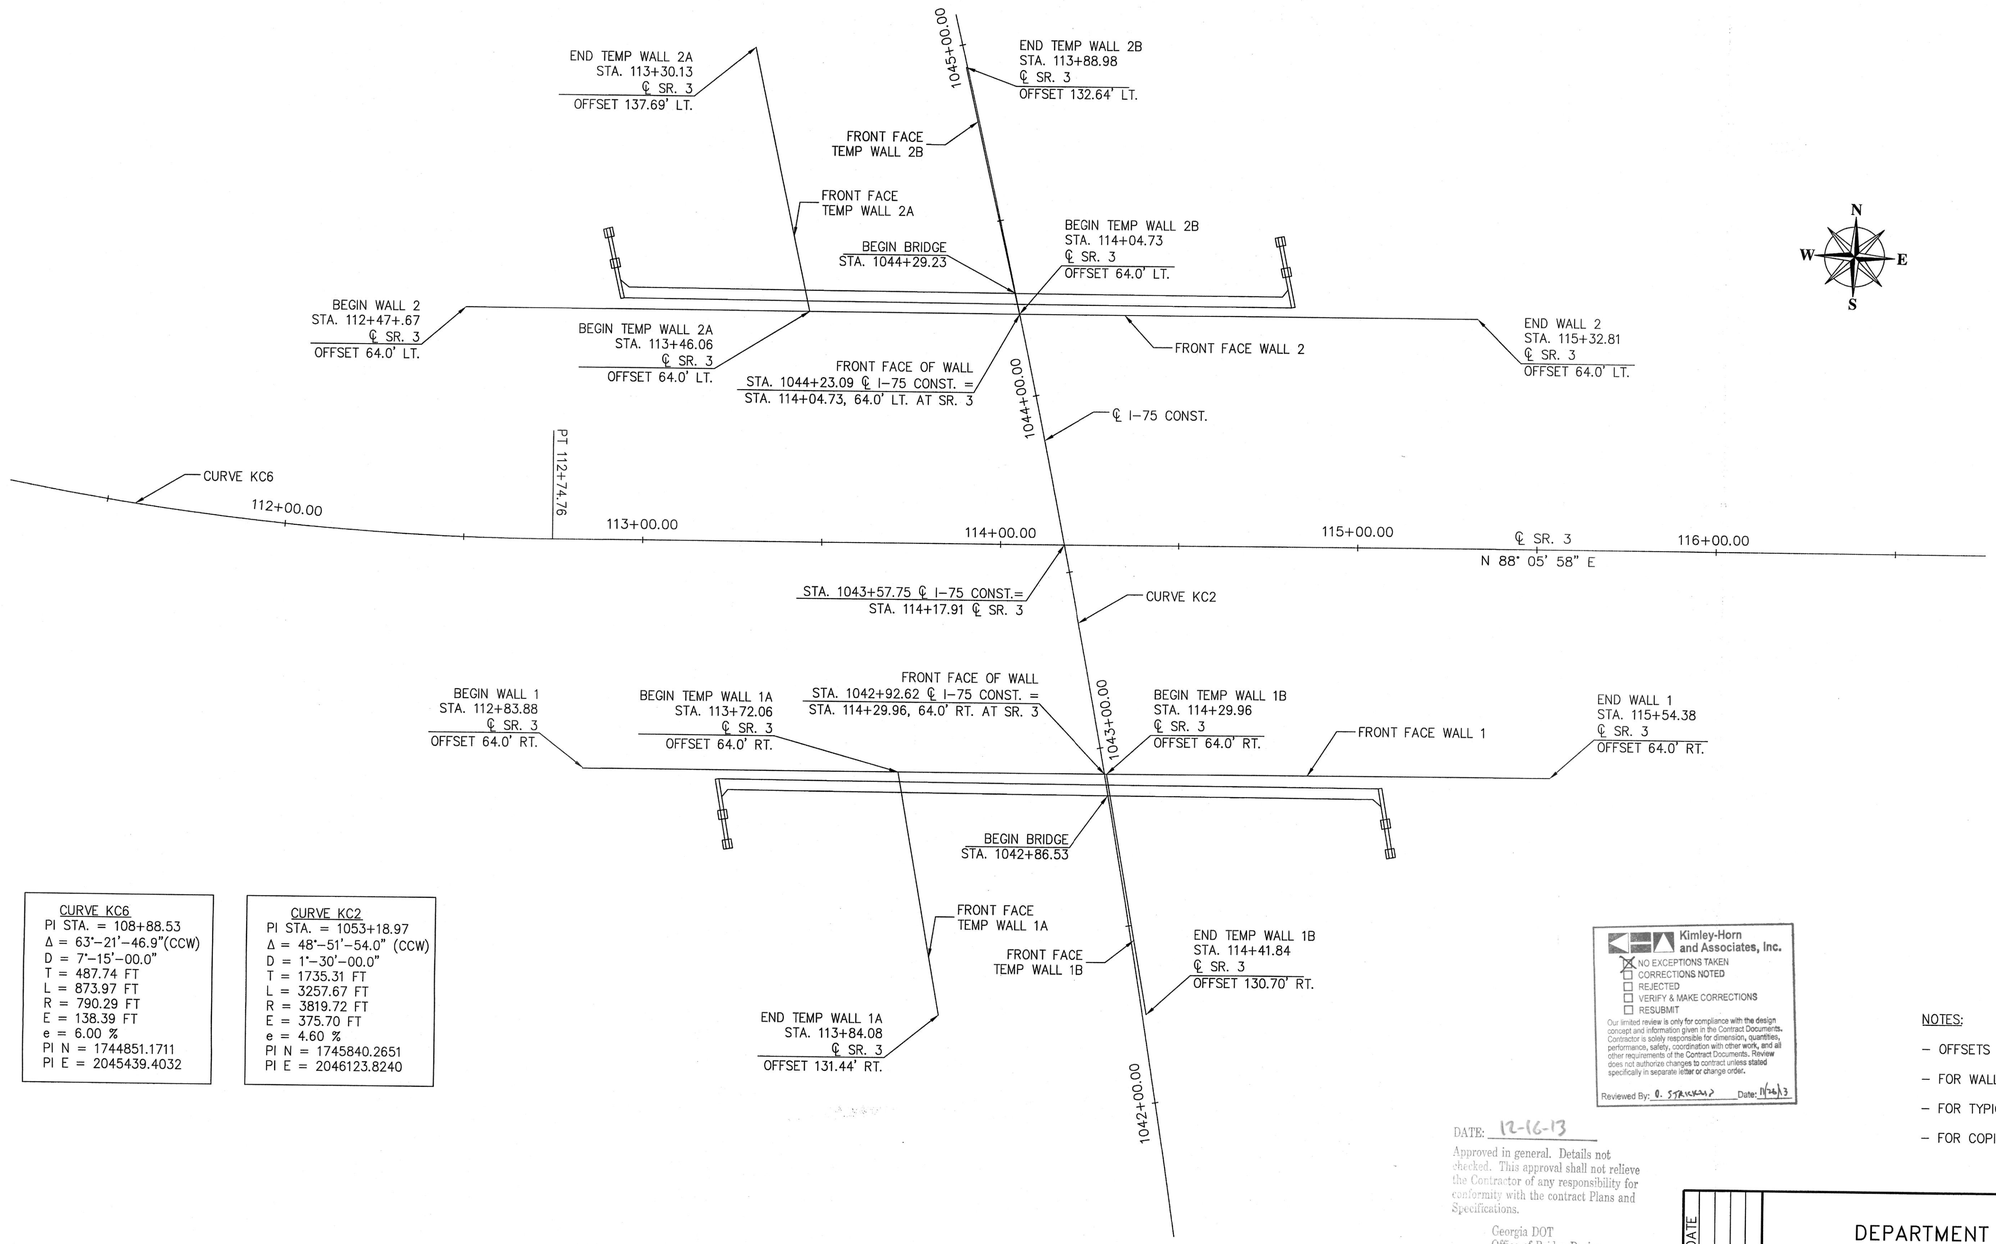

CURVE KC6
PI STA. = 108+88.53
Δ = 63°-21'-46.9"(CCW)
D = 7°-15'-00.0"
T = 487.74 FT
L = 873.97 FT
R = 790.29 FT
E = 138.39 FT
e = 6.00 %
PI N = 1744851.1711
PI E = 2045439.4032

CURVE KC2
PI STA. = 1053+18.97
Δ = 48°-51'-54.0" (CCW)
D = 1°-30'-00.0"
T = 1735.31 FT
L = 3257.67 FT
R = 3819.72 FT
E = 375.70 FT
e = 4.60 %
PI N = 1745840.2651
PI E = 2046123.8240

Kimley-Horn and Associates, Inc.
☒ NO EXCEPTIONS TAKEN
☐ CORRECTIONS NOTED
☐ REJECTED
☐ VERIFY & MAKE CORRECTIONS
☐ RESUBMIT
Our limited review is only for compliance with the design concept and information given in the Contract Documents. Contractor is solely responsible for dimension, quantities, performance, safety, coordination with other work, and all other requirements of the Contract Documents. Review does not authorize changes to contract unless stated specifically in separate letter or change order.
Reviewed By: O. Sprayberry Date: 11/26/13

DATE: 12-16-13
Approved in general. Details not checked. This approval shall not relieve the Contractor of any responsibility for conformity with the contract Plans and Specifications.
Georgia DOT
Office of Bridge Design
By: CR

NOTES:

- OFFSETS ARE TO FRONT FACE OF WALL.
- FOR WALL ELEVATIONS, SEE SHT. 3 & 4.
- FOR TYPICAL SECTION, SEE SHT. 9.
- FOR COPING DETAILS, SEE SHT. 10.

WALLS 1 & 2 PLAN VIEW

SCALE : 1" = 20'

This drawing contains information proprietary to The Reinforced Earth Company, and is being furnished for the use of THE GEORIGA DEPT. OF TRANSPORTATION only in connection with this project, and the information contained is not to be transmitted to any other organization unless specifically authorized in writing by The Reinforced Earth Company. The Reinforced Earth Company is exclusive licensee in the United States under patents issued to Henri Vidal, and the furnishing of this drawing does not constitute an expressed or implied license under the Vidal patents.

FINAL FOR REVIEW
OCTOBER 14, 2013

PROJECT STATUS

REINFORCED EARTH®
SUSTAINABLE TECHNOLOGY
25 Technology Parkway South, Suite 100, Norcross, GA 30092, (770) 242-9415

"REINFORCED EARTH" is the registered trademark of The Reinforced Earth Company.

GEORGIA REGISTERED No. 18102 PROFESSIONAL ENGINEER

WALL SHEET
OF

REVISIONS	BY	DATE

GEORGIA
DEPARTMENT OF TRANSPORTATION
HIGHWAY DIVISION – BRIDGE DESIGN

I-75 @ SR3/US 41/76 INTERCHANGE RECONSTRUCTION
WHITFIELD COUNTY

REINFORCED EARTH RETAINING WALL

WALLS 1 & 2 PLAN VIEW

DESIGNED SLM
DRAWN SLM
TRACED
CHECKED CCJ
REVIEWED
APPROVED JDS

Z:\GEORGIA\16318 – I-75 & US 76 INTERCHANGE – SQR – E\PACKAGE 1 – WALLS 1 & 2\16318 – 02, WALLS 1&2 PLAN VEW (R1).DWG