COUNTY	PROJECT NUMBER	SHEET NO.	TOTAL SHEETS
COLQUITT	BR000-0001-00(358)	160	167

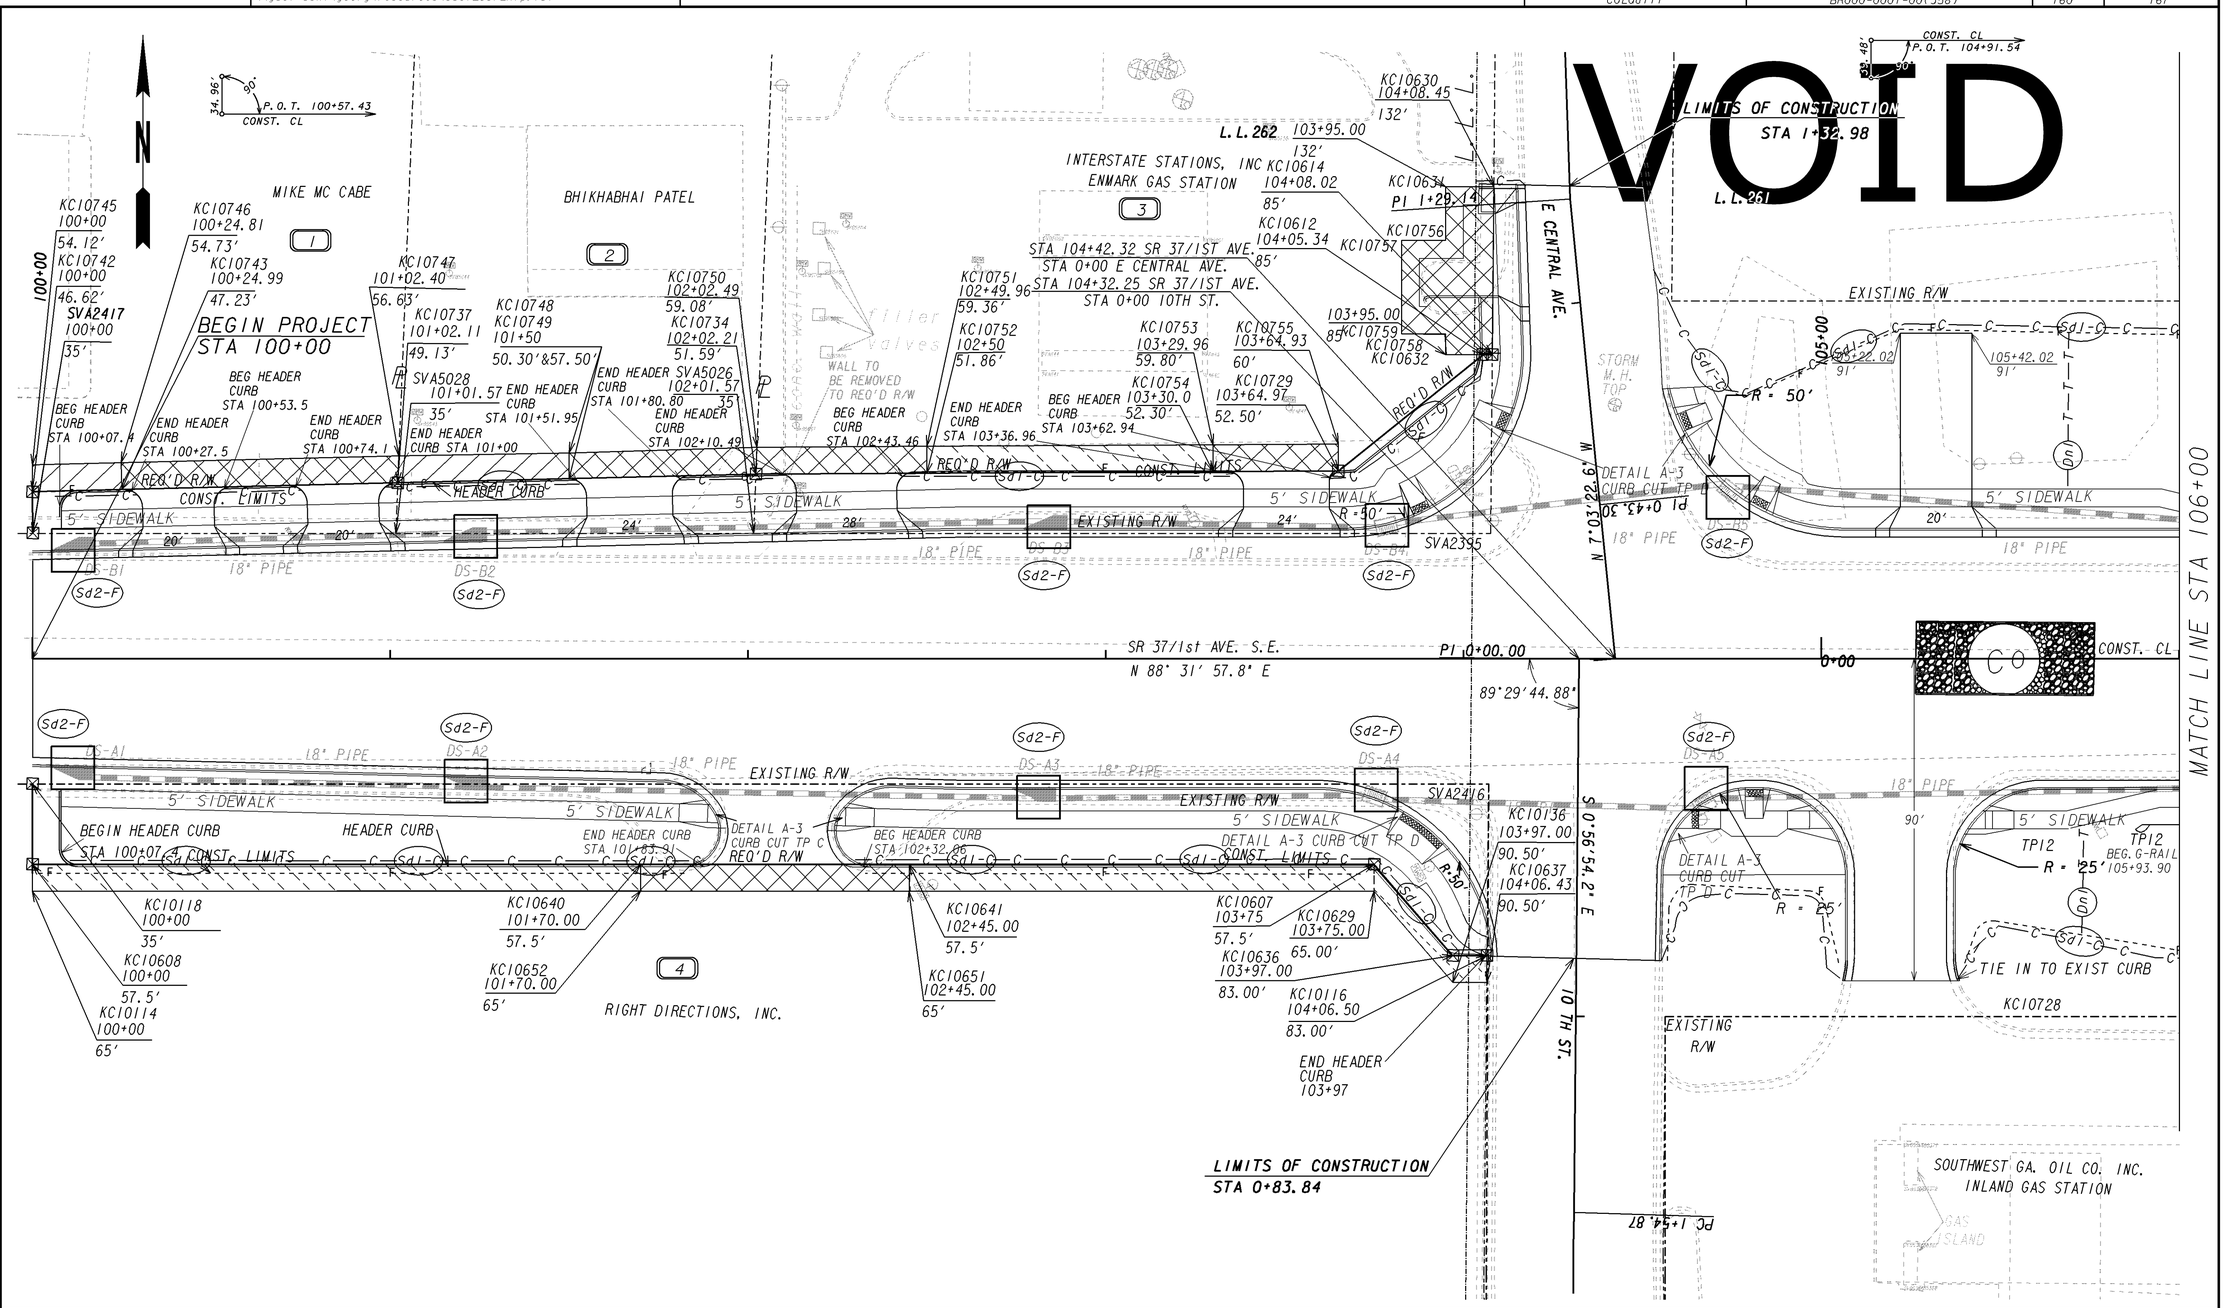

Contamination from USTs was not encountered within the required right-of-way at Site Nos. 2, 3, and 4. Since contamination was not encountered, it appears that right-of-way acquisition at these sites may proceed. the USTs do not appear to be within the required right-of-way at Site Nos. 2 and 3. The location of the USTs at site No. 4 could not be determined at this time. If USTs are encountered by the Department's construction personnel at Site No. 4 during project implementation, they shall be handled in accordance with GDOT Standard Specifications for Construction, Section 217 - Removal of Underground storage tanks

SCALE IN FEET
0 20 40 80

STAGE 2 NOTES
1. INSTALL EROSION CONTROL MATTING AFTER GRADING ACTIVITIES HAVE BEEN COMPLETED

REVISION DATES

STATE OF GEORGIA
DEPARTMENT OF TRANSPORTATION

OFFICE:

EROSION CONTROL PLAN
STAGE 2

DRAWING NO. 54-004