STATE	PROJECT NUMBER	SHEET NO.	TOTAL SHEETS
GA.	BR000-0001-00(358)	62B	

⊛ ℄ 1" EXP. JT. IN PARAPET, TYP.

⊛⊛ ℄ REQ'D CONST. JT. IN SLAB, SIDEWALK AND 1" EXP. JT. IN PARAPET, TYP.

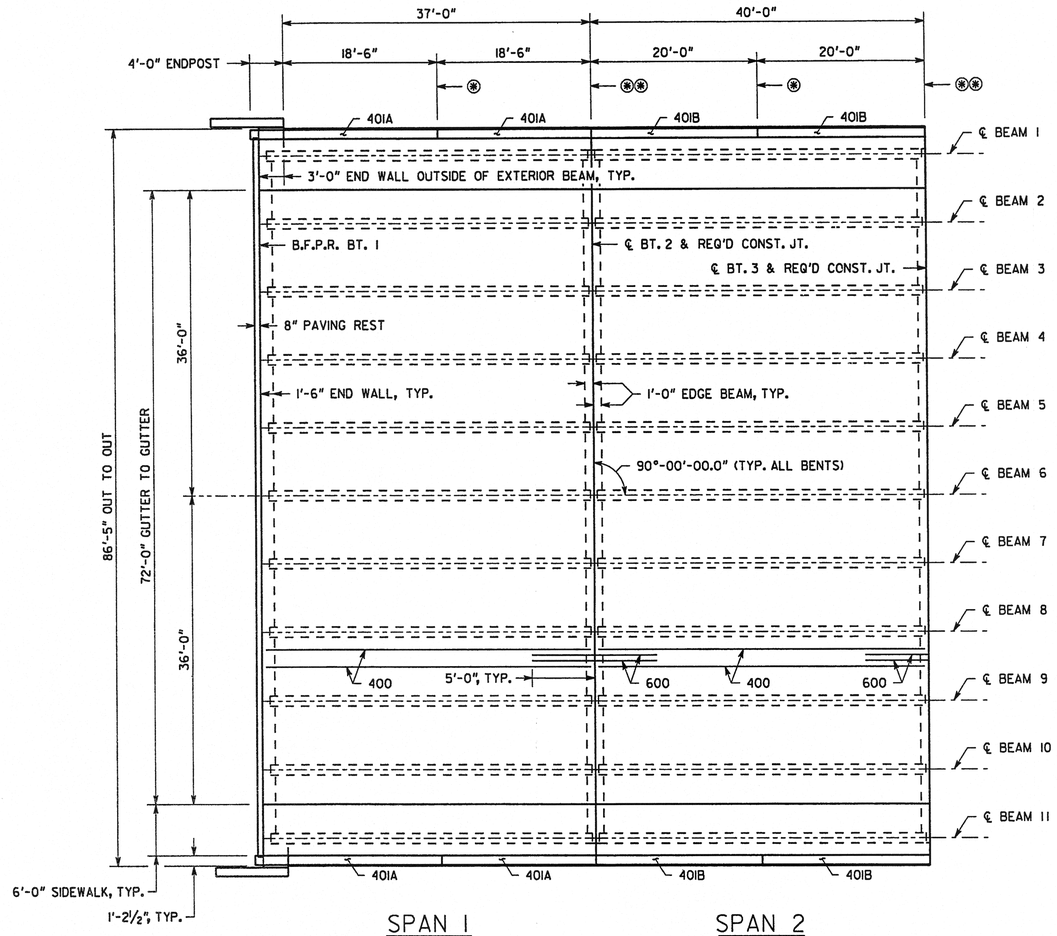

SPAN 1

SPAN 6 SIMILAR

SPAN 2

SPAN 3-5 SIMILAR

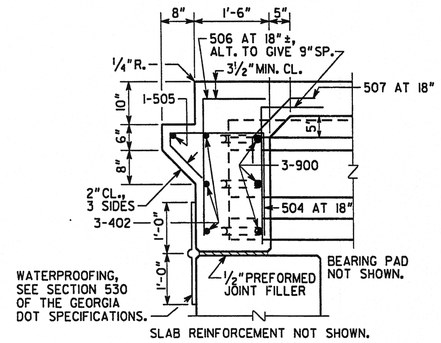

SECTION AT ENDWALL

BENTS 1 & 7

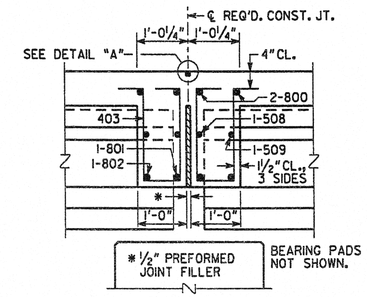

SLAB REINFORCEMENT NOT SHOWN.

SECTION THRU EDGE BEAM

BENTS 2-6

PLACE TRANSVERSE SIDEWALK MARKINGS ON SIDEWALK SPACED AT 5'-0"±.

COST OF BOND BREAKER AND EPOXY ADHESIVE TO BE INCLUDED IN PRICE BID FOR SUPERSTRUCTURE ITEMS.

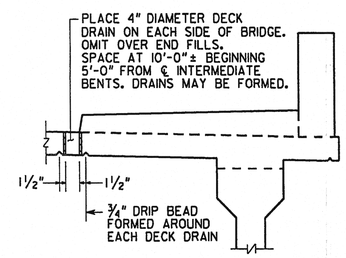

DECK DRAIN DETAIL

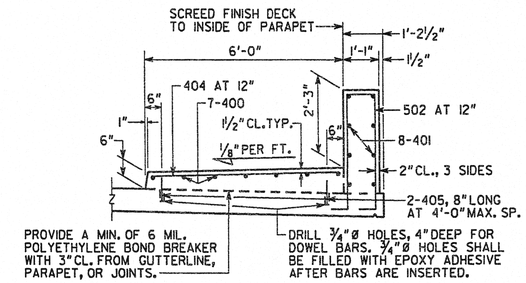

SIDEWALK AND PARAPET DETAILS

DATE: AUG 29 2011

Approved in general. Details not checked. This approval shall not relieve the Contractor of any responsibility for conformity with the contract Plans and Specifications.

Georgia DOT
Office of Bridge Design
By: SKG

SUPERSTRUCTURE GENERAL NOTES

1. SUPERSTRUCTURE CONCRETE - CLASS AA, f'_c = 3500 PSI
2. REINFORCEMENT STEEL - GRADE 60, f_y = 60,000 PSI
3. CHAMFER ALL EXPOSED CONCRETE EDGES ¾" UNLESS OTHERWISE NOTED.
4. FOR DETAILS NOT SHOWN, SEE THE CONTRACT DRAWINGS.
5. BRACING SHALL BE PROVIDED BETWEEN THE EXISTING BEAM AND THE FIRST INTERIOR BEAM UNTIL THE DECK HAS BEEN CAST AND THE OVERHANG FORMS REMOVED.
6. ALUMINUM HANDRAIL POST SPACING DOES NOT CHANGE. SEE THE EXISTING PLANS FOR DETAILS AND POST SPACING.

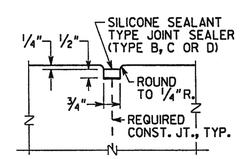

DETAIL "A"

BRIDGE NO. 1

SOUTHERN CONCRETE CONSTRUCTION CO., INC.
P. O. BOX 711
ALBANY, GA 31702
TEL: (229) 435-0786
FAX: (229) 434-4755

DECK PLAN

SR 37 (1ST AVENUE) OVER OKAPILCO CREEK

COLQUITT COUNTY BR000-0001-00(358)

SCC JOB NO. 201132 JULY 2011

DATE	REVISIONS	BY

DESIGNED GDOT / BHB		SCALE NO SCALE	
DRAWN BHB		CHECKED BHB	

BRIDGE SHEET 1B OF 11

SHEET 2 OF 9

C20132.DGN